


EVERGREEN AT ROCKWALL

SANITARY SEWER PROFILE

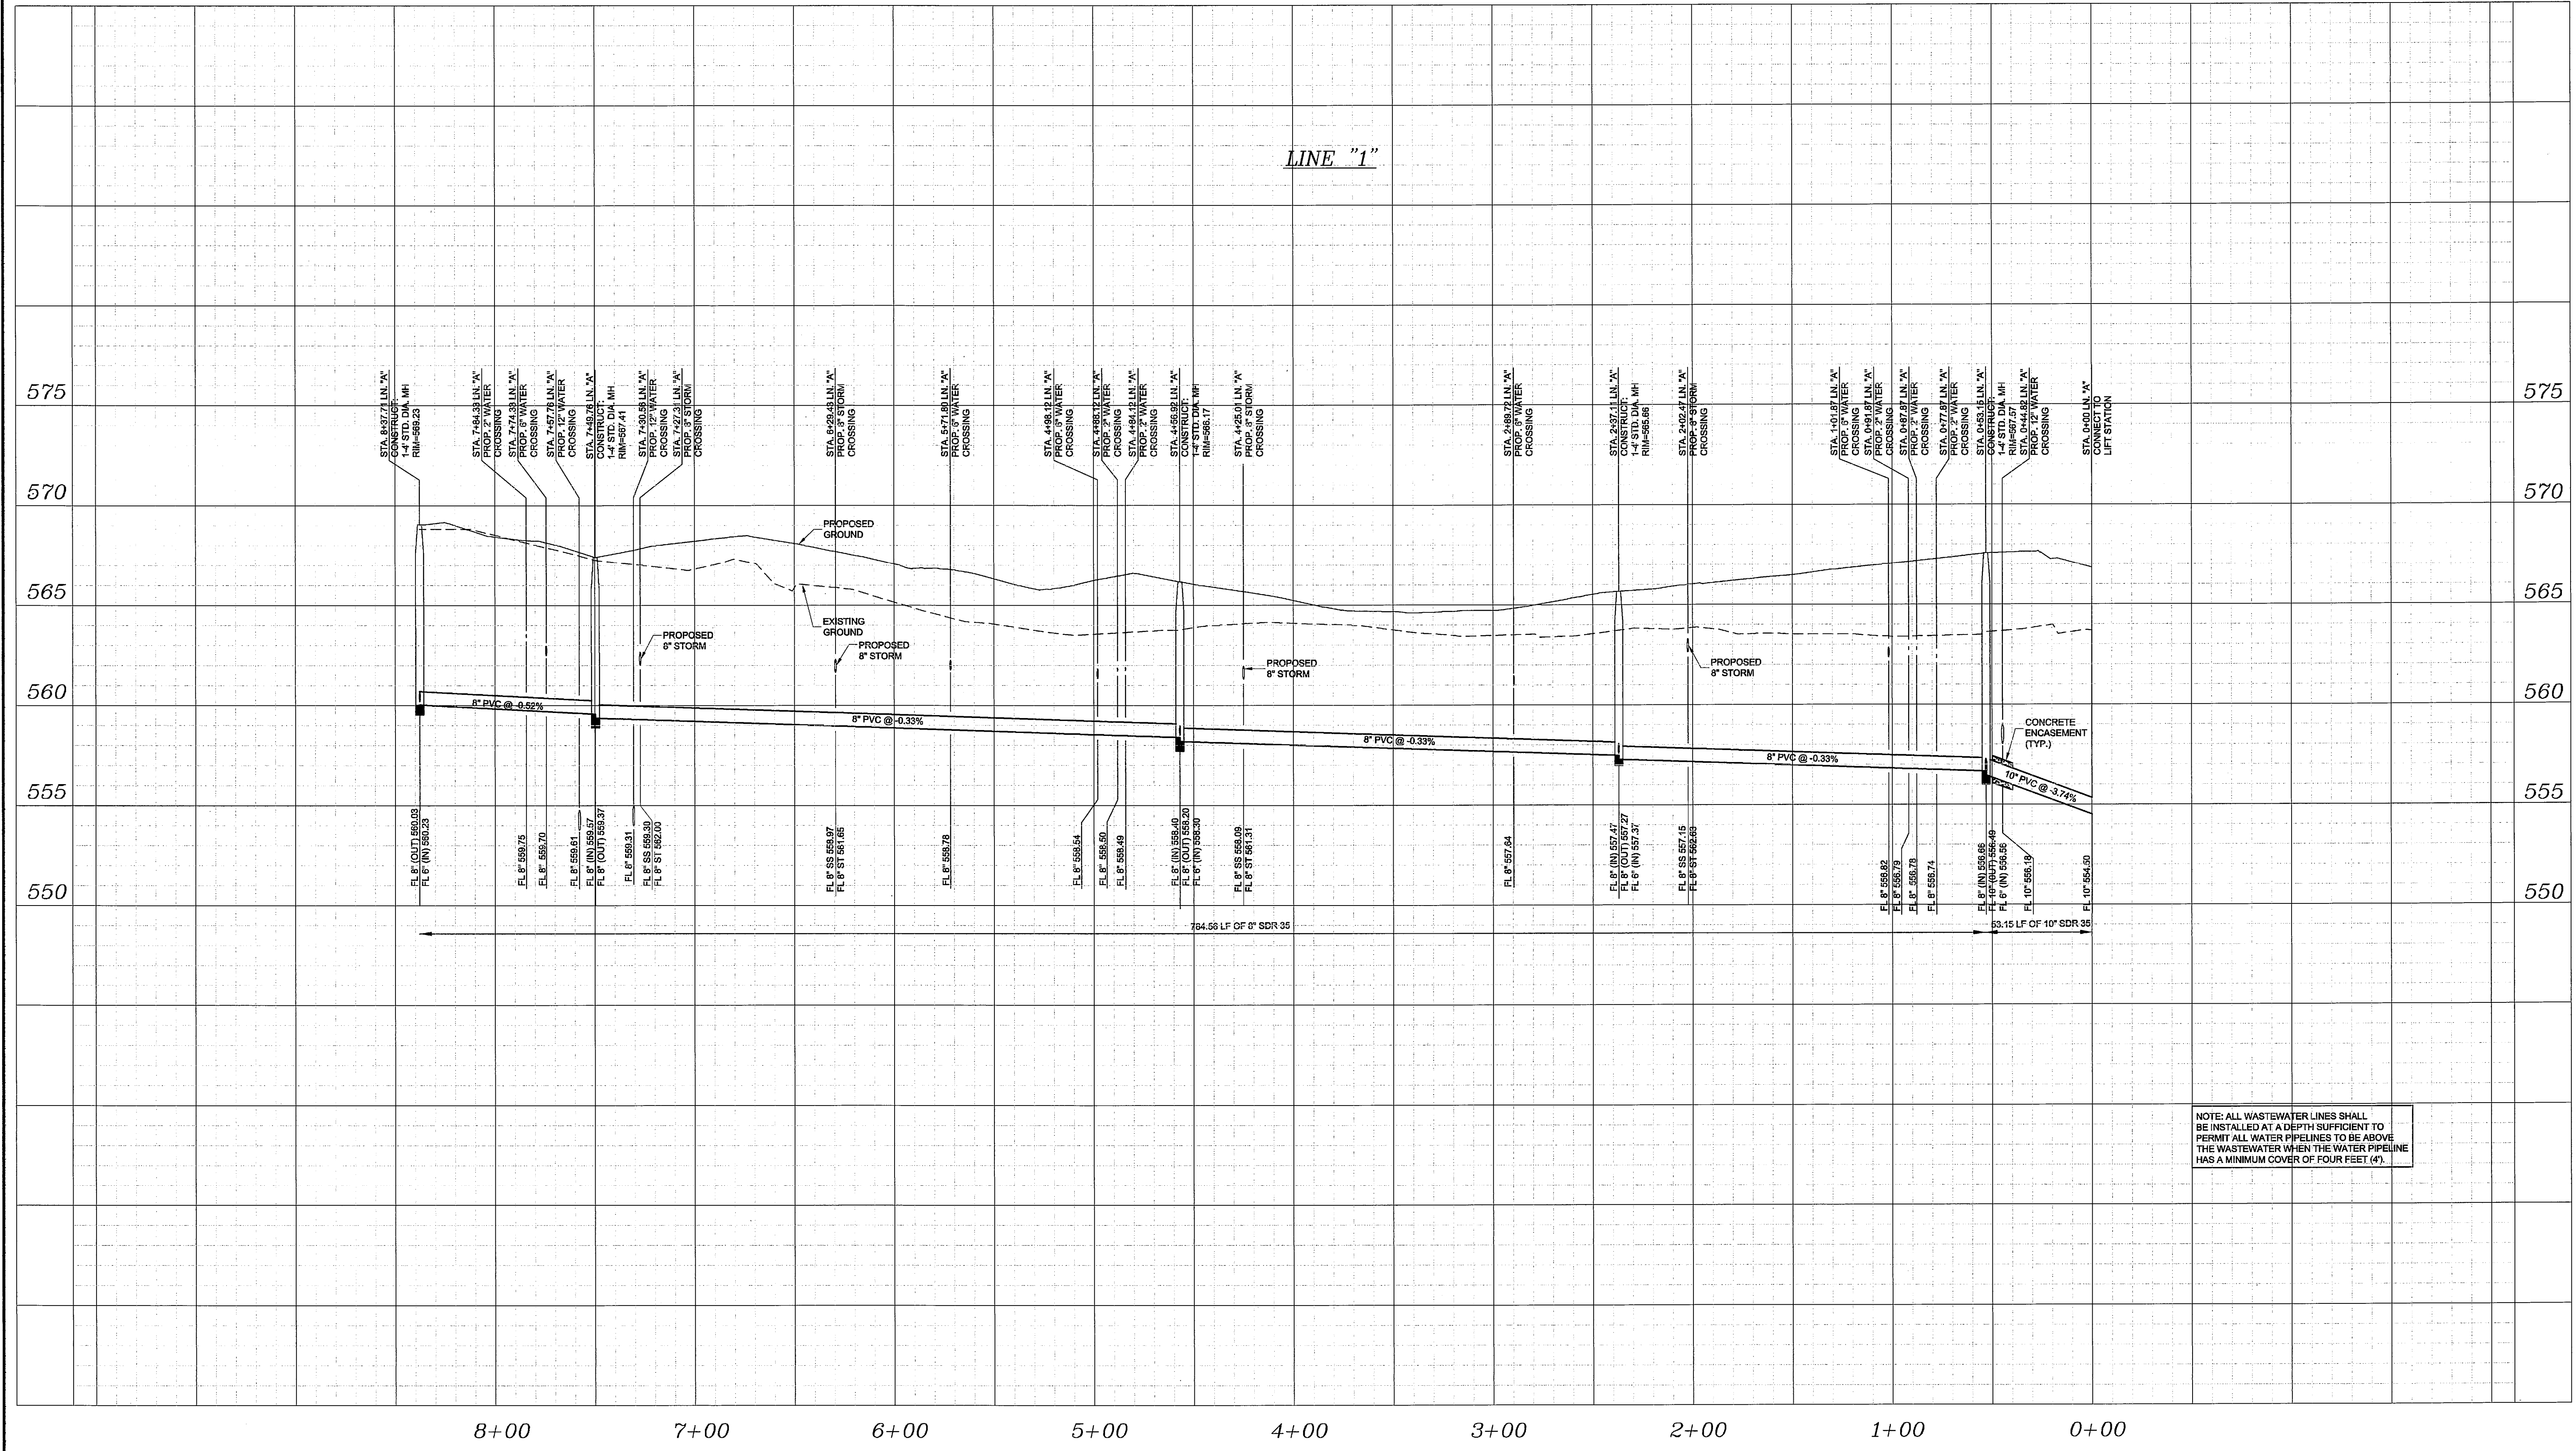

NOTE: ALL WASTEWATER LINES SHALL BE INSTALLED AT A DEPTH SUFFICIENT TO PERMIT ALL WATER PIPELINES TO BE ABOVE THE WASTEWATER WHEN THE WATER PIPELINE HAS A MINIMUM COVER OF FOUR FEET (4').

RECORD DRAWING
 THIS RECORD DRAWING HEREIN REFLECTS TO THE BEST OF THE DESIGN ENGINEERS KNOWLEDGE, THE APPROXIMATE LOCATION OF THE CONSTRUCTED WORK, USING INFORMATION AS PROVIDED BY THE CONTRACTORS AND SURVEYED GRADES.

Scale:	AS SHOWN
Designed by:	KHA
Drawn by:	KHA
Checked by:	KHA
Date:	DECEMBER 2006
Project No.:	063890013

SHEET
C-23

Small text at the bottom right corner, likely a revision or drawing code.