


**EVERGREEN  
AT ROCKWALL**

**LEFT TURN  
LANE PLAN**



Scale:	AS SHOWN
Designed by:	KHA
Drawn by:	KHA
Checked by:	KHA
Date:	DECEMBER 2006
Project No.:	063890013

SHEET  
**C-26**

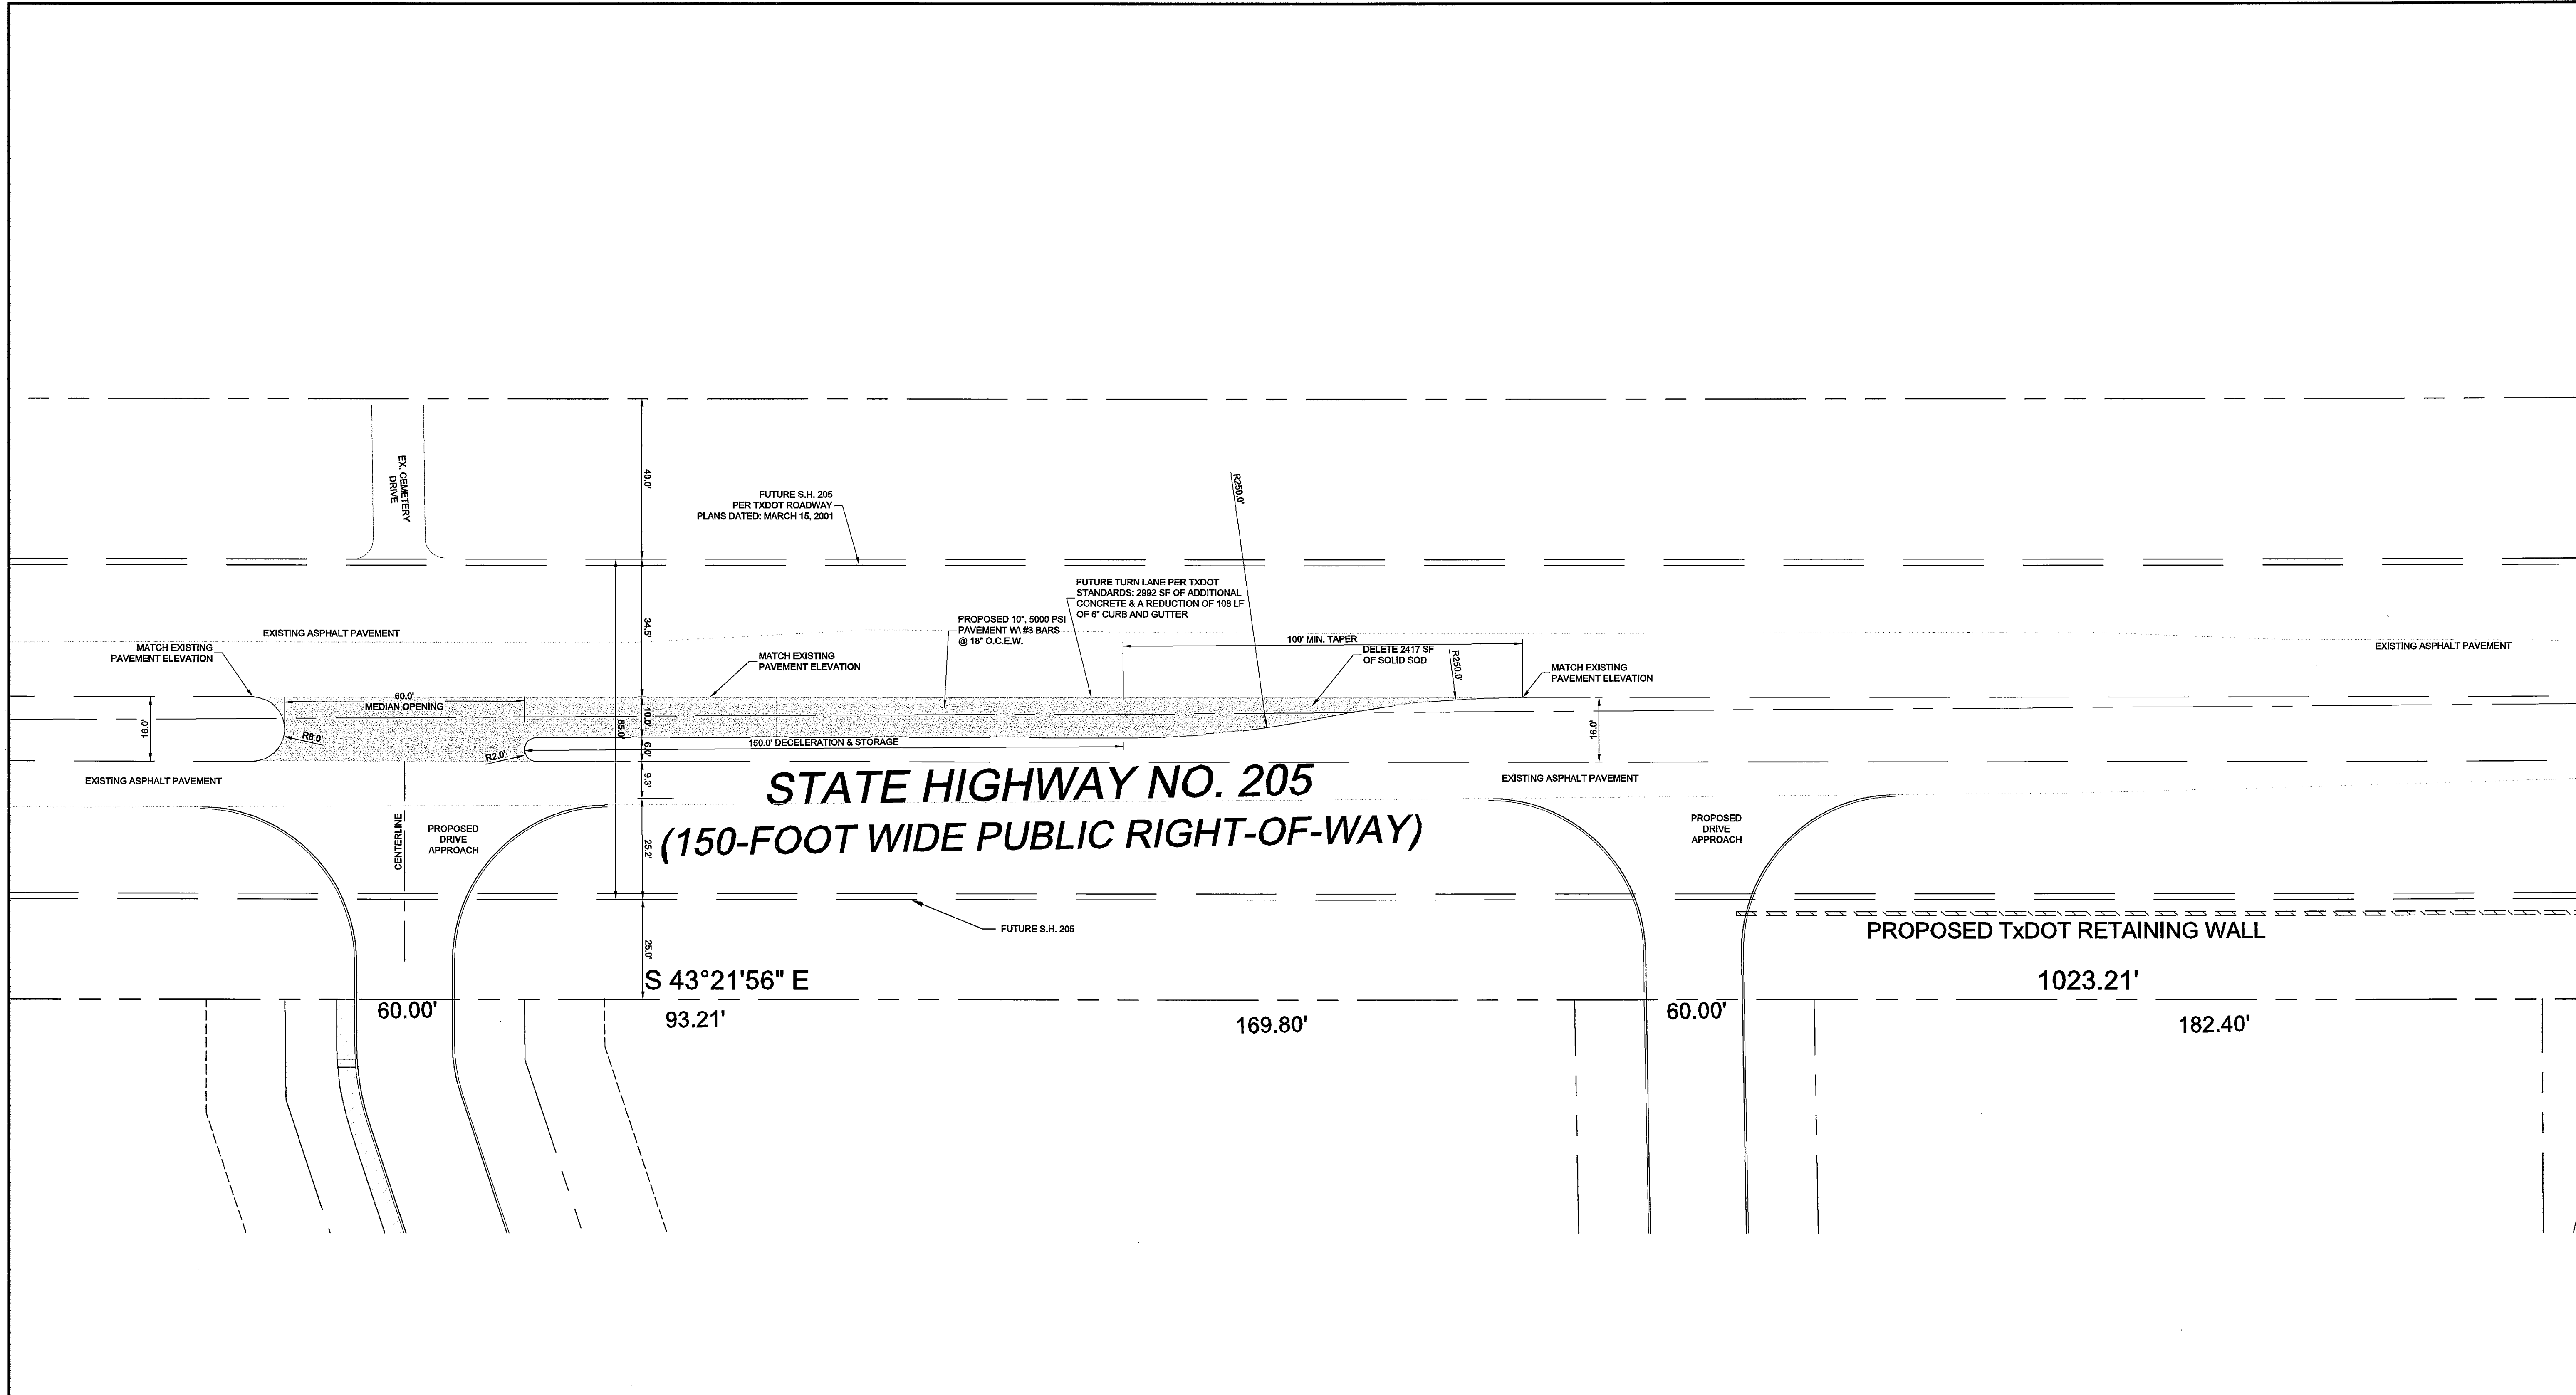

**STATE HIGHWAY NO. 205  
(150-FOOT WIDE PUBLIC RIGHT-OF-WAY)**

S 43°21'56" E

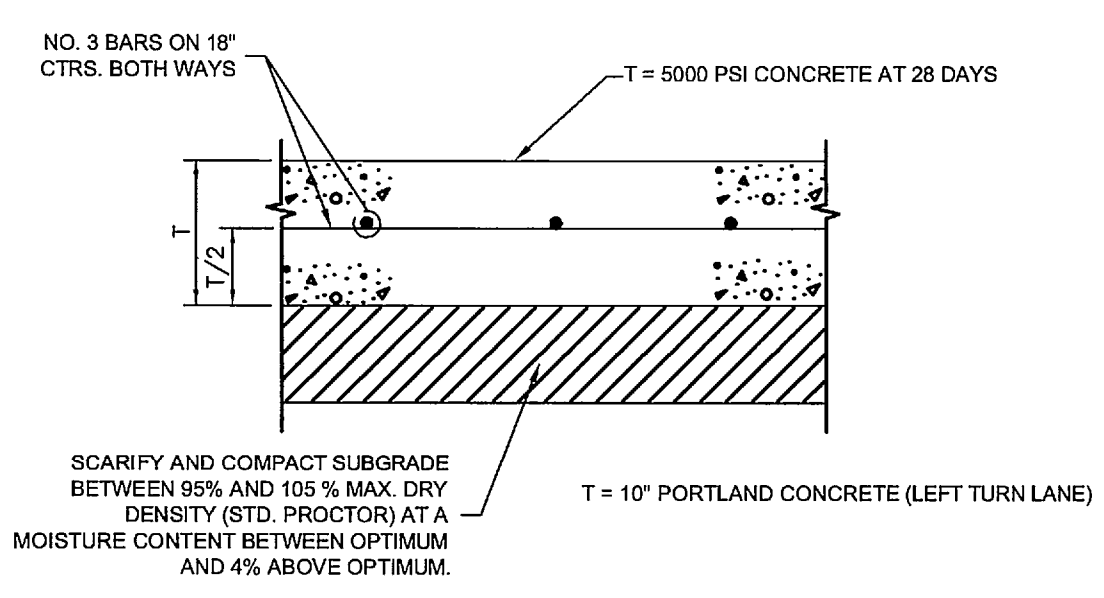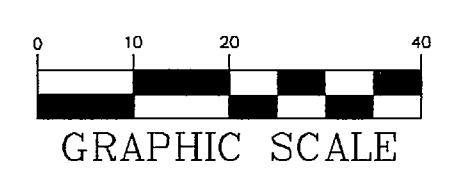

PAVEMENT SECTION  
N.T.S.

**RECORD DRAWING**  
THIS RECORD DRAWING HEREIN REFLECTS TO THE BEST OF THE DESIGN ENGINEER'S KNOWLEDGE, THE APPROXIMATE LOCATION OF THE CONSTRUCTED WORK, USING INFORMATION AS PROVIDED BY THE CONTRACTORS AND SURVEYED GRADES.

DATE PLOTTED: 12/27/06 10:23 AM  
PLOT FILE: \\P01\proj\06\063890013\063890013.dwg - C-26  
PLOTTER: HP DesignJet 2400 Series