

MATCHLINE STA 9+50

MATCHLINE STA 14+50

CONSTRUCT 4" HDPE
(C906-DR11/DIPS) SS FORCE MAIN

TOWNSEND BLVD
(85' R.O.W.)

LEGEND	
SYM.	DESCRIPTION
— W —	EXISTING WATER LINE
— SS —	EXISTING SS LINE
- - -	R.O.W. LINE
- GAS -	EXISTING UNDERGROUND GAS
- UGT -	EXISTING UNDERGROUND TELEPHONE
- - -	EXISTING STORM SEWER
- - -	PROPOSED EASEMENT
	ABANDONED WATER LINE
- - -	SIDEWALK



BENCHMARKS:

"□" CUT IN THE EAST END OF HEAD-WALL LOCATED ON THE NORTHWEST CORNER OF THE INTERSECTION OF BOYDSTUN STREET AND CLARK STREET. ELEVATION 534.21

"□" CUT IN THE SOUTHWEST CORNER OF THE HEADWALL LOCATED ON THE WEST SIDE OF INDUSTRIAL BLVD, APPROXIMATELY 250± FEET NORTH OF THE INTERSECTION OF INDUSTRIAL AND THE I-30 ACCESS ROAD. ELEVATION 544.77

STOP!
CALL BEFORE YOU DIG
DIG TESS
1-800-DIG-TESS
(@ least 72 hours prior to digging)

NOTES:
1. MINIMUM 3' COVER ON SS LINES

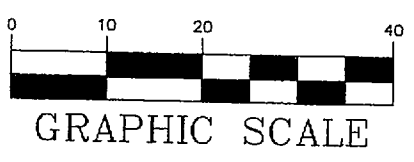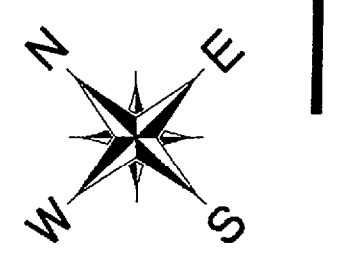

LOT 1A-R, BLOCK A
LOFLAND INDUSTRIAL PARK ADDITION
CAB. E, PAGE 138
P.R.R.C.T.

STA. 9+60
END 4" BORE
N 7024273.17
E 2597205.17

STA. 10+65.00
BEGIN 4" BORE
N 7024197.33
E 2597277.79

STA. 11+15.00
END 4" BORE
N 7024161.22
E 2597312.37


GAS TEST STA.
STA. 11+57.44
INSTALL:
(1) 45° HORIZ BEND RT
Δ=45.13°
N 7024138.79
E 2597345.35

15' UTILITY EASEMENT
VOL. 84, PG. 243
D.R.R.C.T.

BILL R. CAMERON AND
RAYMOND B. CAMERON
VOLUME 101, PAGE 837
D.R.R.C.T.


CAUTION! GAS
IN THIS AREA

CAUTION!
UNDERGROUND TELEPHONE
IN THIS AREA

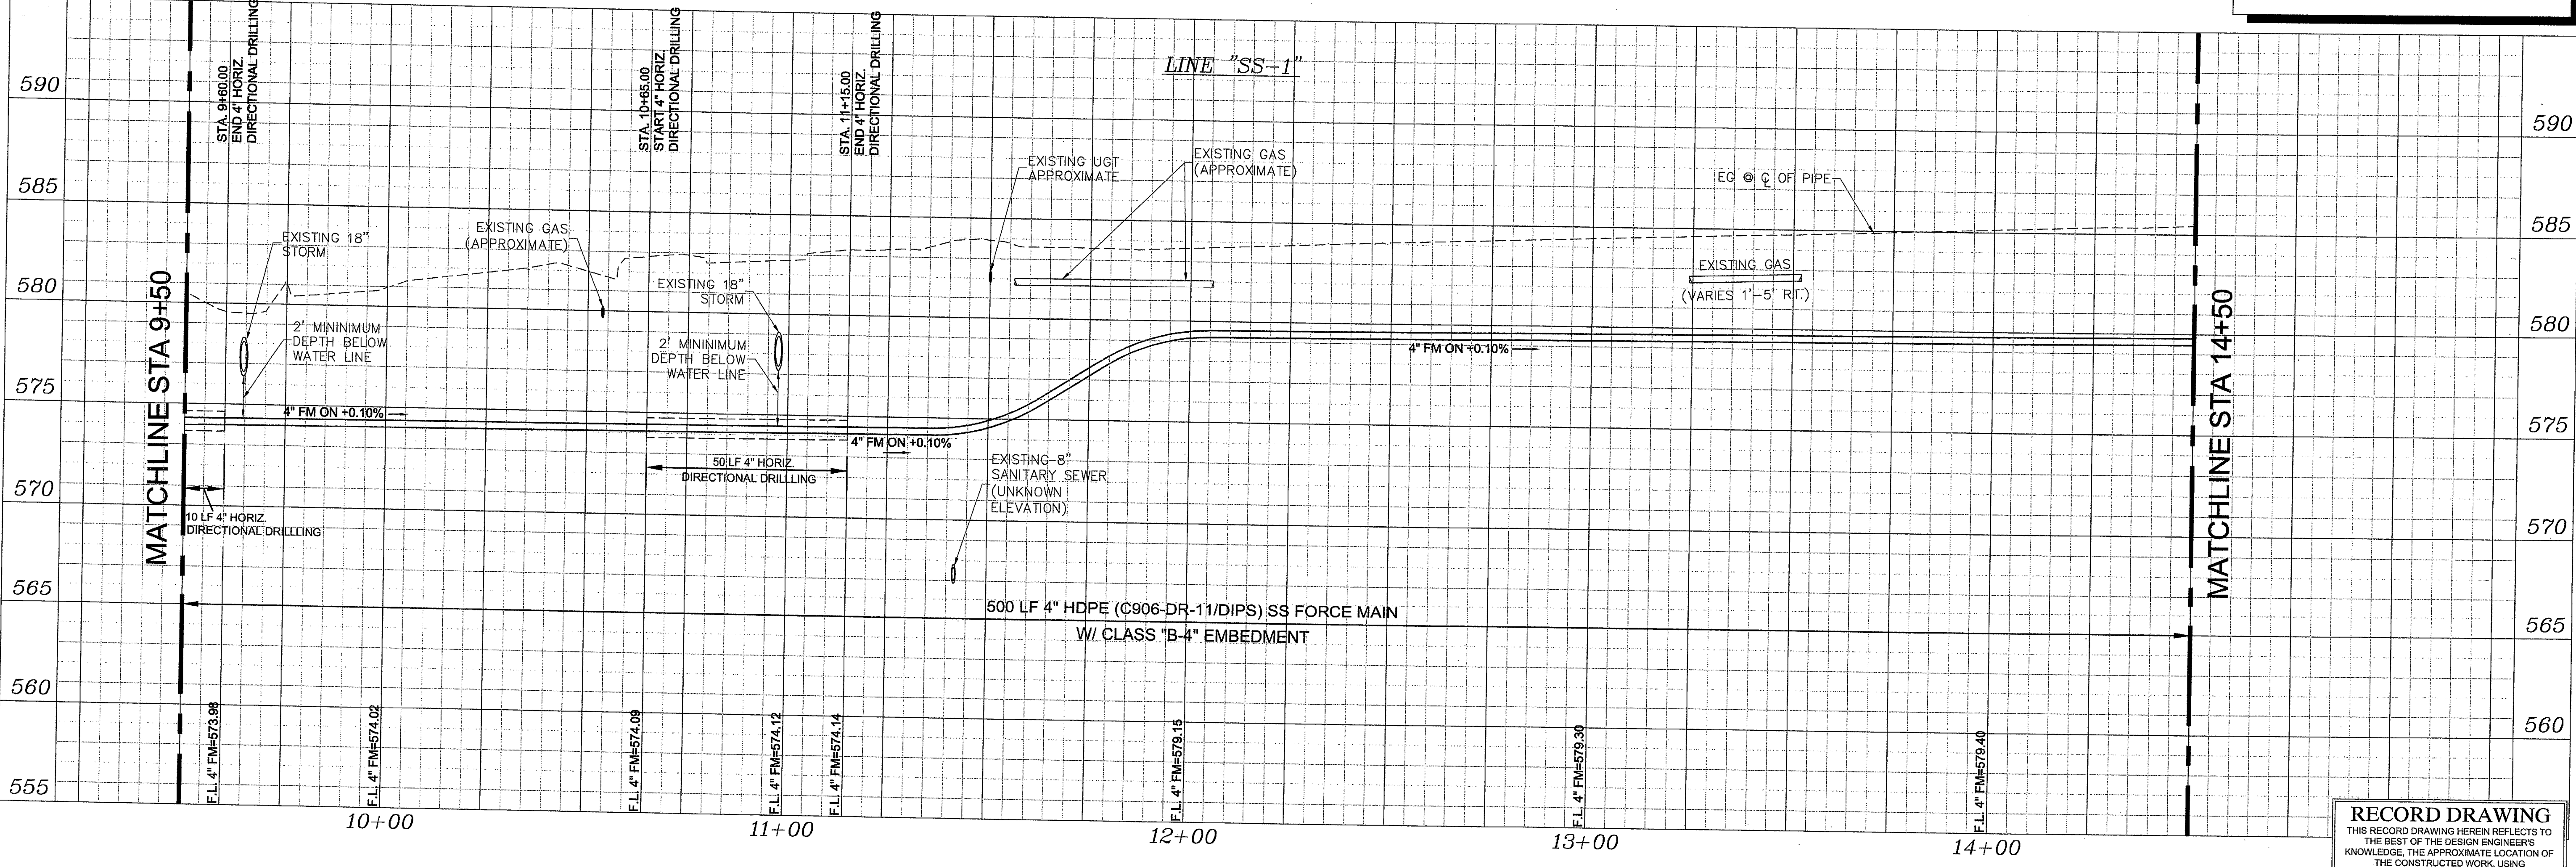

RECORD DRAWING
THIS RECORD DRAWING HEREIN REFLECTS TO THE BEST OF THE DESIGN ENGINEER'S KNOWLEDGE, THE APPROXIMATE LOCATION OF THE CONSTRUCTED WORK USING INFORMATION AS PROVIDED BY THE CONTRACTORS AND SURVEYED GRADES.

**Kimley-Horn
and Associates, Inc.**
Tel. No. (972) 770-1900
Fax No. (972) 259-3620

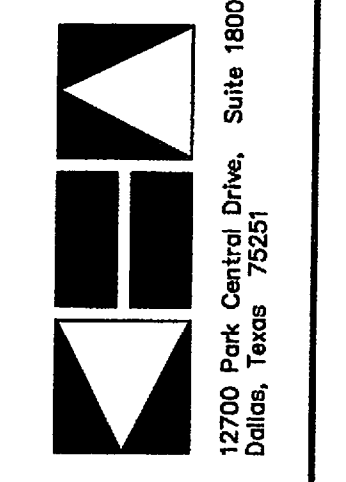

**EVERGREEN
AT ROCKWALL**

**OFFSITE FORCE MAIN
PLAN & PROFILE**

Scale: AS SHOWN
Designed by: KHA
Drawn by: KHA
Checked by: KHA
Date: MAY 2008
Project No. 063890013

SHEET
C-34

DATE PLOTTED: 5/27/08 8:26am
PLOTTER: HP DesignJet 2430
C:\p063890013\080527\080527.dwg
PLOT SCALE: 1"=40'-0"