



1	01/03/07	ALIGNMENT AND PROFILE REVISION STA. 24+50 TO STA. 29+50	C-35-37
2	01/03/07	REVISED PLAN STA. FOR AIR RELEASE VALVE	C-33, C-35
No.	Date	Revisions	App.

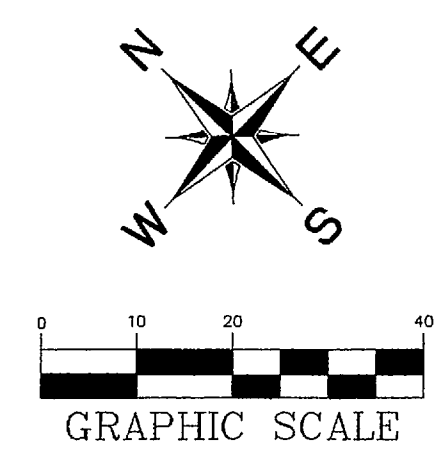

Kimley-Horn and Associates, Inc.
 12700 Park Central Drive, Suite 1800
 Dallas, Texas 75251
 Tel. No. (972) 770-1300
 Fax No. (972) 239-5820


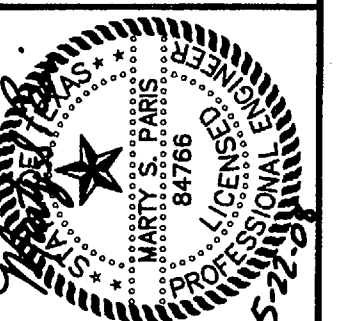


EVERGREEN AT ROCKWALL

OFFSITE FORCE MAIN PLAN & PROFILE

Scale: AS SHOWN
 Designed by: RHA
 Drawn by: RHA
 Checked by: RHA
 Date: MAY 2008
 Project No. 06390003

SHEET
C-37

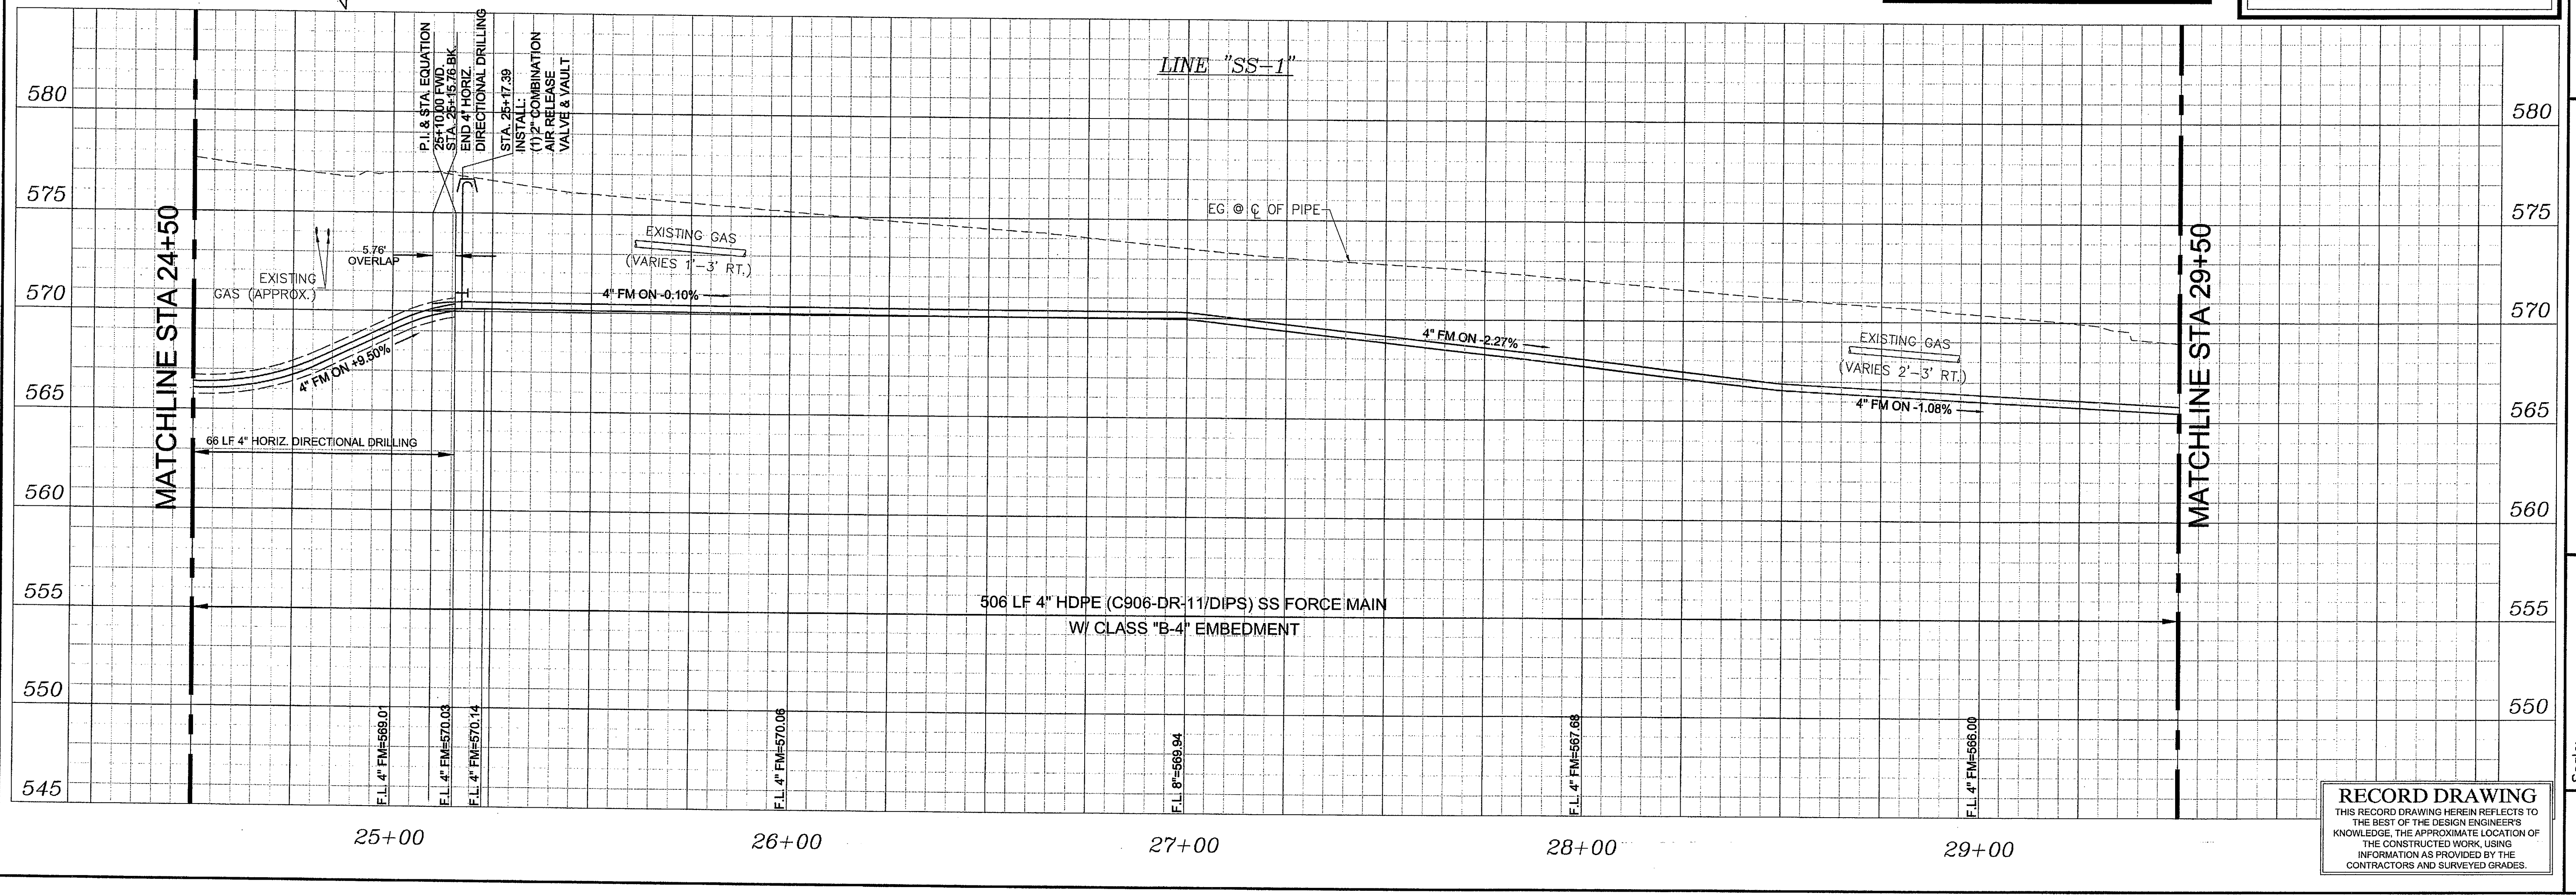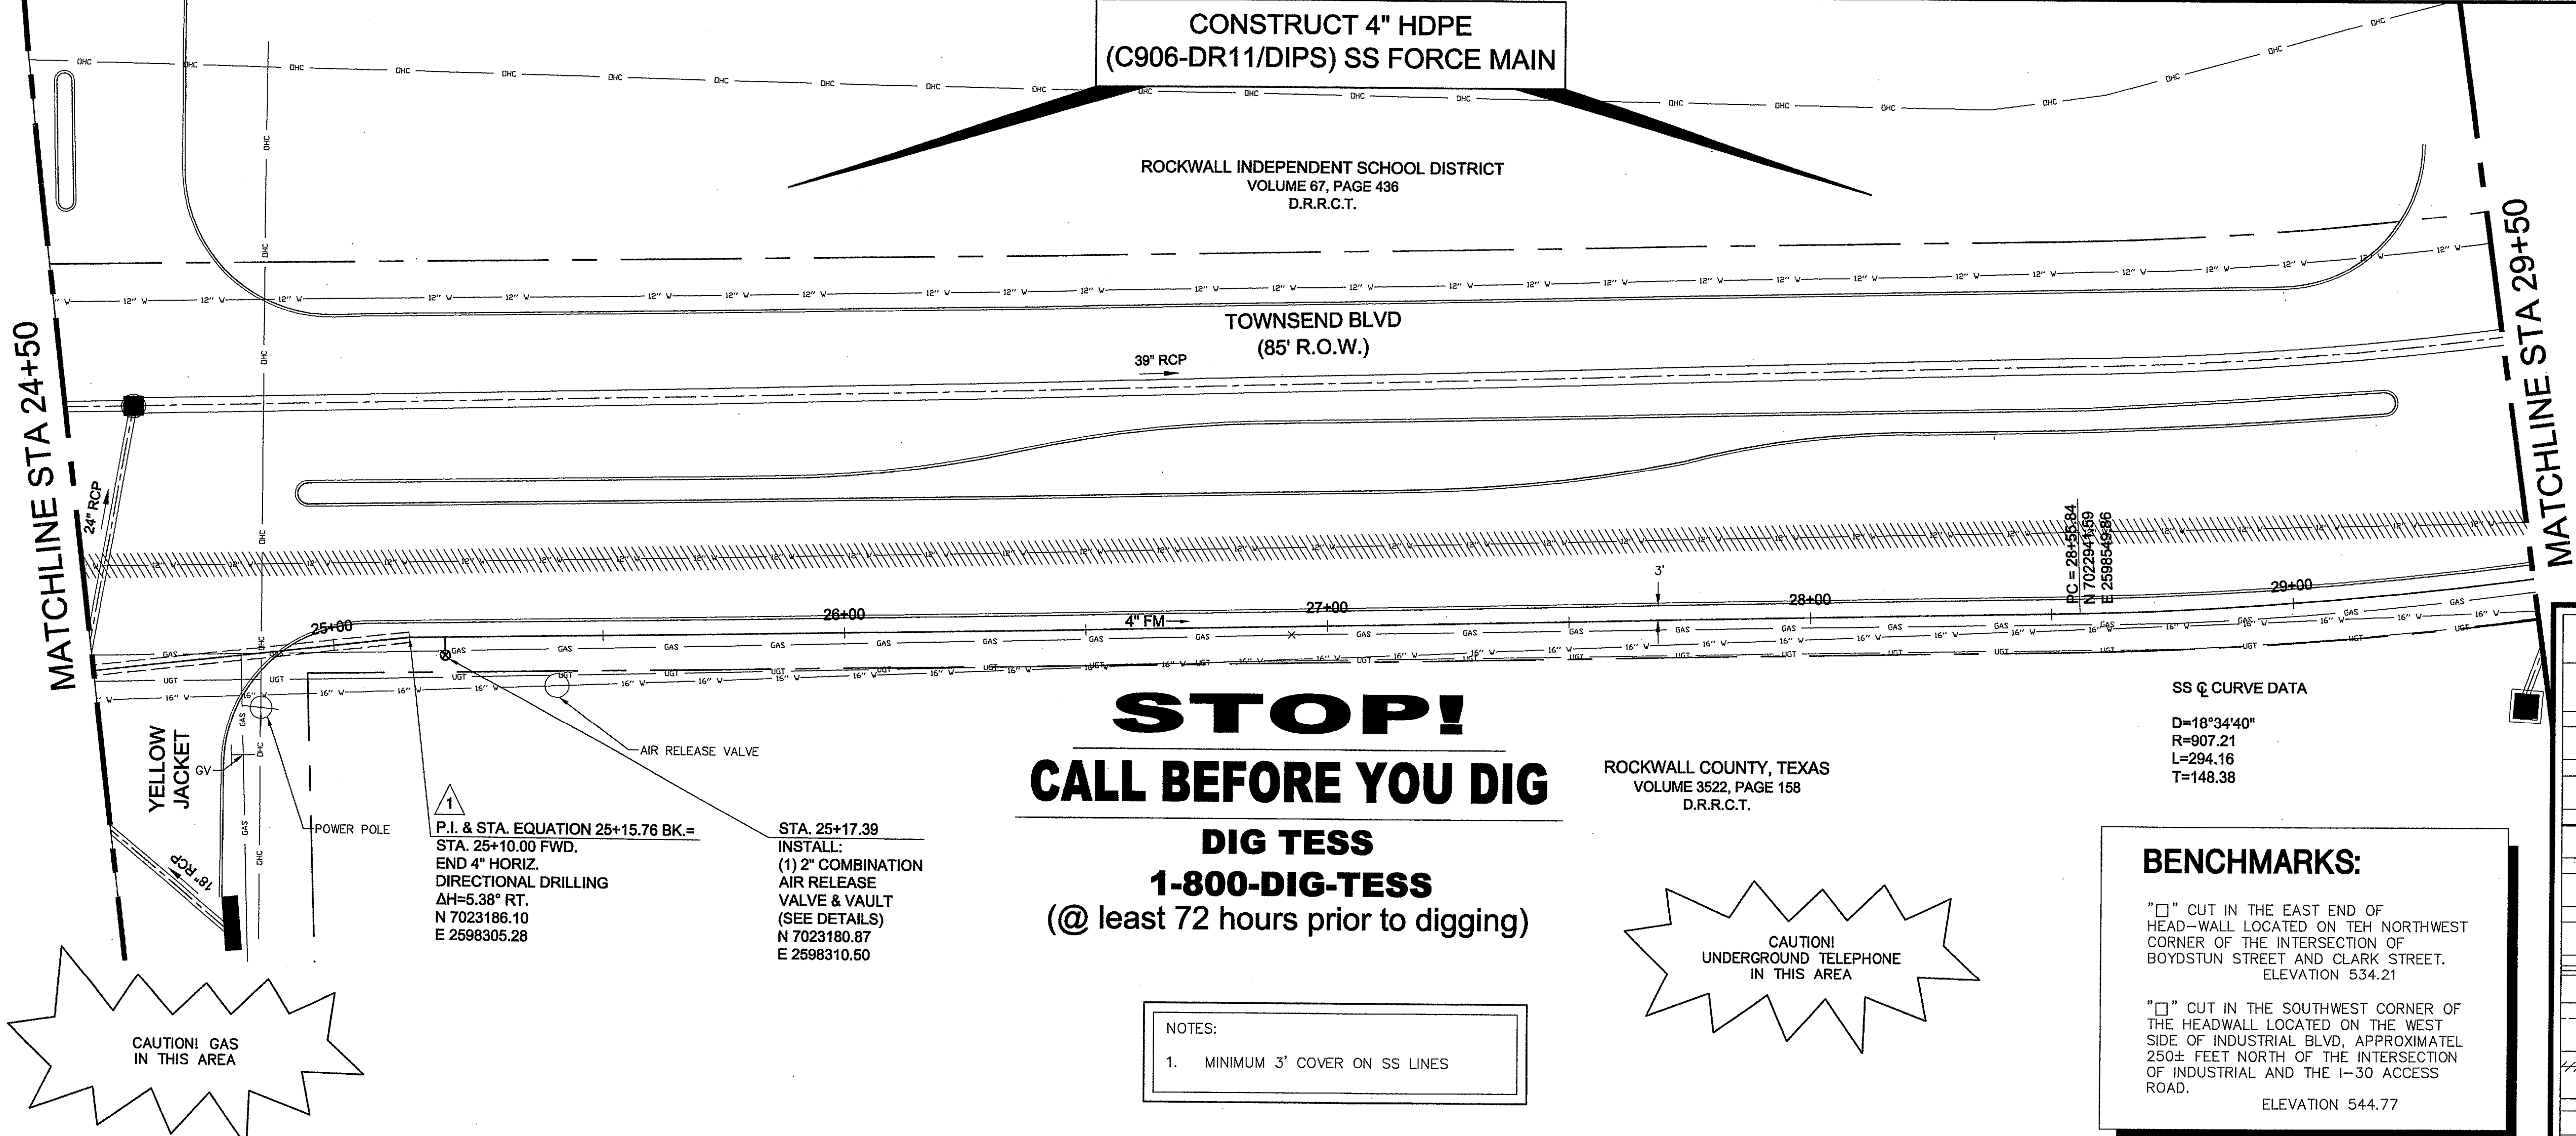

RECORD DRAWING
 THIS RECORD DRAWING HEREIN REFLECTS TO THE BEST OF THE DESIGN ENGINEER'S KNOWLEDGE, THE APPROXIMATE LOCATION OF THE CONSTRUCTED WORK, USING INFORMATION AS PROVIDED BY THE CONTRACTORS AND SURVEYED GRADES.