



RECORD DRAWING
 THIS RECORD DRAWING HEREIN REFLECTS TO THE BEST OF THE DESIGN ENGINEERS KNOWLEDGE, THE APPROXIMATE LOCATION OF THE CONSTRUCTED WORK, USING INFORMATION AS PROVIDED BY THE CONTRACTORS AND SURVEYED GRADES.

Scale:	AS SHOWN
Designed by:	KHA
Drawn by:	KHA
Checked by:	KHA
Date:	DECEMBER 2006
Project No.:	063890013

SHEET
C-9

DIMENSIONAL CONTROL PLAN - 2

EVERGREEN AT ROCKWALL

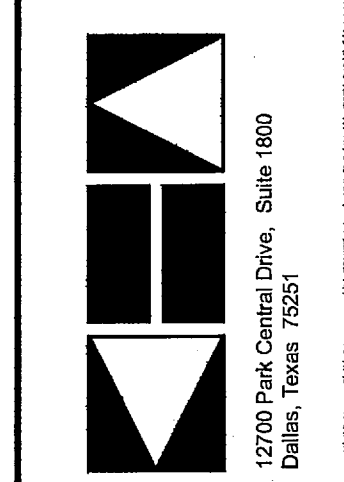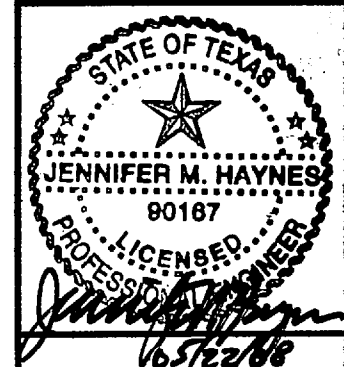

Kimley-Horn and Associates, Inc.
 12700 Park Central Drive, Suite 1000
 Dallas, Texas 75251
 Tel. No. (972) 770-1300
 Fax No. (972) 238-3820

12/14/2006 5:27:20 PM 2:10m
 File: C:\WORK\2006\12\14\2006_12_14_09\2006_12_14_09.dwg [C-9]
 Image: