


LEGEND

EXIST. CONTOUR	---
PROP. CONTOUR	— 550 —
SPOT ELEVATION	50.0
FLOW DIRECTION	→

THE SEAL APPEARING ON THIS DOCUMENT WAS AUTHORIZED BY CHRISTOPHER R. CUNY, P.E. 65642

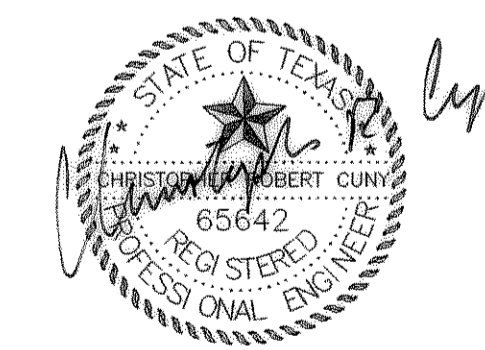

1-30-2003

CONSTRUCTION RECORD DRAWING

REVISED CUL-DE-SAC 8-22-02	
GRADING PLAN	
WILLIS SEALOCK ADDITION	
CITY OF ROCKWALL, ROCKWALL COUNTY, TEXAS	
Michael Willis 2235 Ridge Road • Rockwall, Texas 75087 • (972) 722-1846	
F.C. CUNY CORPORATION 4222 Rosehill Rd, Suite 7 • Garland, Texas 75043 • (972) 240-7700	
Drawn By: DM	Checked By: C.C.
Date: 01/03	Scale: 1/4" = 1'-0"
Project No: 01-000	Sheet No: 7 of 10

BENCHMARK:
RAILROAD SPIKE EMBEDDED IN THE EAST SIDE OF POWER POLE LOCATED AT THE NORTHWEST CORNER OF CEMETERY ROAD AND F.M. 740 (RIDGE ROAD)