

PAVING, GRADING & UTILITIES

FOR

FIRESTONE

LOT 1, BLOCK A DERRICK ADDITION


IN THE

CITY OF ROCKWALL

ROCKWALL COUNTY, TEXAS

DEVELOPER:
MAYS & CO. REAL ESTATE DEVELOPMENT
5949 SHERRY LANE SUITE 1570
DALLAS, TX. 75225
CONTACT: MR. STEVE MEIER
PHONE: 214-363-8400
FAX: 214-363-8409

ARCHITECT
NCA PARTNERS-ARCHITECTURE
12160 N. ABRAMS RD.
SUITE 200
DALLAS, TX. 75243
CONTACT: KYLE BRUNS
PHONE: 214-361-9901
FAX: 214-361-9906

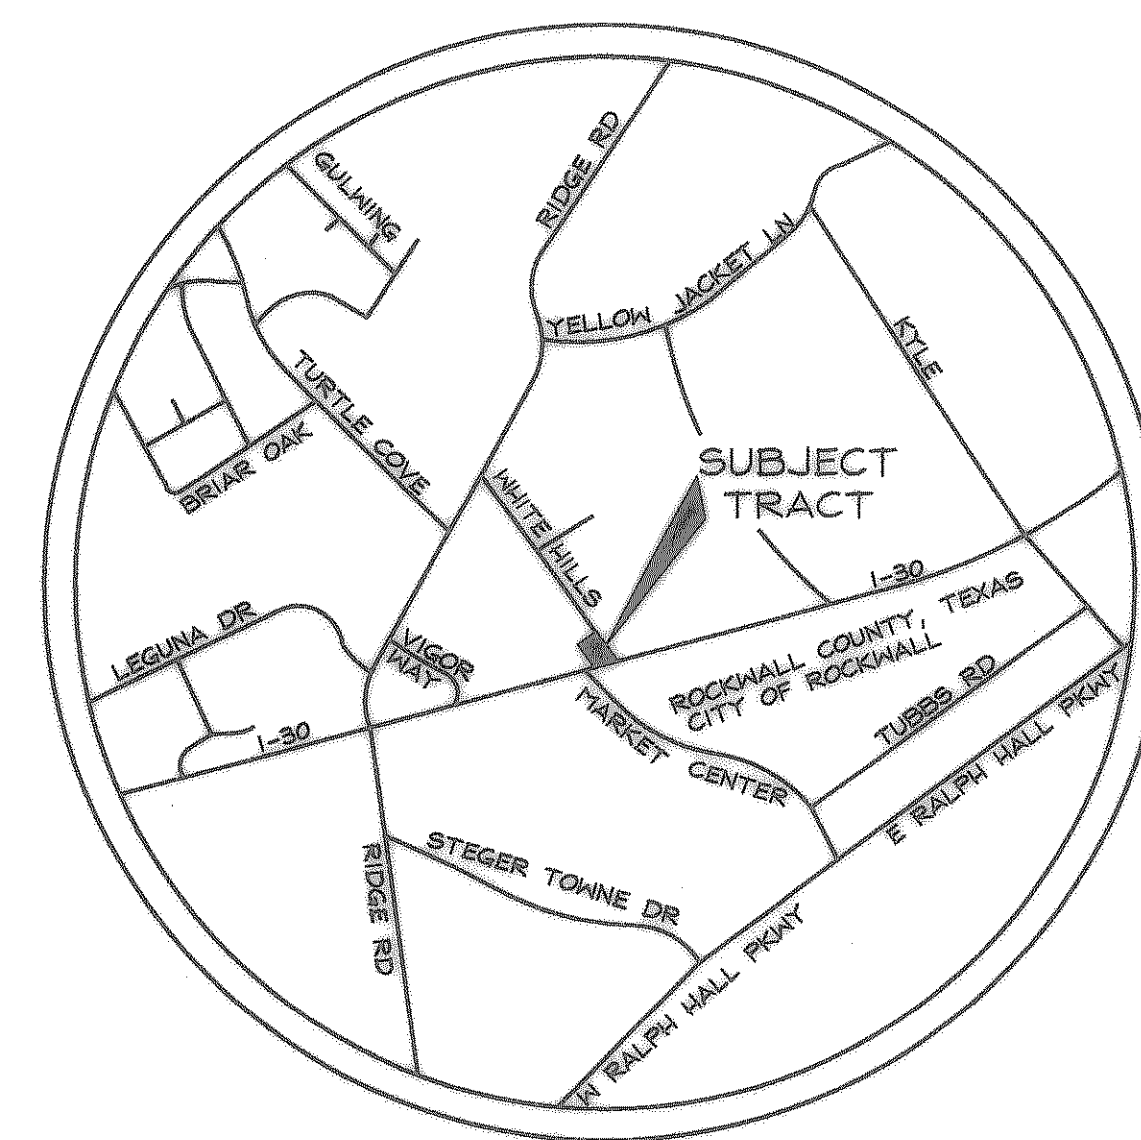

LOCATION MAP


SHEET INDEX

	REPLAT
	BOUNDARY SURVEY
C1	DEMOLITION PLAN
C2	PAVING & LAYOUT PLAN
C3	GRADING PLAN
C4	DRAINAGE AREA MAP & EROSION CONTROL PLAN
C5	UTILITY PLAN
C6	GENERAL NOTES & DETAILS
L1	LANDSCAPE PLAN
L2	IRRIGATION PLAN

DATE: 11/20/08 RECORD DRAWINGS
DATE: 02/01/08 THIRD SUBMITTAL
DATE: 01/23/08 SECOND SUBMITTAL
DATE: 01/07/08 FIRST SUBMITTAL

CONSTRUCTION RECORDS
DATE: 11/21/08
BY: JJJ
THIS DRAWING INDICATES THE WORK COMPLETED FOR INFORMATION.
VERIFICATION WAS NOT PERFORMED EXCEPT AS SPECIFICALLY NOTED.
ALL LOT AND RIGHT-OF-WAY CORNERS HAVE BEEN MARKED WITH
WOODEN PINNACLES.

THE SEAL APPEARING ON THIS
DOCUMENT WAS AUTHORIZED BY
JUAN J. VASQUEZ P.E. 85852, ON
1/2/08

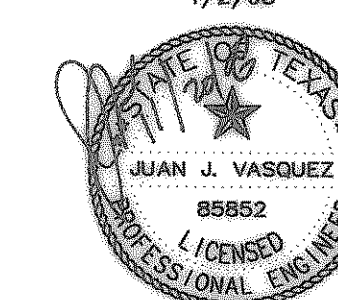

TOMDEN ENGINEERING, L.L.P.
12655 N. Central Expwy., Suite 1016
Dallas, Texas 75243
Ph: 972.386.6446 Fax: 972.386.6409
mail@tomden.com