



BENCHMARK:
ON SITE BENCHMARK, FINISH FLOOR OF EXISTING BUILDING, RELATIVE ELEVATION - 100.00 = 595.28 CITY DATUM.

DRAINAGE CRITERIA							Q = CIA	
AREA NO.	AREA AC	Tc	c	I IN	Q100	REMARKS		
A-1	0.13	10	0.80	9.80	1.02	SHEET FLOW - OFF SITE		
A-2	0.06	10	0.80	9.80	0.47	SHEET FLOW - OFF SITE		
A-3	0.13	10	0.80	9.80	1.02	SHEET FLOW - OFF SITE		
A-4	0.05	10	0.80	9.80	0.39	SHEET FLOW - OFF SITE		
B-1	0.28	10	0.80	9.80	2.20	BASIN 1		
B-2	1.07	10	0.80	9.80	8.39	BASIN 1		
B-3	0.35	10	0.80	9.80	2.74	BASIN 1		
C-1	0.59	10	0.80	9.80	4.63	BASIN 2		
C-2	1.49	10	0.80	9.80	11.68	BASIN 2		
C-3	0.76	10	0.80	9.80	5.96	BASIN 2		
D-1	0.08	10	0.35	9.80	0.27	SHEET FLOW - OFF SITE		
D-2	0.15	10	0.35	9.80	0.44	SHEET FLOW - OFF SITE		
D-3	0.57	10	0.80	9.80	4.47	BASIN 2		
D-4	0.63	10	0.80	9.80	4.94	GOLIAD STREET		
D-5	0.06	10	0.80	9.80	0.47	GOLIAD STREET		


ORIGINAL DETENTION ANALYSIS		ROCKWALL BAPTIST CHURCH	
BASIN 2 03JAN05		MODIFIED RATIONAL	
PREDEVELOPMENT CONDITIONS		AREA = ORIGINAL PLUS D-1 = 3.07 ac	
C = 0.35			
Tc = 20 min.			
Iw = 8.40			
Q = 0.35 X 8.40 X 3.07 = 6.01 cfs			
ADDITIONAL EXISTING PAVEMENT AT 0.40 - .85 X .40 X 9.00 = 3.06 cfs		TOTAL 6.01 + 3.06 = 9.07 cfs	
POSTDEVELOPMENT CONDITIONS		AREA = 3.47 ac	
C = 0.80			
Tc = 10 min.			
Iw = 9.80			
Q = 0.80 X 9.80 X 3.47 = 27.20 cfs			
15 min.	I = 9.00 Q = 0.80 X 9.00 X 3.47 = 24.98 cfs		
20 min.	I = 8.30 Q = 0.80 X 8.30 X 3.47 = 23.04 cfs		
30 min.	I = 6.80 Q = 0.80 X 6.80 X 3.47 = 18.88 cfs		
40 min.	I = 5.80 Q = 0.80 X 5.80 X 3.47 = 16.10 cfs		
50 min.	I = 5.00 Q = 0.80 X 5.00 X 3.47 = 13.88 cfs		
60 min.	I = 4.50 Q = 0.80 X 4.50 X 3.47 = 12.49 cfs		
70 min.	I = 4.20 Q = 0.80 X 4.20 X 3.47 = 11.66 cfs		
80 min.	I = 3.80 Q = 0.80 X 3.80 X 3.47 = 10.55 cfs		
Storage Volume			
15 min. Storm Inflow 15 X 24.98 X 60 sec./min.	= 22,482 cf		
Outflow 0.5 X 30 X 9.07 X 60 sec./min.	= 8,163 cf		
20 min. Storm Inflow 20 X 23.04 X 60 sec./min.	= 27,648 cf		
Outflow 0.5 X 35 X 9.07 X 60 sec./min.	= 9,524 cf		
30 min. Storm Inflow 30 X 18.88 X 60 sec./min.	= 33,984 cf		
Outflow 0.5 X 45 X 9.07 X 60 sec./min.	= 12,245 cf		
40 min. Storm Inflow 40 X 16.10 X 60 sec./min.	= 38,640 cf		
Outflow 0.5 X 55 X 9.07 X 60 sec./min.	= 14,966 cf		
50 min. Storm Inflow 50 X 13.88 X 60 sec./min.	= 41,640 cf		
Outflow 0.5 X 65 X 9.07 X 60 sec./min.	= 17,687 cf		
60 min. Storm Inflow 60 X 12.49 X 60 sec./min.	= 44,964 cf		
Outflow 0.5 X 75 X 9.07 X 60 sec./min.	= 20,408 cf		
70 min. Storm Inflow 70 X 11.66 X 60 sec./min.	= 48,972 cf		
Outflow 0.5 X 85 X 9.07 X 60 sec./min.	= 23,129 cf		
80 min. Storm Inflow 80 X 10.55 X 60 sec./min.	= 50,640 cf		
Outflow 0.5 X 95 X 9.07 X 60 sec./min.	= 25,850 cf		
PEAK VOLUME = 25,843 ft ³ at 70 min. Storm			

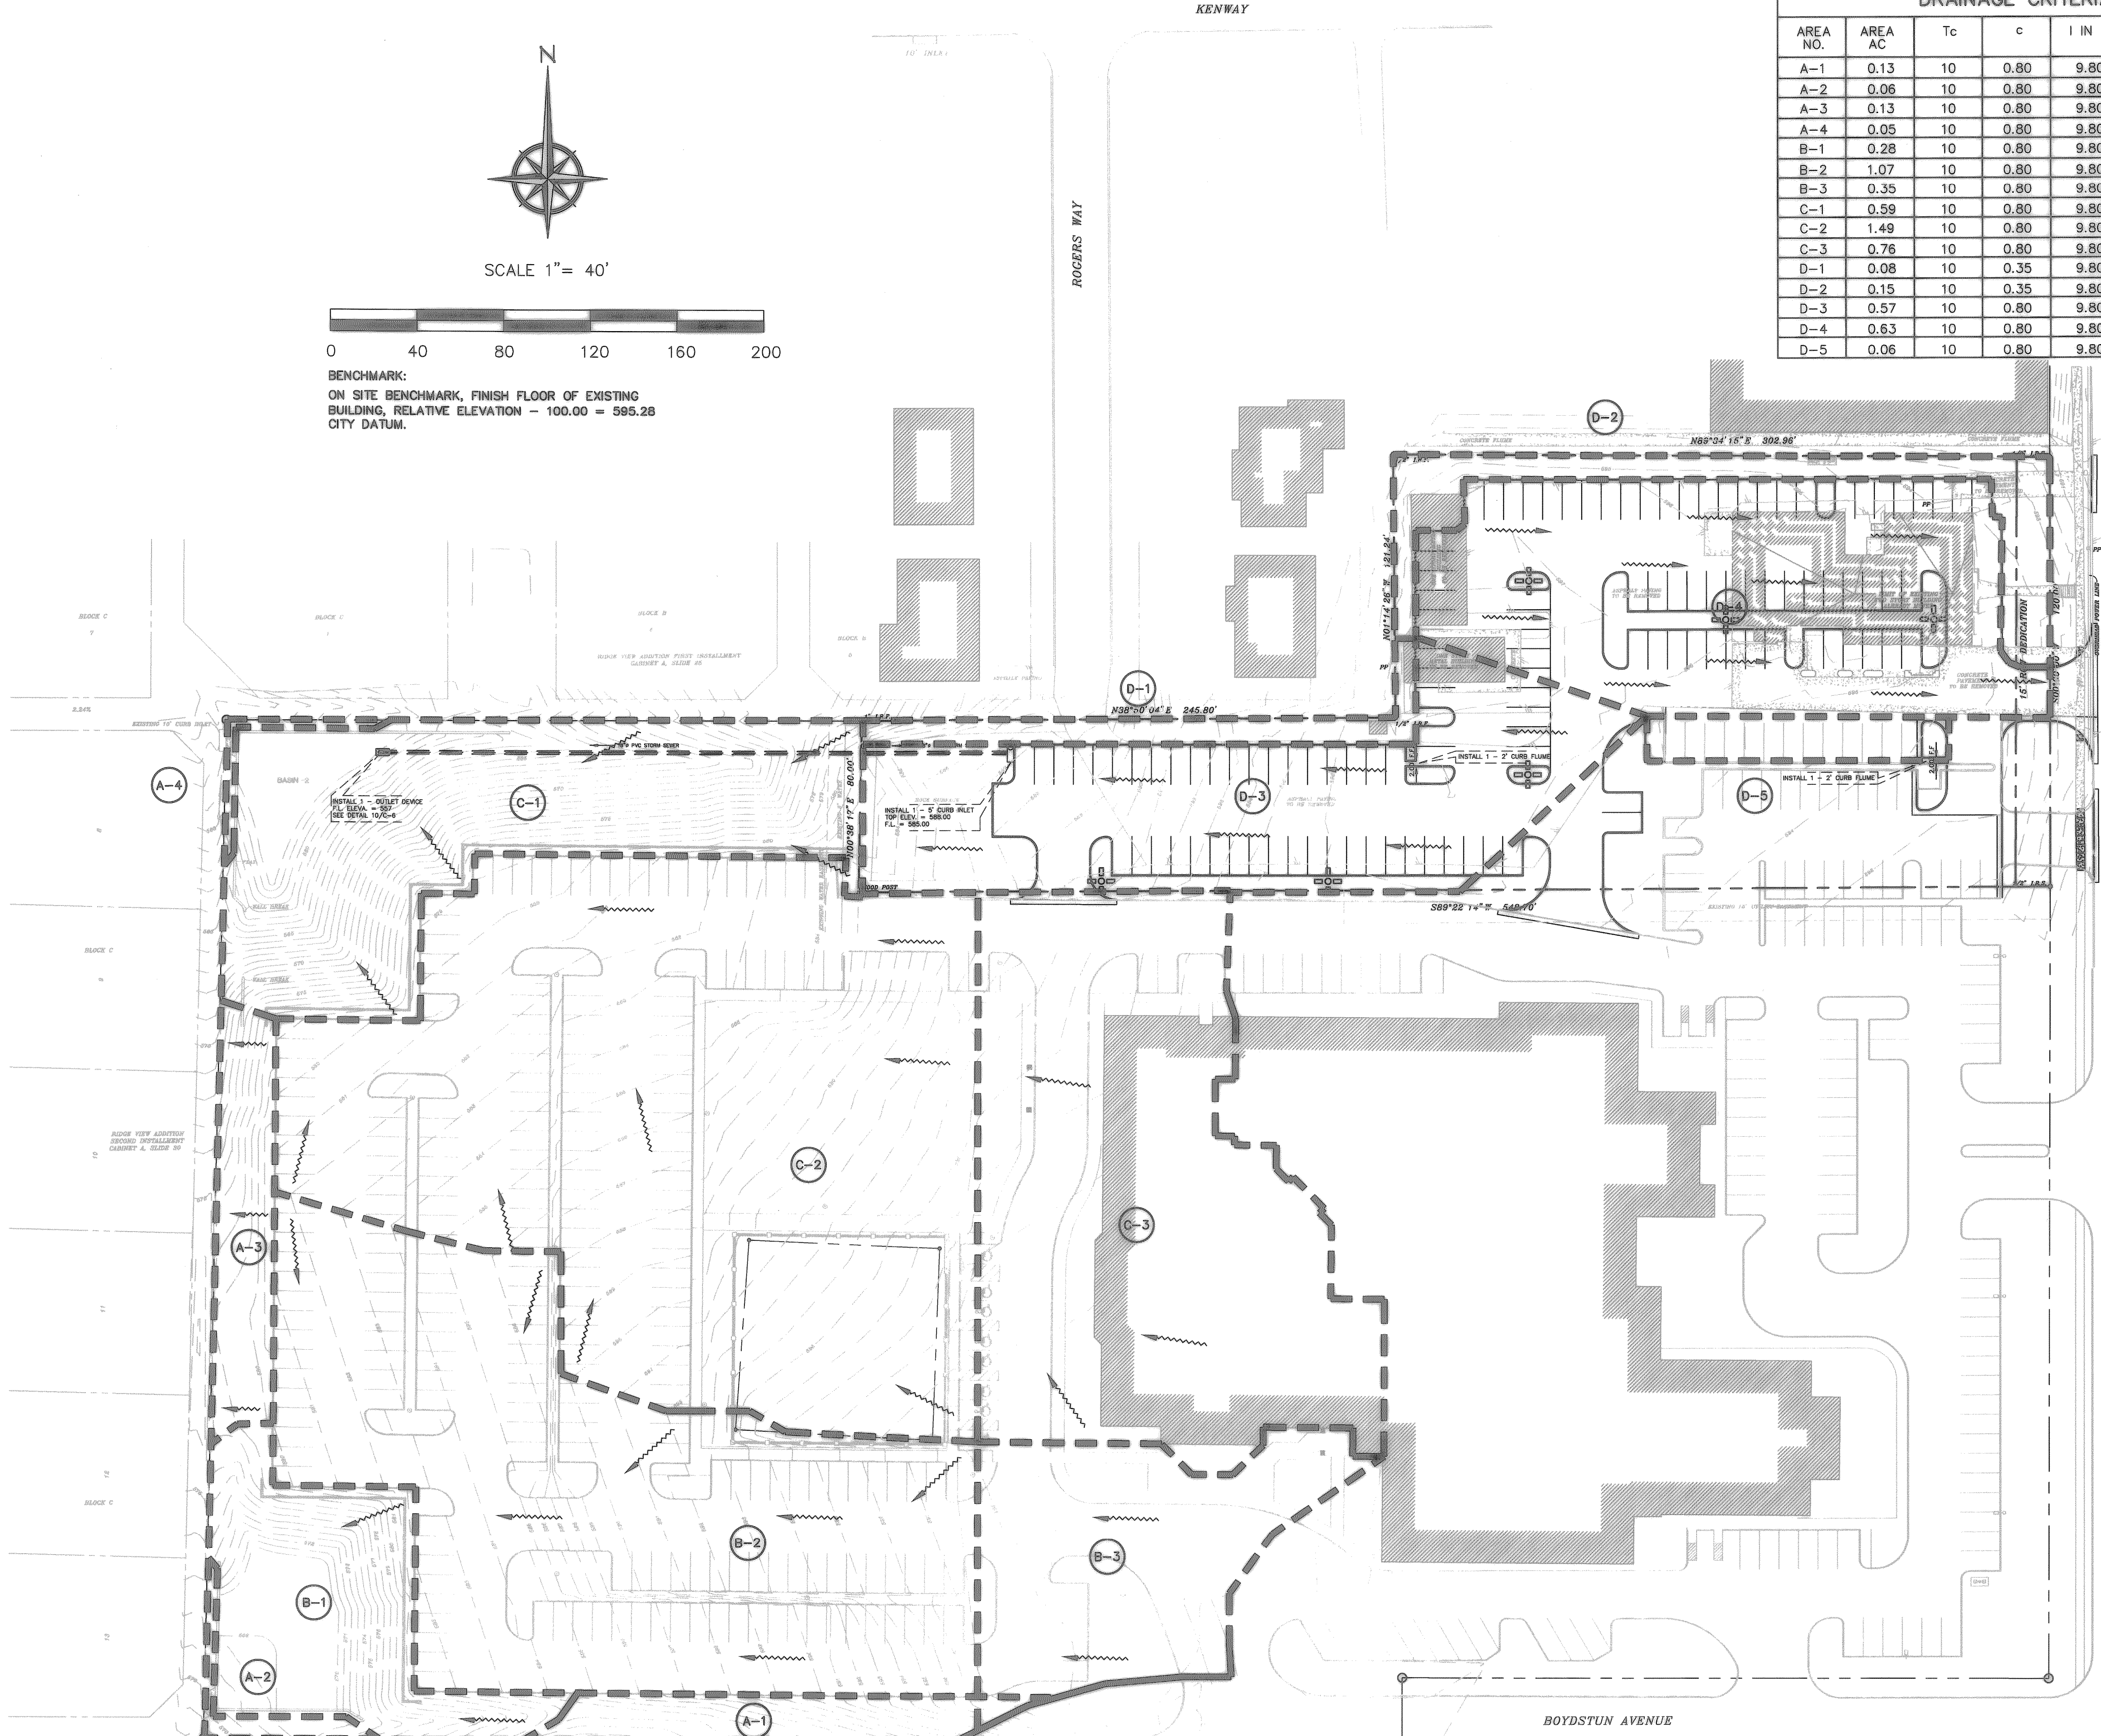

NEW DETENTION ANALYSIS		ROCKWALL BAPTIST CHURCH	
BASIN 2 03JAN05A		MODIFIED RATIONAL	
PREDEVELOPMENT CONDITIONS		AREA = ORIGINAL PLUS D-1 = 3.07 ac	
C = 0.35			
Tc = 20 min.			
Iw = 8.30			
Q = 0.35 X 8.30 X 3.07 = 8.92 cfs			
ADDITIONAL EXISTING PAVEMENT AT 0.40 = 0.85 X 0.40 X 8.30 = 2.82 cfs		TOT 8.92 + 2.82 = 11.74 cfs > ORIGINAL DISCHARGE USE 9.07 cfs	
POSTDEVELOPMENT CONDITIONS		AREA = 2.82 ac (PAVED) + 0.59 ac (POND)	
C = 0.80			
Tc = 10 min.			
Iw = 9.80			
Q = 0.80 X 9.80 X 2.82 + 0.35 X 9.80 X 0.59 = 24.12 cfs			
FOR WEIGHTED "C" (2.82 + 0.59) X 0.80 X 9.80 = 26.73 cfs 24.12/26.73 = 0.90			
10 min.	I = 9.80 Q = 0.80 X 9.80 X 3.41 = 26.73 X 0.90 = 24.06 cfs		
15 min.	I = 9.00 Q = 0.80 X 9.00 X 3.41 = 24.55 X 0.90 = 22.10 cfs		
20 min.	I = 8.30 Q = 0.80 X 8.30 X 3.41 = 22.64 X 0.90 = 20.38 cfs		
30 min.	I = 6.80 Q = 0.80 X 6.80 X 3.41 = 18.55 X 0.90 = 16.70 cfs		
40 min.	I = 5.80 Q = 0.80 X 5.80 X 3.41 = 16.24 X 0.90 = 14.62 cfs		
50 min.	I = 5.00 Q = 0.80 X 5.00 X 3.41 = 13.64 X 0.90 = 12.28 cfs		
60 min.	I = 4.50 Q = 0.80 X 4.50 X 3.41 = 12.28 X 0.90 = 11.05 cfs		
70 min.	I = 4.20 Q = 0.80 X 4.20 X 3.41 = 11.48 X 0.90 = 10.31 cfs		
80 min.	I = 3.80 Q = 0.80 X 3.80 X 3.41 = 10.37 X 0.90 = 9.33 cfs		
Storage Volume			
10 min. Storm Inflow 10 X 24.06 X 60 sec./min.	= 14,436 cf		
Outflow 0.5 X 20 X 9.07 X 60 sec./min.	= 5,442 cf		
15 min. Storm Inflow 15 X 22.10 X 60 sec./min.	= 19,890 cf		
Outflow 0.5 X 25 X 9.07 X 60 sec./min.	= 6,803 cf		
20 min. Storm Inflow 20 X 20.38 X 60 sec./min.	= 24,456 cf		
Outflow 0.5 X 30 X 9.07 X 60 sec./min.	= 8,163 cf		
30 min. Storm Inflow 30 X 16.70 X 60 sec./min.	= 30,060 cf		
Outflow 0.5 X 40 X 9.07 X 60 sec./min.	= 10,884 cf		
40 min. Storm Inflow 40 X 14.24 X 60 sec./min.	= 34,176 cf		
Outflow 0.5 X 50 X 9.07 X 60 sec./min.	= 13,605 cf		
50 min. Storm Inflow 50 X 12.28 X 60 sec./min.	= 36,840 cf		
Outflow 0.5 X 60 X 9.07 X 60 sec./min.	= 16,326 cf		
60 min. Storm Inflow 60 X 11.05 X 60 sec./min.	= 39,780 cf		
Outflow 0.5 X 70 X 9.07 X 60 sec./min.	= 19,047 cf		
70 min. Storm Inflow 70 X 10.31 X 60 sec./min.	= 43,302 cf		
Outflow 0.5 X 80 X 9.07 X 60 sec./min.	= 21,768 cf		
80 min. Storm Inflow 80 X 9.33 X 60 sec./min.	= 44,784 cf		
Outflow 0.5 X 90 X 9.07 X 60 sec./min.	= 24,489 cf		
PEAK VOLUME = 21,571 ft ³ at 40 min. Storm RAISE WALL 2.3 FEET			

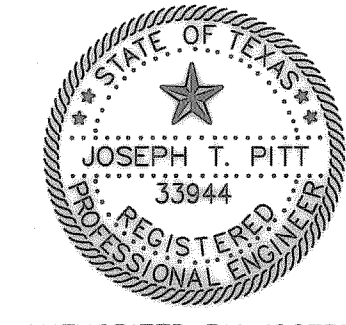

SEAL AUTHORIZED BY JOSEPH T. PITT ON JANUARY 5, 2005

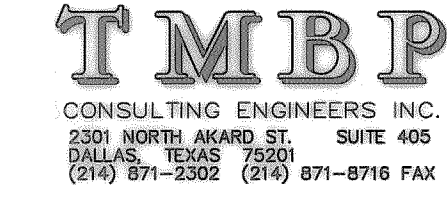

NOTE: CONTRACTOR SHALL PROVIDE STORM WATER POLLUTION PREVENTION PLAN.

REV. NO.	TYPE OF WORK	ENG.	DATE	CITY OF ROCKWALL	DATE
DRAINAGE AREA MAP					
2004 PARKING ADDITION					
FIRST BAPTIST CHURCH - ROCKWALL, TX					
PUBLIC WORKS DEPARTMENT					
CITY OF ROCKWALL, TEXAS					
DESIGN DRAWN	DATE	SCALE	NOTES	FILE	NO.
J. PITT	R. MITCH	FEB 2005	1"=40'		C-4