

S. COLIAD STREET - STATE HIGHWAY NO. 205


- SAW CUT- INSTALL NEW CURB SECTION PER TXDOT STANDARDS
- MATCH EXISTING
- INSTALL HANDICAP RAMP PER TYPICAL DETAILS
- SAW CUT- INSTALL STANDARD APPROACH PER TXDOT STANDARDS
- MATCH EXISTING
- SAW CUT- INSTALL NEW CURB PER TXDOT STANDARD
- INSTALL NEW SIDEWALK TO MATCH EXISTING

INSTALL 1' - 5' CURB INLET  
TOP ELEV. = 588.00  
F.L. = 585.00


INSTALL 1' - 2' CURB FLUME

INSTALL 1' - 2' CURB FLUME


- NOTES:
1. FIRELANE TO BE 6" MINIMUM 3600 psi CONCRETE ( 6 SACK MINIMUM MACHINE POWER OR 6 1/2 MINIMUM FOR HAND POUR).
  2. NO SAND UNDER PAVEMENT.
  3. PARKING LOT PAVEMENT TO BE 5" MINIMUM 3000 psi CONCRETE.
  4. ALL FILL TO BE COMPACTED TO 95% STANDARD DENSITY AND USING A SHEEP'S FOOT ROLLER.
  5. ALL GRADES ARE AT TOP OF PAVEMENT UNLESS NOTED OTHERWISE.
- LEGEND:
- G = GUTTER
  - EX. = EXISTING

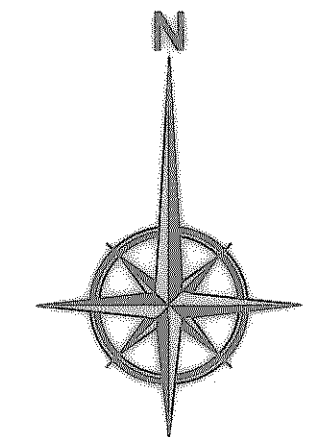

SCALE 1" = 20'

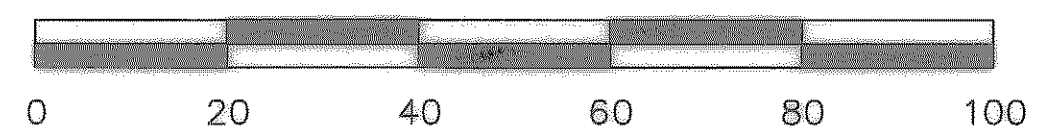

BENCHMARK:  
ON SITE BENCHMARK, FINISH FLOOR OF EXISTING BUILDING, RELATIVE ELEVATION - 100.00 = 595.28 CITY DATUM.

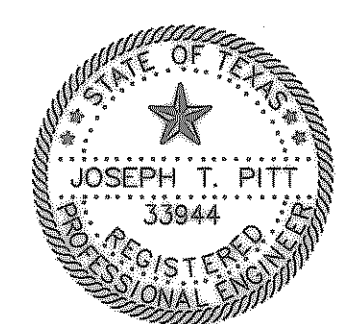

SEAL AUTHORIZED BY JOSEPH T. PITT ON JANUARY 5, 2005

**TMBP**  
CONSULTING ENGINEERS INC.  
2301 NORTH AKARD ST. SUITE 405  
DALLAS, TEXAS 75201  
(214) 571-2322 (214) 571-5716 FAX

REV. NO.	TYPE OF WORK	ENG.	DATE	CITY OF ROCKWALL	DATE
<b>PAVING AND GRADING PLAN</b>					
<b>2004 PARKING ADDITION</b>					
<b>FIRST BAPTIST CHURCH - ROCKWALL, TX</b>					
<b>PUBLIC WORKS DEPARTMENT</b>					
<b>CITY OF ROCKWALL, TEXAS</b>					
DESIGN	DRAWN	DATE	SCALE	NOTES	FILE NO.
J. PITT	R. MITCH	FEB 2005	1"=20'		C-2