


ENGINEERING PLANS

FIRST BAPTIST CHURCH PARKING ADDITION CITY OF ROCKWALL, TEXAS

INDEX

SHEET NO.	DESCRIPTION
00	PLAT
L1	LANDSCAPE PLAN
L2	TREE MITIGATION PLAN
C1	DIMENSION CONTROL PLAN
C2	PAVING AND GRADING PLAN
C3	DRAINAGE AREA MAP
C4	EROSION CONTROL PLAN
C5	GENERAL NOTES & PROFILES

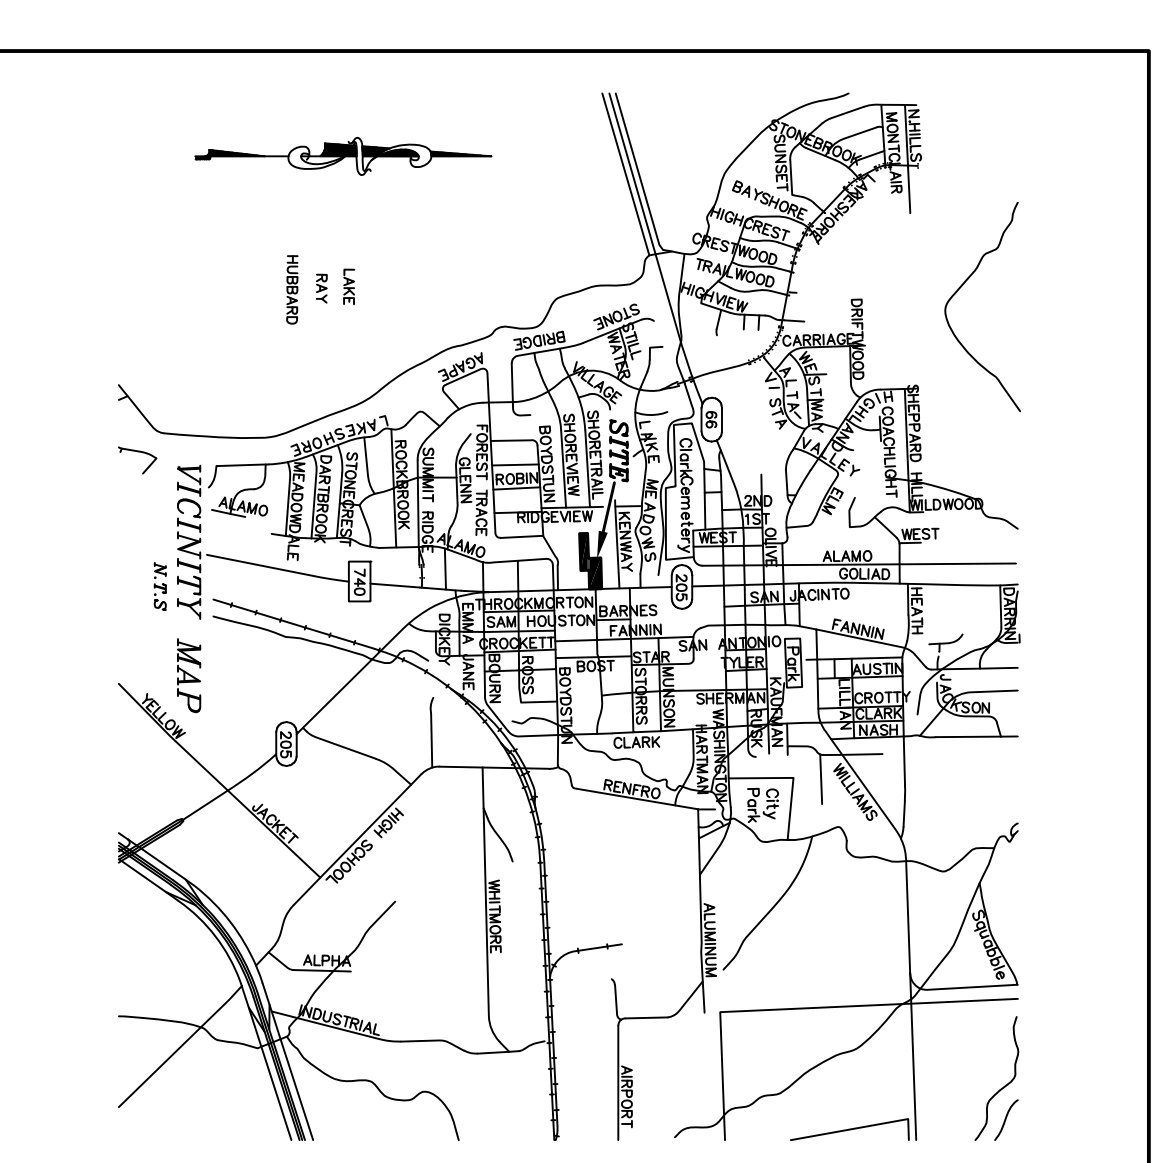

LOCATION MAP



FIRST BAPTIST CHURCH OF ROCKWALL

610 SOUTH GOLIAD

ROCKWALL, TEXAS 75087

TMBP CONSULTING ENGINEERS

2301 N. AKARD SUITE 405

DALLAS, TEXAS 75201

RECORD DRAWINGS
FEBRUARY 10, 2010

FIRST BAPTIST CHURCH PARKING ADDITION