


S. GOLIAD STREET (STATE HIGHWAY 205)
50' R.O.W. PER PLAT

GENERAL NOTES:


- BOUNDARY AND TOPOGRAHIC INFORMATION TAKEN FROM A SURVEY PREPARED BY ROCKWALL SURVEYING CO. (1984 & 1991) FOR THE CITY, TX 1589 (9/17/12-5/3/14) DATED JANUARY 23, 2008. CONTRACTOR SHALL FIELD VERIFY ALL CONTROL, DIMENSIONS, ELEVATIONS AND FLOW LINE ELEVATIONS PRIOR TO CONSTRUCTION AND REPORT DISCREPANCIES TO ARCHITECT.
- ELEVATIONS/PROF. GRADERS SHOULD USE FINISH GRADES/CONTROLS AND COORDINATE GRADING AND ELEVATIONS WITH ARCHITECTURAL AND LANDSCAPE DRAWINGS. REFER TO SITE PLAN FOR ALL DIMENSIONS.
- LOCATION, SIZE AND TYPE OF EXISTING UTILITIES WERE BASED UPON NOTED INFORMATION AND VERTICALLY ADJUSTED AS NECESSARY. CONTRACTOR SHALL VERIFY ALL UTILITIES TO BE CONNECTED WITH OR THAT MAY CONFLICT WITH HIS CONSTRUCTION. CONTRACTOR IS RESPONSIBLE FOR PROTECTION OF ALL UTILITIES DURING CONSTRUCTION.
- ALL UTILITY CONSTRUCTION SHALL BE IN ACCORDANCE WITH THE STANDARD SPECIFICATIONS AND DETAILS OF THE CITY OF ROCKWALL, TEXAS AND NOTCOG 3rd EDITION UNLESS NOTED OTHERWISE. CONTRACTOR SHALL PROVIDE BACKFILL PROTECTION PER CITY REQUIREMENTS.
- TYPICAL PAVING SHALL BE NORMAL WEIGHT CONCRETE WITH A MINIMUM 18" DUAL TYPING COURSE. FINISH SHALL BE FINISHED WITH A FINISH MACHINE FINISHED AND 6 1/2" SACK MIN. FOR HAND FINISHED) AND REINFORCED W/ #3 @ 18" ON CENTER EACH WAY. 2" CLEAR FROM TOP OF SLAB. TYPICAL PAVING THICKNESS SHALL BE 5" AND SHALL BE 6" AT FIRE LINES (SEE BH# C-2). SUBGRADE (6" MINIMUM) SHALL BE COMPACTED USING A MINIMUM OF 10% FINE SAND. FINISH SHALL BE FINISHED WITH A FINISH MACHINE AND UNDER PAVEMENT CONTRACTOR SHALL PROVIDE CONSTRUCTION JOINTS AT EVERY FOURTH JOINT (60' ON CENTER MAX). EACH CONSTRUCTION JOINT AT EVERY FOURTH JOINT (60' ON CENTER MAX) WITH EXPANSION JOINTS AT EVERY FOURTH JOINT (60' ON CENTER MAX). EACH CONSTRUCTION JOINT AT EVERY FOURTH JOINT (60' ON CENTER MAX) WITH EXPANSION AND APPROVAL.

- ALL REINFORCING SHALL CONFORM TO ASTM A-615, GRADE 60. ALL SIDEWALKS, RAMP, ETC. SHALL BE CITY OF ROCKWALL STANDARDS AND NOTCOG 3rd EDITION STANDARDS.
- ALL FILL MATERIAL MAY BE ON-SITE OR SIMILAR MATERIAL UNDER PAVING. CONTRACTOR SHALL BE RESPONSIBLE FOR PROTECTING EXISTING UTILITIES AT ALL TIMES. CONTRACTOR SHALL BE RESPONSIBLE FOR PROTECTING EXISTING UTILITIES AT ALL TIMES. CONTRACTOR SHALL BE RESPONSIBLE FOR PROTECTING EXISTING UTILITIES AT ALL TIMES.
- CONTRACTOR IS RESPONSIBLE FOR SAFETY ON THE PROJECT AND SHALL PROVIDE CONSTRUCTION PER OHSA REQUIREMENTS, TITLE 29, (LATEST), AS WELL AS OTHER APPLICABLE BUILDING CODE REQUIREMENTS.
- CONTRACTOR SHALL PROVIDE EROSION PROTECTION PER BMP MANUAL, "STORM WATER QUALITY BEST MANAGEMENT PRACTICES FOR CONSTRUCTION ACTIVITIES" AS PUBLISHED BY THE NORTH CENTRAL TEXAS COUNCIL OF GOVERNMENTS. PROVIDE 6" FENCE AT DOWNHILL SIDE OF ALL EXCAVATIONS GREATER THAN TEN FEET WIDE AND AT NO GREATER THAN 100' APART AT LARGER OR LONGER EXCAVATIONS. ALL DISTURBED AREAS SHALL RECEIVE HYDRO-MULCH AFTER TOP SOIL HAS BEEN REPAIRED. NO AREA CAN EXCEED 3:1 SLOPE. ALL RIGHT-OF-WAY THAT IS DISTURBED MUST BE STOPPED.

USE CITY STANDARDS AND NOTCOG 3rd EDITION STANDARDS.

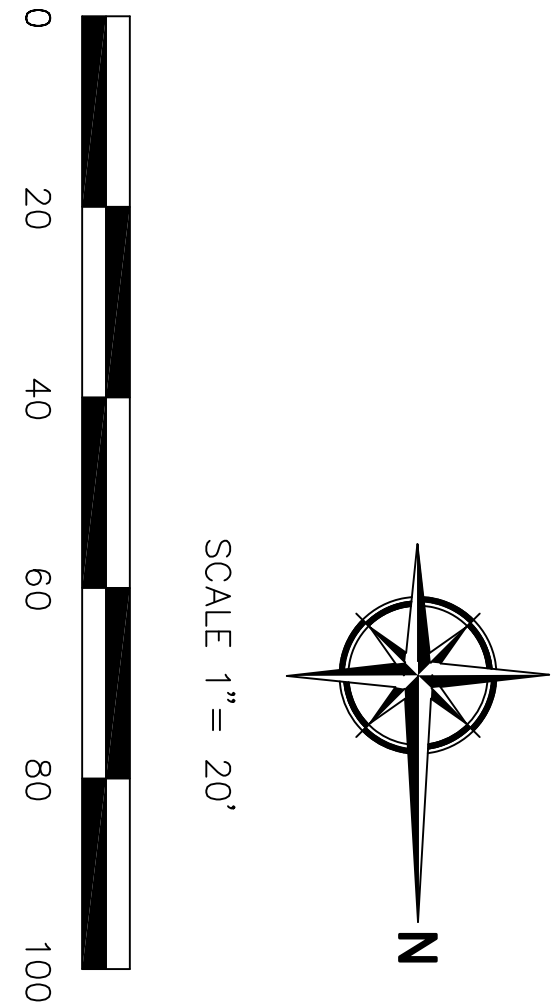

RECORD DRAWINGS
FEBRUARY 10, 2010

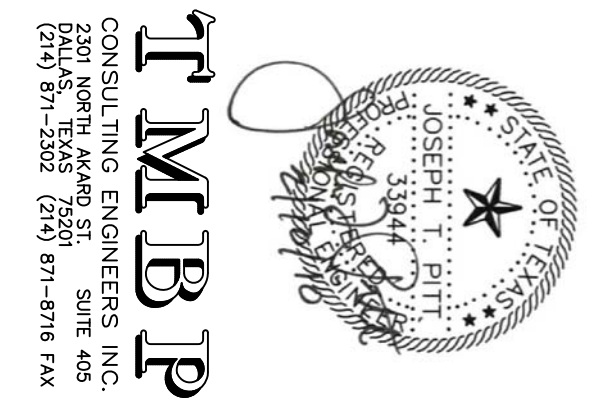

REV. NO.	TYPE OF WORK	ENG.	DATE	CITY OF ROCKWALL	DATE

PAVING AND GRADING PLAN
2008 PARKING ADDITION
FIRST BAPTIST CHURCH - ROCKWALL, TX
PUBLIC WORKS DEPARTMENT
CITY OF ROCKWALL, TEXAS

DESIGN DRAWN	DATE	SCALE	NOTES	FILE	NO.
J. PITT	AUG 28	AS SHOWN			C-2