


DRAINAGE DESIGN CRITERIA

BASIS:
 RATIONAL METHOD Q = CIA
 Q = CUBIC FEET PER SECOND
 I = DESIGN STORM INTENSITY
 A = DRAINAGE AREA (ACRES)
 RUNOFF COEFFICIENT:
 0.90 SHOPPING CENTERS

INTENSITY:
 RAINFALL INTENSITY-DURATION-FREQUENCY CURVES FOR AREA DEVELOPED FROM NATIONAL WEATHER SERVICE MEMPHIS, TENNESSEE, HYDRO-35, DATED JUNE 1977 AND TECHNICAL PAPER NO. 40, DATED MAY 1961.

STORM FREQUENCY:
 100 YEAR
 TIME OF CONCENTRATION:
 10 MINUTES

DRAINAGE SYMBOL LEGEND

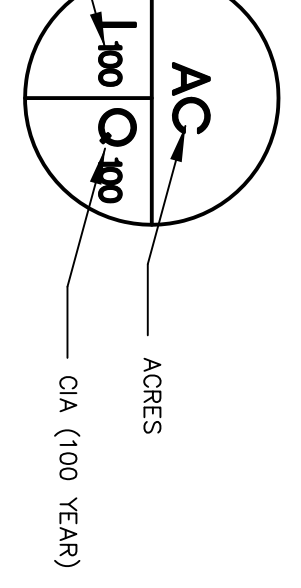

OFFICE CALCULATION

RAINFALL INTENSITY (100 YEAR)
 $I = 1.48$
 $Q = 3.62$
 $A = 1.09 \rightarrow 3.93$
 USE 4.17 ϕ

RAINFALL INTENSITY (100 YEAR)
 $I = 3.62$
 $Q = 1.95$
 $A = 2.68 \rightarrow 3.84$
 USE 7 ϕ

DRAINAGE LEGEND



NOTE: IF IMPROVEMENTS ARE INSTALLED PRIOR TO CONSTRUCTION OF TxDOT SYSTEMS, PLUG THE METERS AND INSERT AT EACH DISCHARGING INLET AND THE ENDS OF PROPOSED AREAS. INSTALL A METERS IN THE TRENCH LINE AND THE TRENCH LINE SHALL BE POLISHED AND WILL CONNECT TO THE TxDOT INLETS AND REMOVE THE "V" NOTCH HERE.

BENCHMARK:
 ON SITE BENCHMARK, FINISH FLOOR OF EXISTING BUILDING, RELATIVE ELEVATION = 100.00 = 595.28 CITY DATUM.

DRAINAGE AREA MAP

REV. NO.	TYPE OF WORK	ENG.	DATE	CITY OF DATE
1	DESIGN DRAWING	RAMTCH	AUG 28 2008	

PREDEVELOPMENT CONDITIONS

15 min.	20 min.	30 min.	40 min.	50 min.	60 min.	70 min.
I = 9.00 Q = .90 X 9.00 X 1.23 = 9.96 cfs	I = 8.30 Q = .90 X 8.30 X 1.23 = 9.19 cfs	I = 6.90 Q = .90 X 6.90 X 1.23 = 7.64 cfs	I = 5.80 Q = .90 X 5.80 X 1.23 = 6.42 cfs	I = 5.00 Q = .90 X 5.00 X 1.23 = 5.54 cfs	I = 4.50 Q = .90 X 4.50 X 1.23 = 4.98 cfs	I = 4.10 Q = .90 X 4.10 X 1.23 = 4.54 cfs

POSTDEVELOPMENT CONDITIONS


30 min.	40 min.	50 min.	60 min.	70 min.	80 min.
Storm Inflow 30 X 7.64 X 60 sec./min. = 13,752 cf	Storm Inflow 40 X 6.42 X 60 sec./min. = 6,120 cf	Storm Inflow 50 X 5.54 X 60 sec./min. = 7,550 cf	Storm Inflow 60 X 4.98 X 60 sec./min. = 7,148 cf	Storm Inflow 70 X 4.54 X 60 sec./min. = 6,828 cf	Storm Inflow 80 X 4.32 X 60 sec./min. = 6,596 cf

DRAINAGE CRITERIA Q = CIA


AREA NO.	AREA AC	Tc	C	I IN	Q 100	REMARKS
A	0.44	10	0.90	9.80	3.88	5' CURB INLET
B	0.36	10	0.90	9.80	3.17	5' CURB INLET
C	0.42	10	0.90	9.80	3.70	5' CURB INLET
D	0.45	10	0.90	9.80	3.97	10' CURB INLET
E	0.07	10	0.90	9.80	0.62	OFF SITE
F	0.18	10	0.90	9.80	1.59	OFF SITE

DETENTION DISCHARGE

YEAR	DETAINED VOLUME	WATER SURFACE ELEV.	STORM A Q ACTUAL	STORM A Q ALLOWED	STORM B Q ACTUAL	STORM B Q ALLOWED
2 YEAR	3,222 ft ³	592.08	1.45 cfs	0.71 cfs	3.55 cfs	1.75 cfs
5 YEAR	4,546 ft ³	592.19	1.45 cfs	0.87 cfs	3.58 cfs	2.14 cfs
10 YEAR	5,274 ft ³	592.21	1.46 cfs	1.04 cfs	3.59 cfs	2.53 cfs
25 YEAR	6,036 ft ³	592.24	1.47 cfs	1.20 cfs	3.60 cfs	2.93 cfs
50 YEAR	6,840 ft ³	592.27	1.47 cfs	1.30 cfs	3.61 cfs	3.18 cfs
100 YEAR	7,758 ft ³	592.29	1.48 cfs	1.48 cfs	3.62 cfs	3.62 cfs

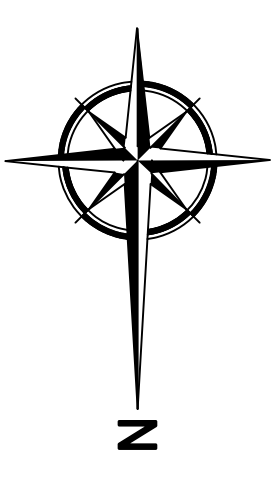

SCALE 1" = 20'

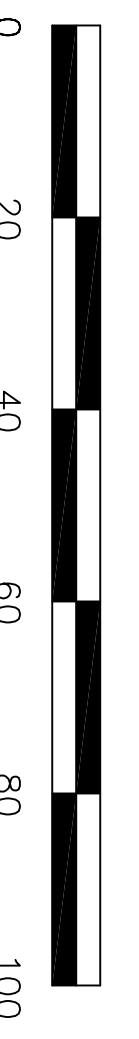

RECORD DRAWINGS
 FEBRUARY 10, 2010



TMBP
 CONSULTING ENGINEERS, INC.
 2201 NORTH AVENUE, SUITE 405
 DALLAS, TEXAS 75201 (214) 871-2502 (214) 871-8718 FAX

CITY OF ROCKWALL, TEXAS
 PUBLIC WORKS DEPARTMENT
 FIRST BAPTIST CHURCH - ROCKWALL, TX
 2008

J. PITT
 RAMTCH

FILE NO. C-3