



FENCE ELEVATION

|    |       |    |       |
|----|-------|----|-------|
| 1  | 96.25 | 13 | 94.25 |
| 2  | 94.75 | 14 | 92.25 |
| 3  | 93.25 | 15 | 90.25 |
| 4  | 91.75 | 16 | 88.25 |
| 5  | 90.25 | 17 | 86.25 |
| 6  | 88.75 | 18 | 84.25 |
| 7  | 87.25 | 19 | 82.25 |
| 8  | 85.75 | 20 | 80.25 |
| 9  | 84.25 | 21 | 78.25 |
| 10 | 82.75 | 22 | 76.25 |
| 11 | 81.25 | 23 | 74.25 |
| 12 | 79.75 | 24 | 72.25 |

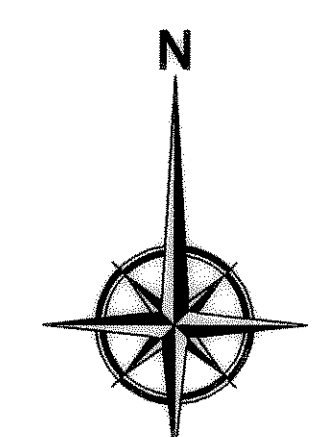

**01 DIMENSION CONTROL PLAN**  
1"=30'

OWNER : FIRST BAPTIST CHURCH  
610 S. GOLIAD ST.  
ROCKWALL, TX. 75087  
PH. 972-771-8459

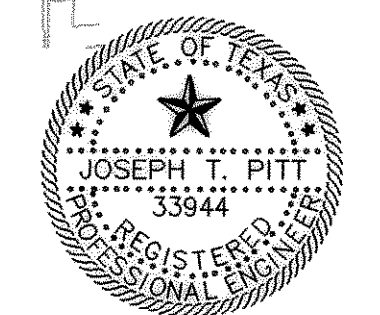

ALL DIMENSIONS ARE TO BACK OF CURB.  
VERIFY ANY DISCREPANCIES WITH ARCHITECT.

REV. 1    APRIL 98

| FIRST BAPTIST CHURCH   |                    |   |  |
|--|--------------------|---|--|
| DEVELOPMENT PLANS - 1998 ADDITION<br>BOYDSTUN AVENUE AT GOLIAD STREET<br>TEXAS   |                    |   |  |
| DATE<br>MAR 98   | JOB NO.<br>97-102  |   |  |
| DRAWN BY<br>H.L.B.   | CHECKED BY<br>J.F. | SHEET NO.<br><b>C-1</b><br>OF 7   |  |
| <b>TMBP</b><br>TEN EYCK • MERBITT • BARNETT • PITT<br>CONSULTING ENGINEERS, INC. |                    | 2301 N. AKARD ST.<br>SUITE 405<br>DALLAS, TEXAS 75201<br>(214) 871-2362<br>FAX (214) 871-8716 |  |
| LOT 1 BLOCK A<br>P.L.T. LEWIS SURVEY A - 225                                     |                    |   |  |