


CONTRACT NO. 14
 8" LATERAL
WHITTLE WAY
 EX. 6" SAN. SWR.
 JUNE 1998 (SEE ADDITION #1557 INSTALLATION)
 CHAIRMAN: A. SLIGER '83

ROGERS WAY
 EX. 6" WATER
 (VERIFY LOCATION)

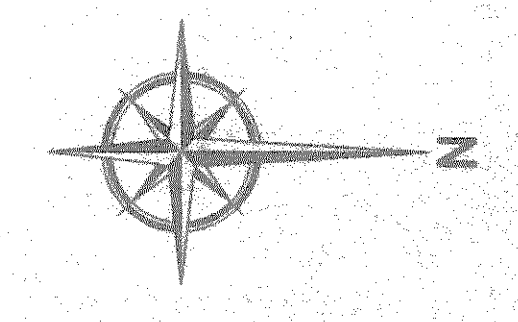

01 PAVING, GRADING AND UTILITY PLAN
 1 of 2

Scale:	Sheet:
Date:	C-2
Job:	4805
File:	EDU-080
Page:	of

PAVING AND GRADING PLAN

FIRST BAPTIST CHURCH ROCKWALL
NEW WORSHIP CENTER
AND CHOIR SUITE
 ROCKWALL, TEXAS

BOOHER/McGEE & ASSOCIATES, INC.
 ARCHITECTS & PLANNERS
 5201 S. WESTMORELAND DALLAS, TEXAS 75237 PH (214) 330-0451 FAX (214) 337-8565

TMBP
 TEN BYCK • MERRITT • BARNETT • PITT
 CONSULTING ENGINEERS INC.
 200 N. HARRIS ST. SUITE 600
 DALLAS, TEXAS 75202
 (214) 871-8882 (214) 871-8704 FAX