
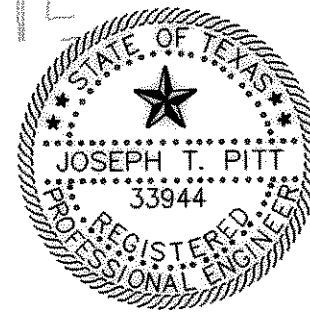


FENCE ELEVATION

1 = 98.20	13 = 94.20
2 = 98.25	14 = 95.20
3 = 94.75	15 = 96.75
4 = 93.75	16 = 97.50
5 = 92.75	17 = 98.25
6 = 91.75	18 = 98.75
7 = 90.50	19 = 99.50
8 = 89.50	20 = 99.75
9 = 88.25	21 = 99.75
10 = 88.00	22 = 99.50
11 = 84.00	23 = 98.00
12 = 84.50	24 = 98.00

01 PAVING / GRADING PLAN

1" = 30'

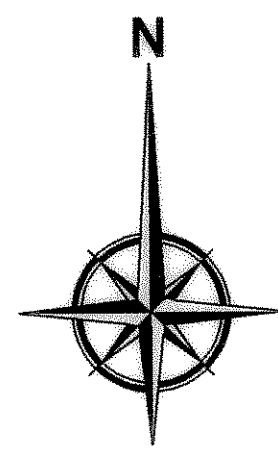

- LEGEND**
- EXISTING FENCE
 - EXISTING LIGHT POLE
 - EXISTING POWER POLE
 - EXISTING GUY WIRE
 - EXISTING TELEPHONE BOX
 - EXISTING MANHOLE
 - EXISTING TREE
 - EXISTING CONTOUR LINE
 - PROPOSED CONTOUR LINE
 - PROPOSED SPOT ELEVATION
 - PROPOSED RETAINING WALL
 - PROPOSED FENCE

BENCHMARKS:
 CITY OF ROCKWALL, TEXAS MONUMENT
 NO. 5 ELEVATION = 578.74.
 ON SITE BENCHMARK, FINISH FLOOR OF EXISTING
 BUILDING, RELATIVE ELEVATION - 100.00 = 595.28
 CITY DATUM.

FIRST BAPTIST CHURCH	
DEVELOPMENT PLANS - 1998 ADDITION BOYDSTUN AVENUE AT GOLLIAD STREET ROCKWALL, TEXAS	
DATE MAR 98	JOB NO. 97-102
DRAWN BY HLB	SHEET NO.
CHECKED BY JP	C-2 of 7

TMBP
 TEN EYCK • MERRITT • BARNETT • PITT
 CONSULTING ENGINEERS, INC.
 2301 N. ALABAMA ST.
 SUITE 405
 DALLAS, TEXAS 75201
 (214) 871-2302
 FAX (214) 871-8716

GOLLIAD STREET - STATE HWY. 205

EXIST'G P. R.