


PLAN VIEW

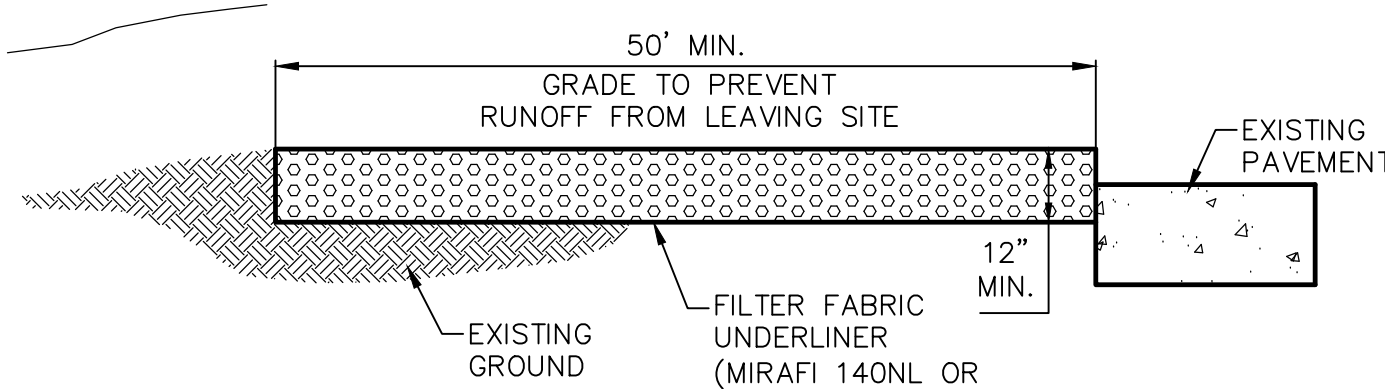


PROFILE


NOTE: GRADE TO DRAIN AWAY FROM STABILIZATION AND STREET PAVED SURFACE. DRAINAGE MUST FLOW AWAY FROM ENTRANCE

1 STABILIZED CONSTRUCTION ENTRANCE

NOT TO SCALE

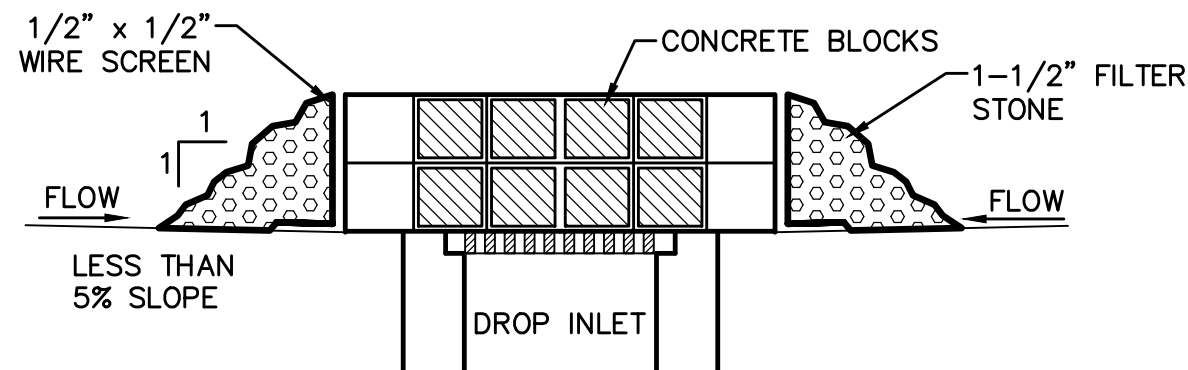


SECTION A-A

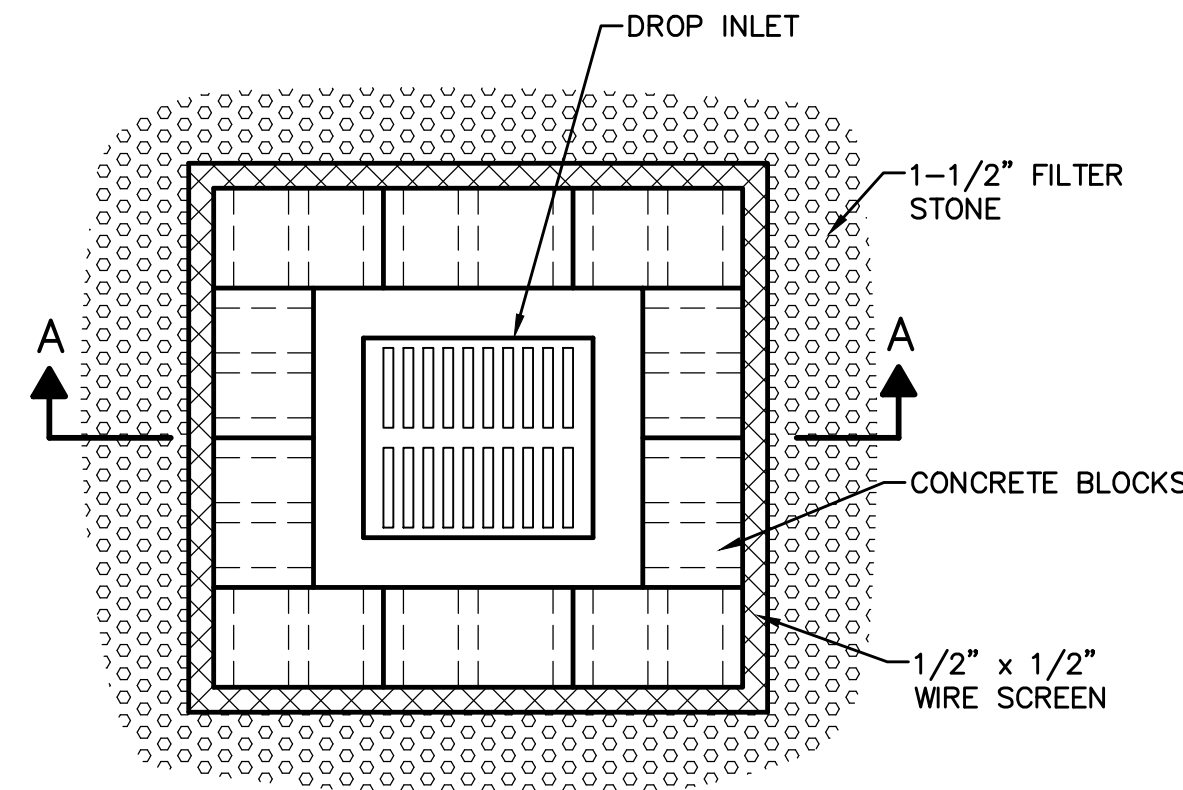


PLAN VIEW

2 DROP INLET PROTECTION

NOT TO SCALE

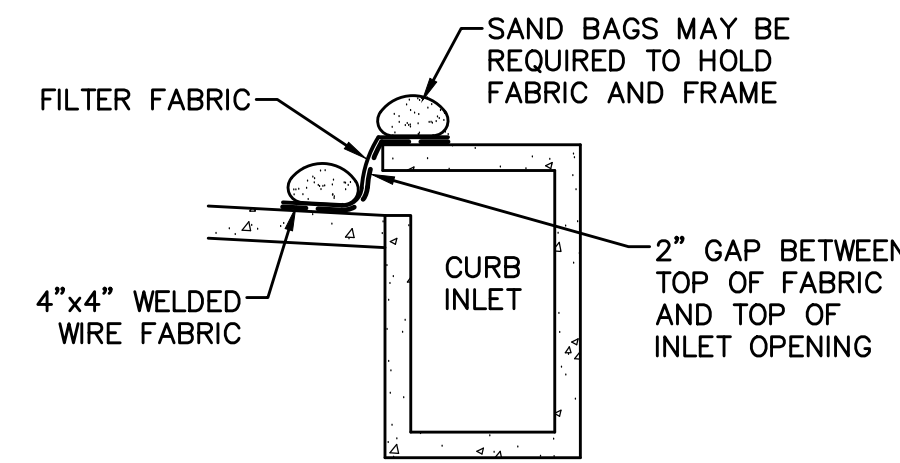


CROSS SECTION

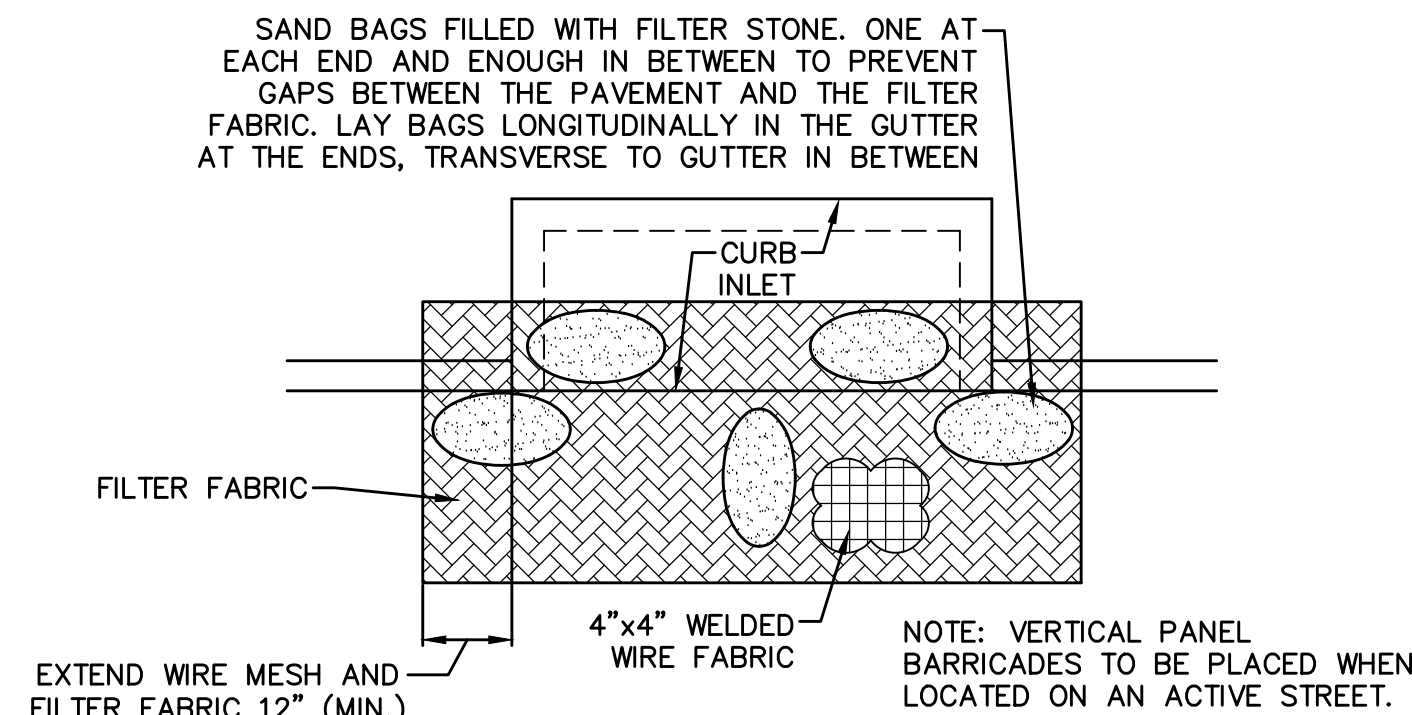


PLAN VIEW

3 CURB INLET PROTECTION

NOT TO SCALE

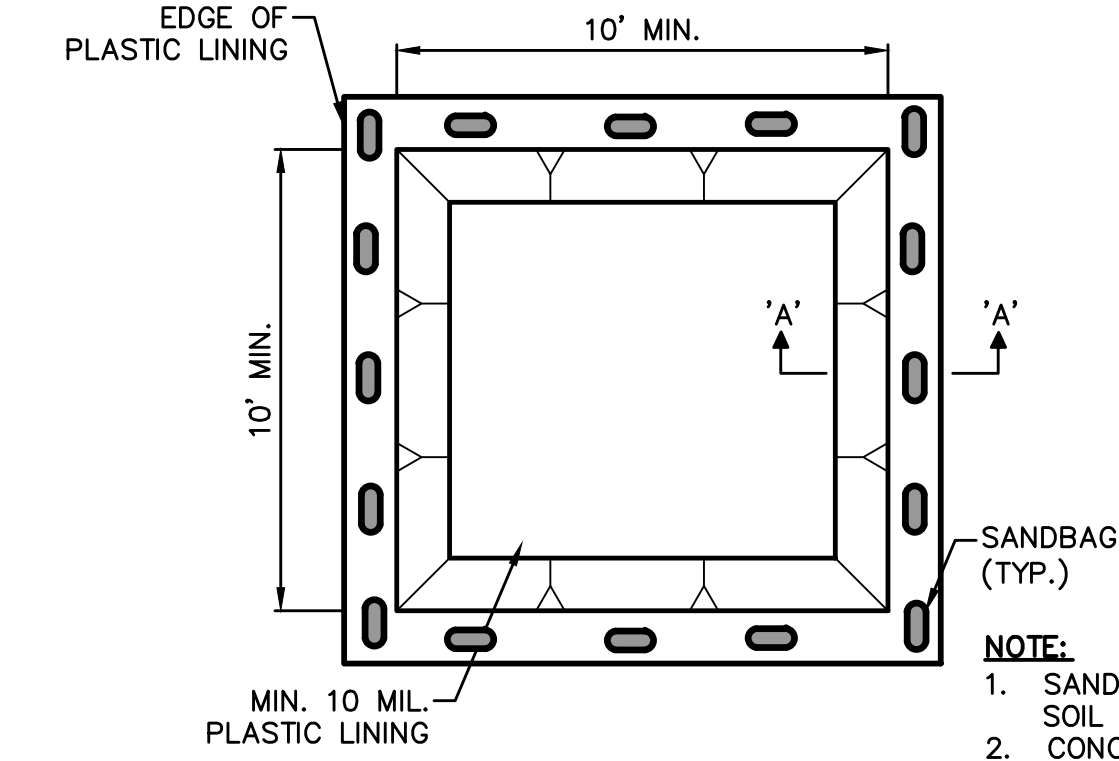

PLAN VIEW

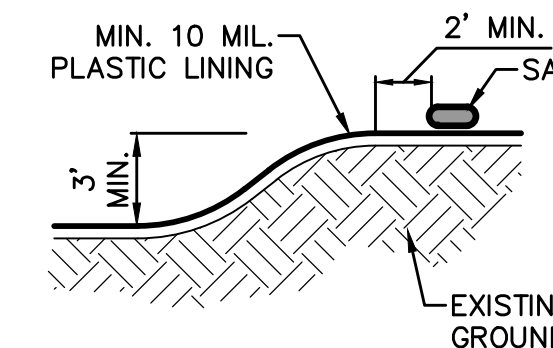


SECTION A-A


4 CONCRETE WASHOUT AREA

NOT TO SCALE

- NOTE:
1. SANDBAGS MAY BE REPLACED BY A SOIL BERM TO ANCHOR PLASTIC LINING.
 2. CONCRETE WASHOUT AREA TO BE CHECKED REGULARLY FOR REPAIRS.
 3. REGULARLY REMOVE CONCRETE WASTE TO PREVENT OVERFLOWING.
 4. PROVIDE MINIMUM 6 CF OF CONTAINMENT VOLUME FOR EVERY 10 CY OF CONCRETE PLACED. PROVIDE MINIMUM 1' FREEBOARD ABOVE CONTAINMENT VOLUME.

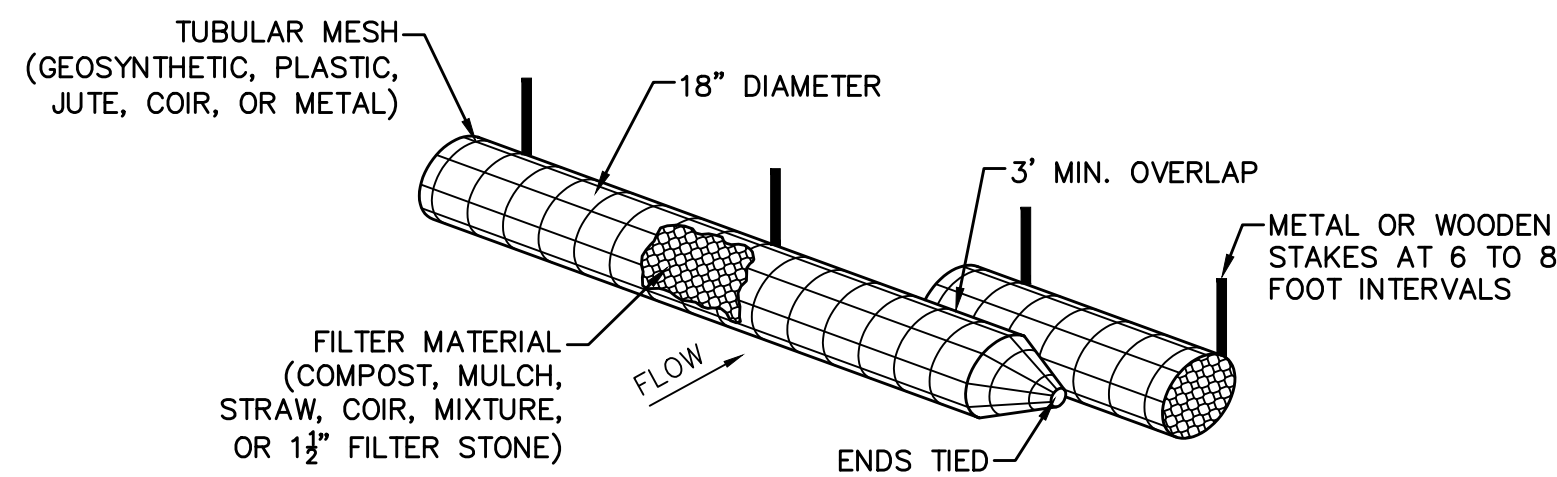


FILTER TUBE DETAIL

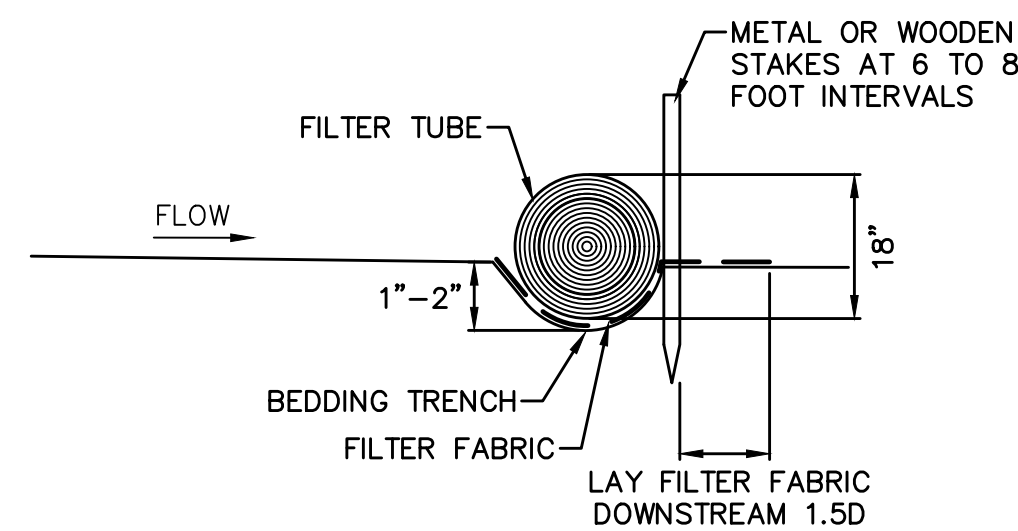


SECTION A-A

5 FILTER TUBE

NOT TO SCALE

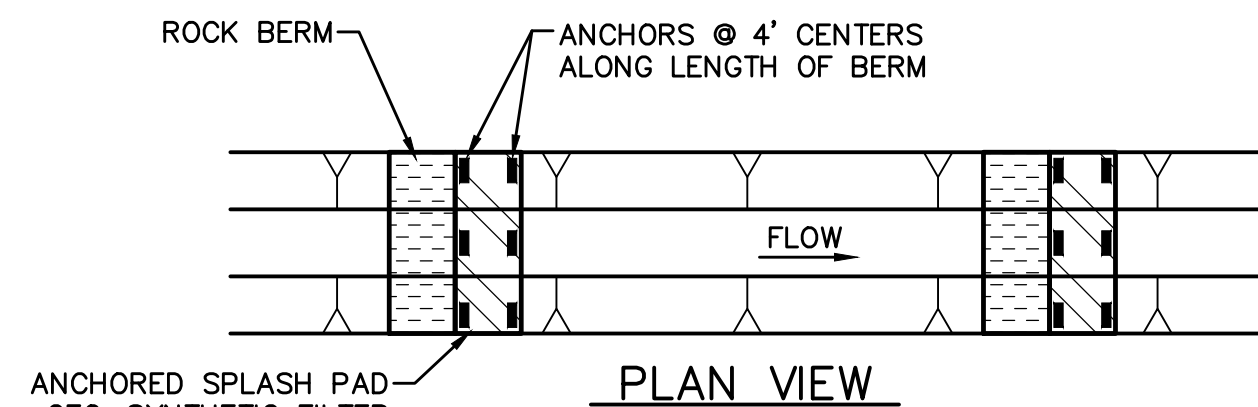


PLAN VIEW

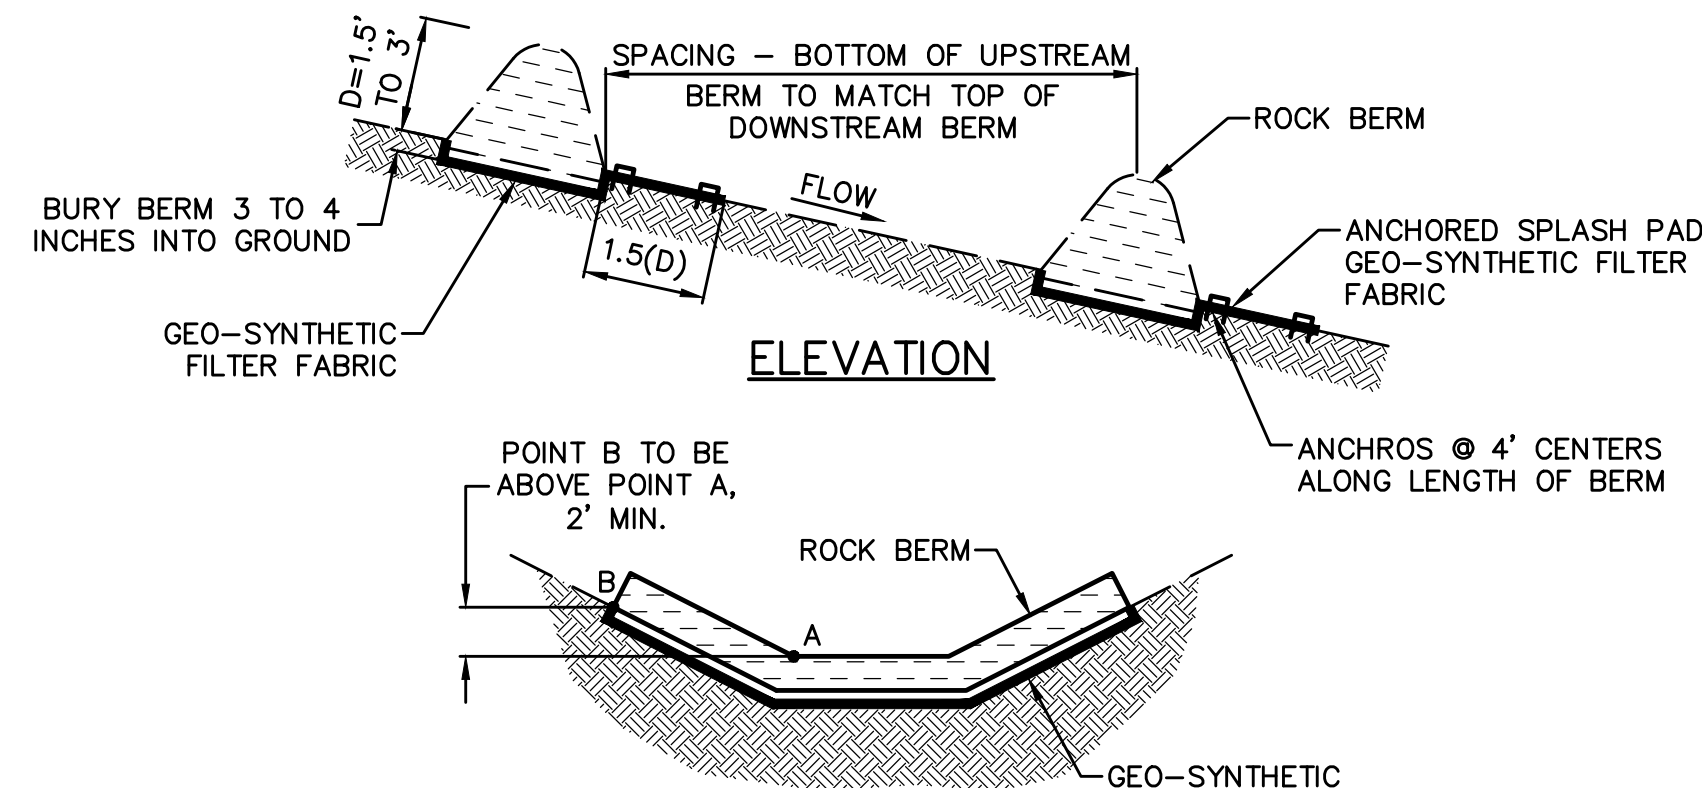


SECTION

6 CHECK DAMS

NOT TO SCALE

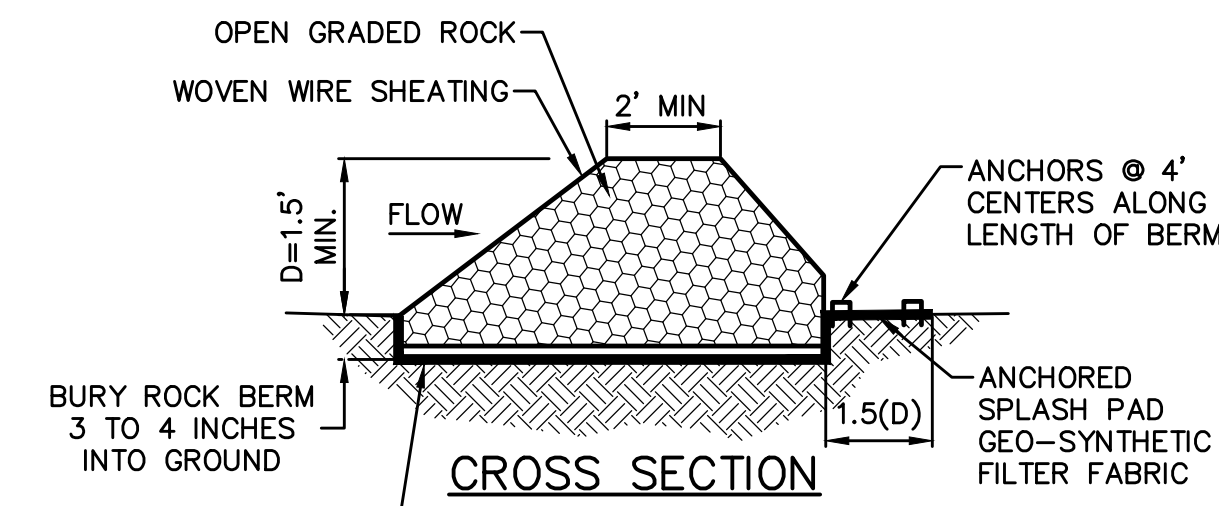

CROSS SECTION

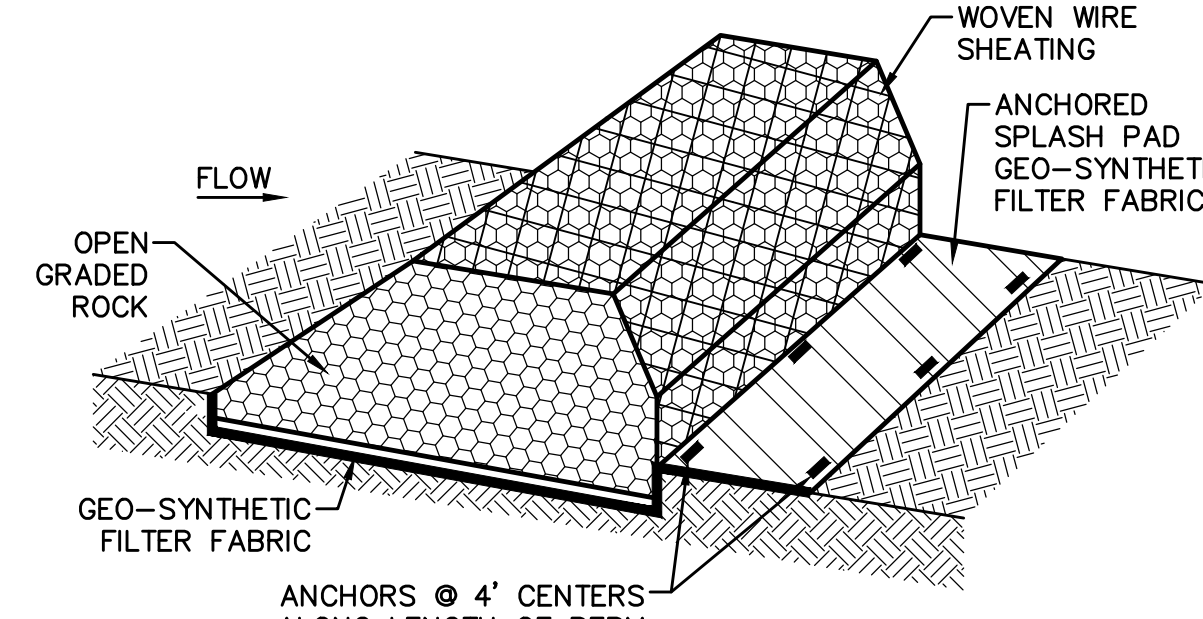


ISOMETRIC PLAN VIEW

7 ROCK BERM

NOT TO SCALE

- NOTES:
1. USE ONLY OPEN GRADED ROCK 4-8 INCHES IN DIAMETER FOR STREAM FLOW CONDITION. USE OPEN GRADED ROCK 3-5 INCHES IN DIAMETER FOR OTHER CONDITIONS.
 2. ROCK BERM SHALL BE SECURED WITH A WOVEN WIRE SHEATHING HAVING A MAX. OPENING OF 1 INCH AND A MIN. WIRE SIZE OF 20 GAUGE AND SHALL BE BURIED IN A TRENCH APPROX. 3 TO 4 INCHES DEEP.
 3. THE ROCK BERM SHALL BE INSPECTED WEEKLY OR AFTER EACH RAIN EVENT AND SHALL BE REPLACED WHEN THE STRUCTURE CEASED TO FUNCTION AS INTENDED DUE TO SILT ACCUMULATION AMONG THE ROCKS, WASH OUT, CONSTRUCTION TRAFFIC DAMAGE, ETC.
 4. WHEN SILT REACHES A DEPTH EQUAL TO ONE-THIRD OF THE HEIGHT OF THE BERM OR ONE FOOT, WHICHEVER IS LESS, THE SILT SHALL BE REMOVED AND DISPOSED OF PROPERLY.
 5. WHEN THE SITE IS COMPLETELY STABILIZED, THE BERM AND ACCUMULATED SILT SHALL BE REMOVED AND DISPOSED OF IN AN APPROVED MANNER.
 6. ROCK BERM SHOULD BE USED AS CHECK DAMS FOR CONCENTRATED FLOW AND ARE NOT INTENDED FOR USE IN PERIMETER PROTECTION.

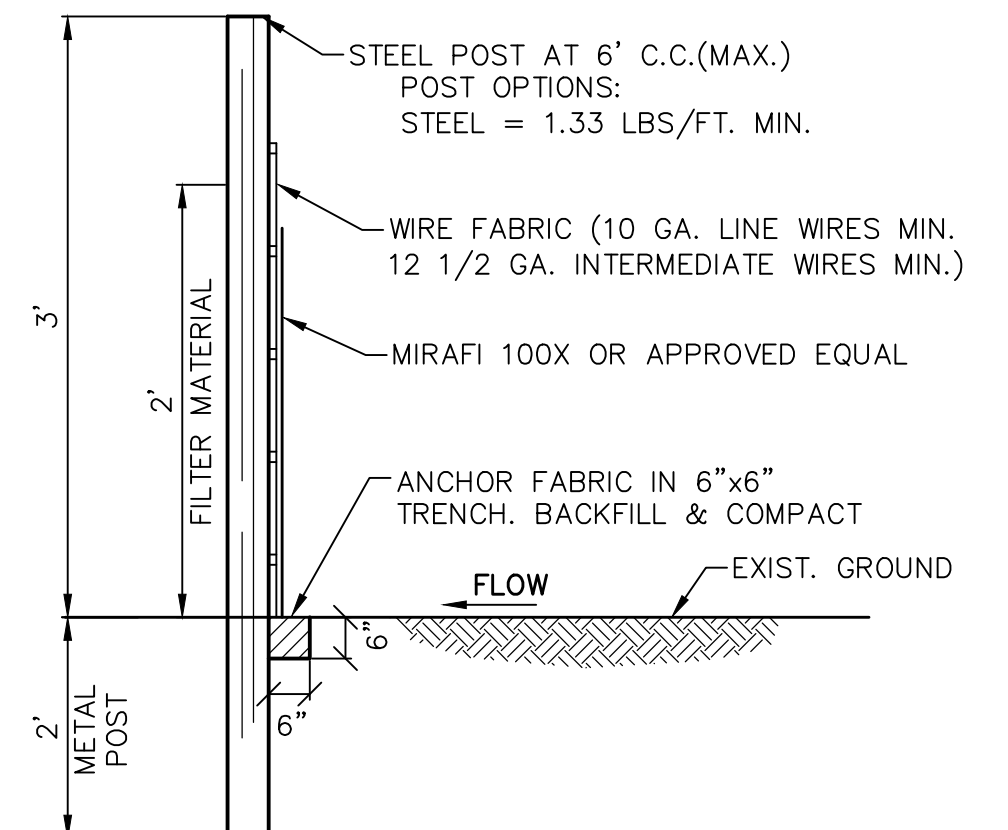

8 SILT FENCE

NOT TO SCALE

RECORD DRAWING

THE SIGNED AND SEALED CONSTRUCTION DOCUMENT HAS BEEN REVISED TO REFLECT CONSTRUCTION RECORDS MAINTAINED AND PROVIDED BY THE CONTRACTOR FOR THIS PROJECT. THE INFORMATION SHOWN ON THIS RECORD DRAWING, WHICH WAS PROVIDED BY THE CONTRACTOR, OR OTHERS NOT ASSOCIATED WITH THE DESIGN ENGINEER, CANNOT BE VERIFIED FOR ACCURACY OR COMPLETENESS. PACHECO KOCH SHALL ASSUME NO LIABILITY FOR ANY CHANGES MADE DURING CONSTRUCTION THAT WERE NOT SPECIFICALLY APPROVED BY THE ENGINEER PRIOR TO CONSTRUCTION. THE SEALED CONSTRUCTION DRAWINGS ARE ON FILE AT THE OFFICES OF PACHECO KOCH.

ATTESTED BY: STEVEN M. HEILBRUN, PE
 SIGNATURE: *Steven M. Heilbrun*
 ENGINEER OF RECORD: STEVEN M. HEILBRUN, PE
 CONTRACTOR: THE CHRISTMAN COMPANY
 DATE REVISED: 07/21/2023

OWNER:
 GARY HANCOCK
 FIRST UNITED METHODIST ROCKWALL
 1200 EAST YELLOW JACKET LANE
 ROCKWALL, TEXAS 75087

NO.	DATE	REVISION
	07/21/2023	RECORD DRAWING

Pacheco Koch 7557 RAMBLER ROAD, SUITE 1400
 DALLAS, TX 75231 972.235.3031
 TX REG. ENGINEERING FIRM F-469
 TX REG. SURVEYING FIRM LS-10008000

EROSION CONTROL DETAILS
FIRST UNITED METHODIST CHURCH
YELLOW JACKET LANE & TOWNSEND ROAD
LOT 7, BLOCK 1
CITY OF ROCKWALL, ROCKWALL COUNTY, TEXAS

DESIGN	DRAWN	DATE	SCALE	NOTES	FILE	NO.
SMH	GAC	APR 2022	N.T.S.			C8.2

LAND USE: CHURCH