


SITE CONSTRUCTION PLANS FOR FIRST UNITED METHODIST CHURCH of ROCKWALL

PHASE 2 GRADING, PAVING, DRAINAGE, WATER, & SANITARY SEWER

SHEET INDEX	
NO.	DESCRIPTION
	REPLAT (4 Sheets) SITE PLAN
1	DIMENSIONAL CONTROL
2	DEMOLITION PLAN
3	GRADING/PAVING PLAN
4	DRAINAGE AREA MAP
5	STORM SEWER PLAN
5A	STORM SEWER PROFILE
6	WATER & SEWER PLAN/PROFILE
7	NOTES & DETAILS
8	EROSION CONTROL PLAN
9	EROSION CONTROL DETAILS

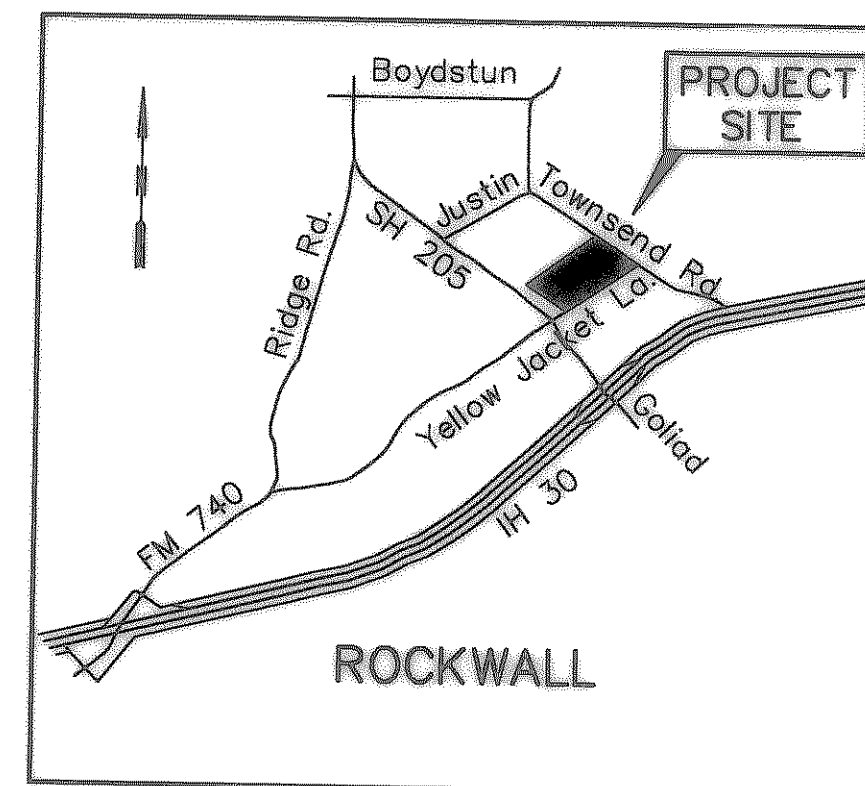

LOCATION MAP
1" = 0.5 miles

FIRST UNITED METHODIST CHURCH of ROCKWALL


RECORD DRAWINGS
5-24-07

DEVELOPED BY:
**FIRST UNITED METHODIST CHURCH
of ROCKWALL**

1200 E. Yellow Jacket Lane
Rockwall, Texas 75087
(972) 771-5500

SPECIFICATIONS:

Current NCTCOG Standard Specifications for
Public Works Construction and City of Rockwall
Specifications and Standards.

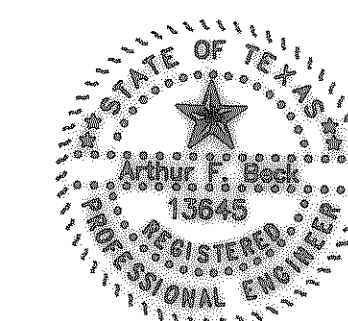

Arthur D. Beck

BSM Consulting
Civil
Engineers

4111 East U.S. Hwy. 80, Suite 405
Mesquite, Texas 75150
(972) 681-4680 • FAX 681-4696 • bsm2@swbell.net

July 11, 2006