


Lot 2, Block 1
13.2000 Ac.

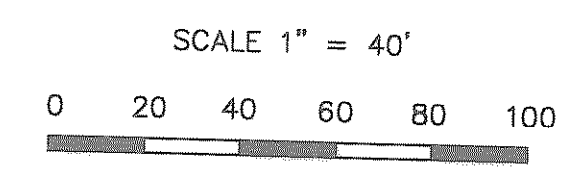

10'x10'
Trans
Pad

PROPOSED PHASE 2
EDUCATION BUILDING
FF = 585.00

Sawcut and remove
Concrete Pvmnt. and
Sidewalk.

Sawcut and remove
Concrete Pvmnt. for
Water Main.

Lot 1, Block 1
6.5473 Ac.
EXISTING PARKING LOT

Remove Concrete Sidewalk

EXISTING BUILDING
FF = 584.04

Sawcut and remove
Concrete Curb.

EXISTING PARKING LOT

DETENTION POND "B"

DETENTION POND "C"

DETENTION
POND "A"

TOWNSEND ROAD

YELLOW JACKET LANE

NOTES


- 1. Sawcut shall be full depth along removal line. Removal line for curb removal shall be within 12 inches of face of curb.
- 2. All removal items shall be removed from site and deposited at city approved landfill.

RECORD DRAWINGS
5-24-07

2
9

SPECIFICATIONS

Current NCTCOG Standard Specifications for Public Works Construction and City of Rockwall Specifications and Standards.

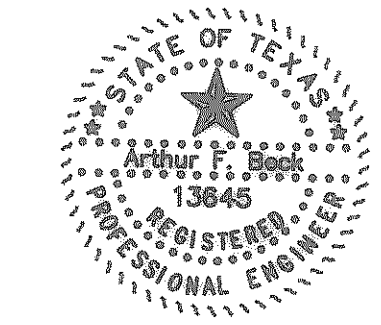

Arthur D. Beck

July 11, 2006 PHASE 2

DEMOLITION PLAN						
FIRST UNITED METHODIST CHURCH, ROCKWALL						
CITY OF ROCKWALL, TEXAS						
F&S PARTNERS and BSM ENGINEERS						
DESIGN	DRAWN	DATE	SCALE	NOTES	FILE	NO
F&S	BSM	4-06		BSM		552