


Lot 2, Block 1
13.2000 Ac.

Lot 1, Block 1
6.5473 Ac.


SPECIFICATIONS
Current NCTCOG Standard Specifications for Public Works Construction and City of Rockwall Specifications and Standards.

New Flume
Exist. Flume
#4 bars at 24\"/>

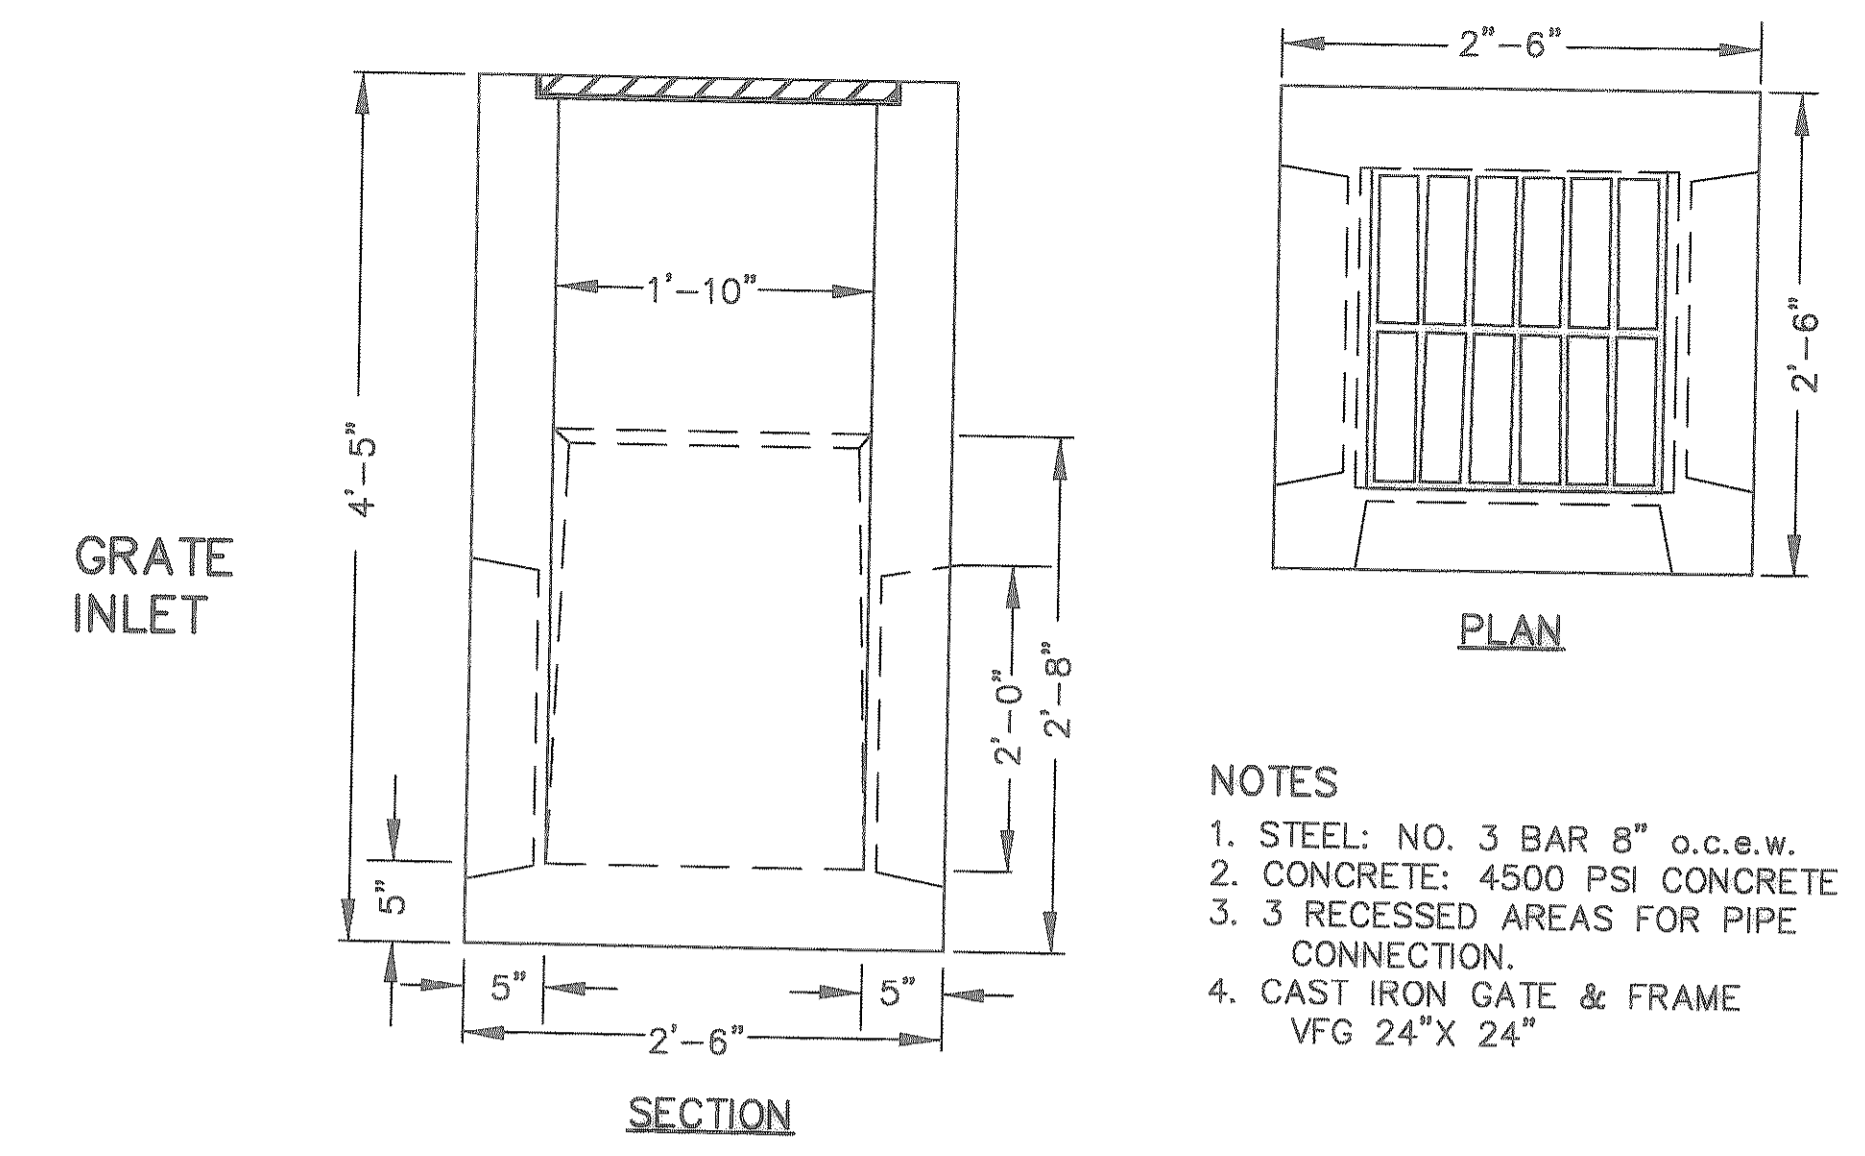


BROOKS 22-22-CB
22" X 22" X 48" CATCH BASIN
24" X 24" CAST IRON GRATE

- NOTES**
1. STEEL: NO. 3 BAR 8" o.c.e.w.
 2. CONCRETE: 4500 PSI CONCRETE
 3. 3 RECESSED AREAS FOR PIPE CONNECTION.
 4. CAST IRON GATE & FRAME VFG 24" X 24"

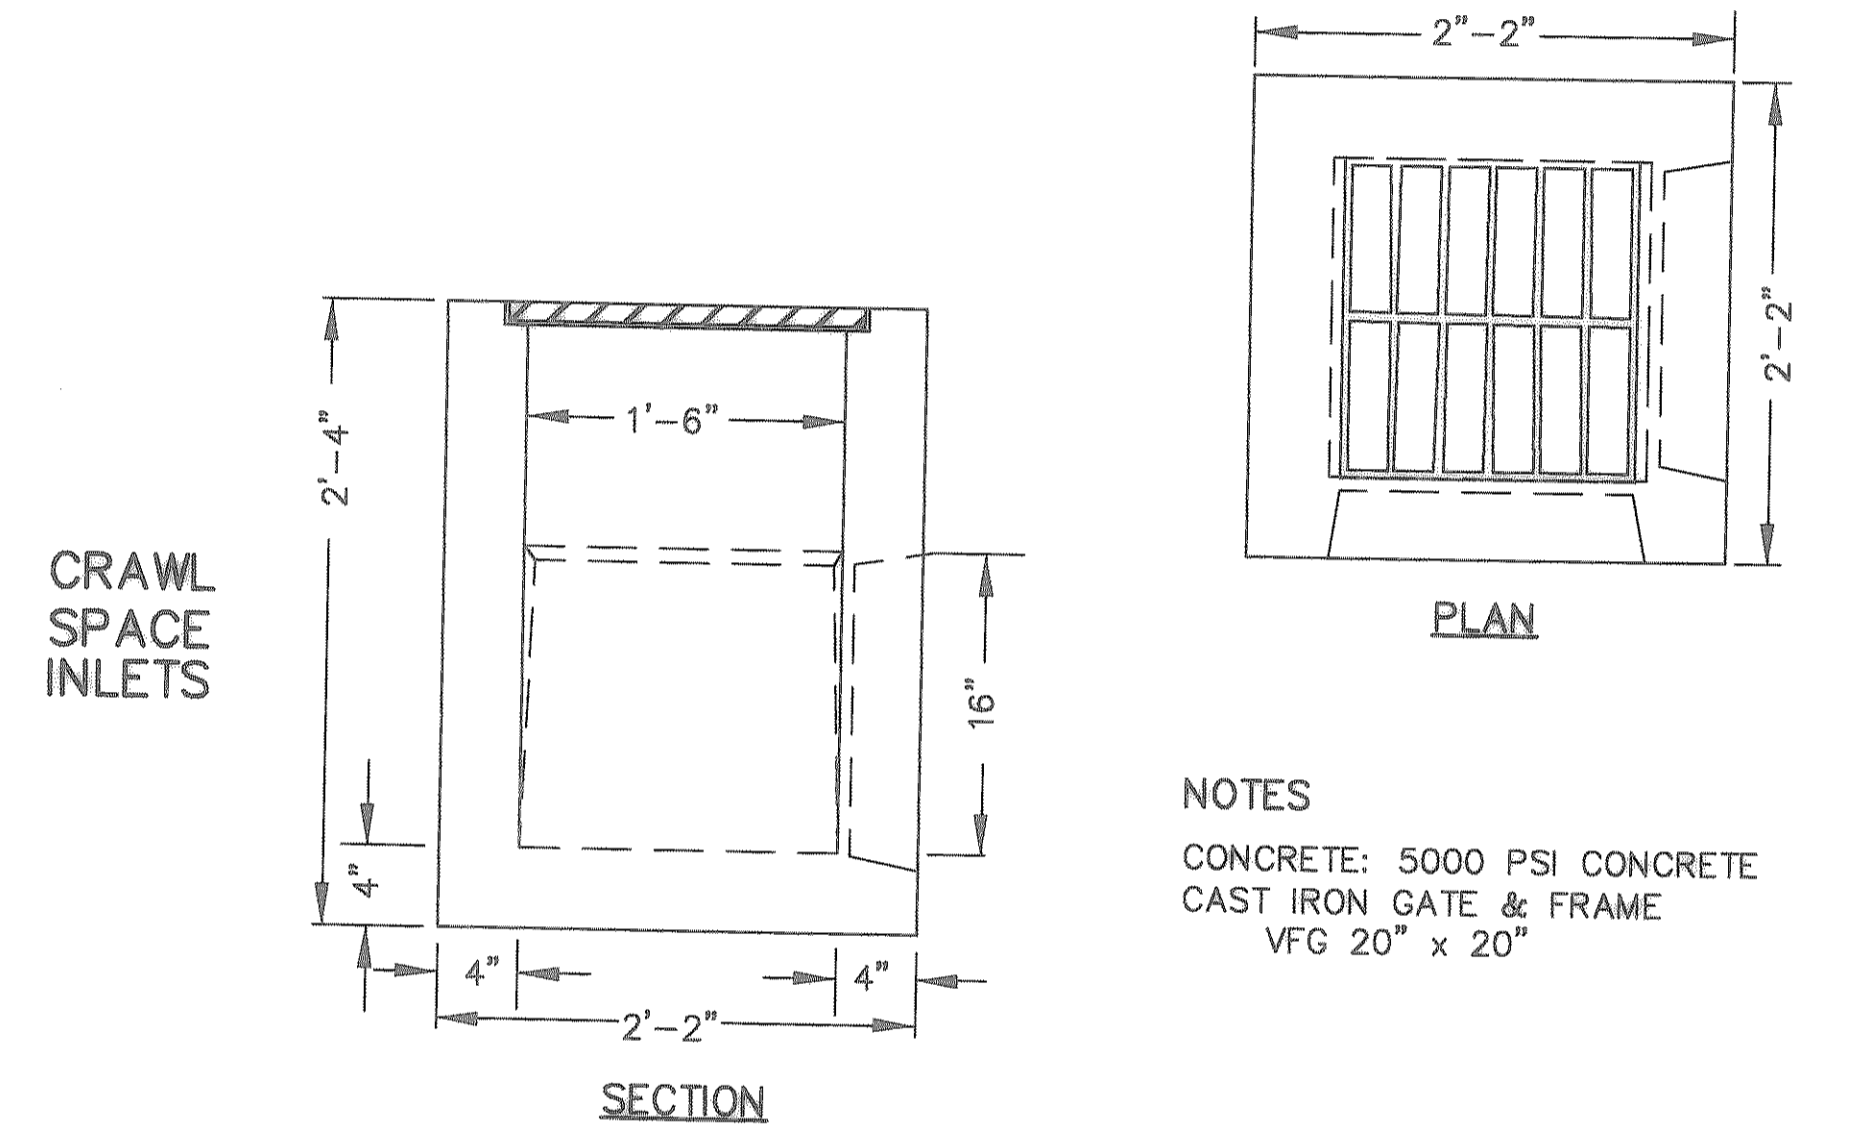

BROOKS 18-18-CB
18" X 18" X 24" CATCH BASIN
20" X 20" CAST IRON GRATE

- NOTES**
1. CONCRETE: 5000 PSI CONCRETE
 2. CAST IRON GATE & FRAME VFG 20" X 20"

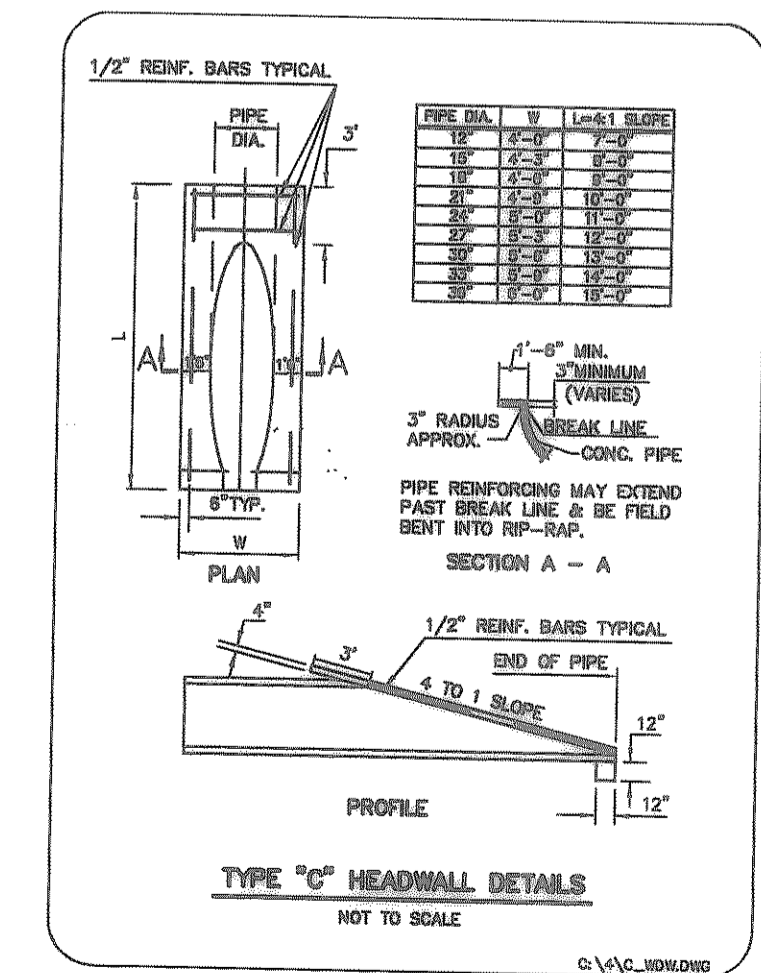

- NOTES**
- All storm drains are considered a "Private System".
 - See Sheet 5A/9 for storm sewer profiles.
 - Provide 45' bends where shown.
 - Adjust inlet locations as necessary so that center of inlet matches roof drain down spout.
 - Inlets are to be placed against building foundation.
 - Place concrete fill in bottom of inlets to match flow line.

RECORD DRAWINGS
5-24-07

5
9

July 11, 2006 **PHASE 2**

STORM SEWER PLAN
FIRST UNITED METHODIST CHURCH,
ROCKWALL
CITY OF ROCKWALL, TEXAS
F&S PARTNERS and BSM ENGINEERS

| DESIGN | DRAWN | DATE | SCALE | NOTES | FILE | NO |
|--------|-------|------|-------|-------|------|-----|
| F&S | BSM | 4-06 | | BSM | | 552 |

