


SITE CONSTRUCTION PLANS FOR FIRST UNITED METHODIST CHURCH of ROCKWALL

GRADING, PAVING, DRAINAGE, WATER, & SANITARY SEWER

SHEET INDEX

NO.	DESCRIPTION
	FINAL PLAT (4 Sheets) SITE PLAN
1	DIMENSIONAL CONTROL
2	GRADING/PAVING PLAN
3	DRAINAGE AREA MAP
4	STORM SEWER PLAN
5	CULVERT DETAILS
6	STORM SEWER DETAILS
7	WATER & SEWER PLAN
8	SANITARY SEWER PLAN/PROFILE
9	WATER AND SEWER DETAILS
10	EROSION CONTROL PLAN
11	EROSION CONTROL DETAILS

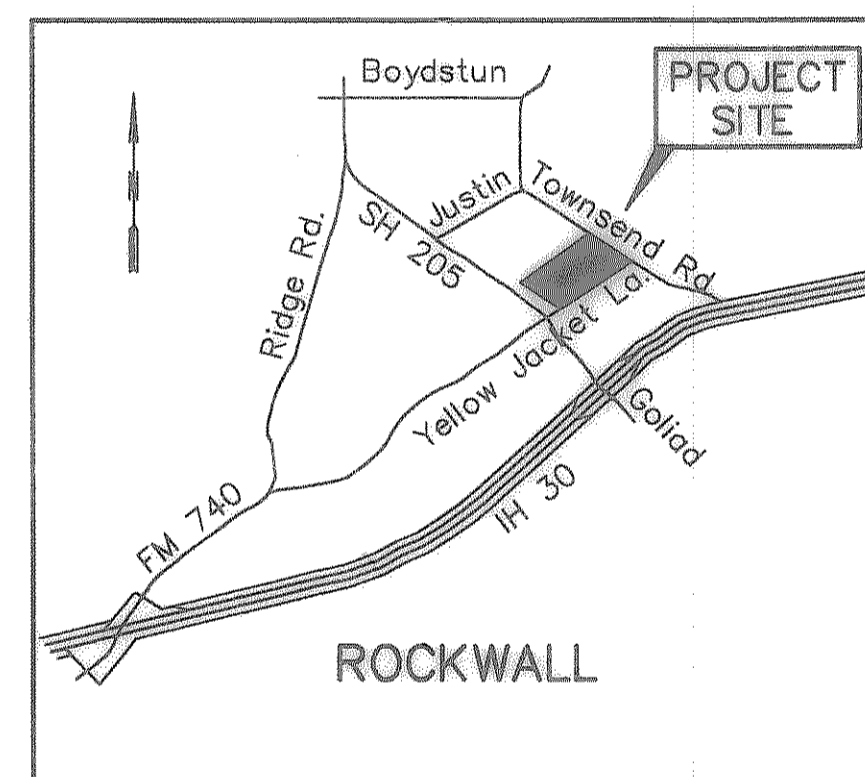

LOCATION MAP
1" = 0.5 miles


DEVELOPED BY:

**FIRST UNITED METHODIST CHURCH
of ROCKWALL**

1408 South Goliad
Rockwall, Texas 75087
(972) 771-5500

SPECIFICATIONS:

Current NCTCOG Standard Specifications for
Public Works Construction and City of Rockwall
Specifications and Standards.

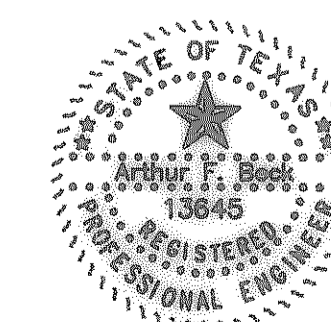

Arthur D. Seeb

5-20-03
AS BUILT

BSM	<small>Consulting Civil Engineers</small>
<small>4111 East U.S. Hwy. 80, Suite 405 Mesquite, Texas 75150 (972) 681-4680 • FAX 681-4696 • bsm2@swbell.net</small>	

November 19, 2001

FIRST UNITED METHODIST CHURCH of ROCKWALL