

C:\MISC\FUM_rock\FPlat4

STATE OF TEXAS §
COUNTY OF ROCKWALL §

Before me, the undersigned authority, on this day personally appeared _____, known to me to be the person whose name is subscribed to the foregoing instrument, and acknowledged to me that he executed the same for the purpose and consideration herein stated.

Given upon my hand and seal of office this _____ day of _____, 2001.

Notary Public in and for the State of Texas My commission Expires: _____

Signature of Party with Mortgage or Lien Interest

STATE OF TEXAS §
COUNTY OF ROCKWALL §

Before me, the undersigned authority, on this day personally appeared _____, known to me to be the person whose name is subscribed to the foregoing instrument, and acknowledged to me that he executed the same for the purpose and consideration herein stated.

Given upon my hand and seal of office this _____ day of _____, 2001.

Notary Public in and for the State of Texas My commission Expires: _____

NOTE: It shall be the policy of the City of Rockwall to withhold issuing building permits until all streets, water, sewer and storm drainage systems have been accepted by the City. The approval of a plat by the City does not constitute any representation, assurance or guarantee that any building within such plat shall be approved, authorized or permit therefore issued, nor shall approval constitute any representation, assurance or guarantee by the City of any adequacy and availability for water for personal use and fire protection within such plat, as required under Ordinance 83-54.

SURVEYOR'S CERTIFICATE

NOW, THEREFORE KNOW ALL MEN BY THESE PRESENTS:

THAT I, Arthur F. Beck, do hereby certify that I prepared this plat from an actual and accurate survey of the land, and that the corner monuments shown thereon were properly placed under my personal supervision.

Arthur F. Beck, R.P.L.S. No 2130

STATE OF TEXAS §
COUNTY OF ROCKWALL §

This instrument was acknowledged before me on the _____ day of _____, 2001.

Notary Public in and for the State of Texas My Commission Expires: _____

afb:2
FUM_Rock.FN

RECOMMENDED FOR FINAL APPROVAL

Planning and Zoning Commission _____ Date _____

APPROVED

I hereby certify that the above and foregoing plat of an addition to the City of Rockwall, Texas, was approved by the City Council of the City of Rockwall on the _____ day of _____, 2001

This approval shall be invalid unless the approved plat for such addition is recorded in the office of the County Clerk of Rockwall, County, Texas, within one hundred twenty (120) days from said date of final approval.

Said addition shall be subject to all the requirements of the Subdivision Regulations of the City of Rockwall.

WITNESS OUR HANDS, this _____ day of _____, 2001.


Mayor, City of Rockwall _____ City Secretary, City of Rockwall _____

ENGINEER

BSM ENGINEERS, INC.
4111 E. US HIGHWAY 80, SUITE 405
MESQUITE, TEXAS 75150
(972) 681-4680

OWNER
FIRST UNITED METHODIST CHURCH of ROCKWALL
1408 South Goliad
Rockwall, Texas 75087
(972) 771-5500

5-20-03
AS BUILT
FINAL PLAT
BLOCK 1, LOTS 1 and 2
FIRST UNITED METHODIST CHURCH ADDITION
B. J. T. LEWIS SURVEY, ABSTRACT 225
City of Rockwall, Rockwall County, Texas

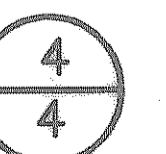

November 19, 2001