
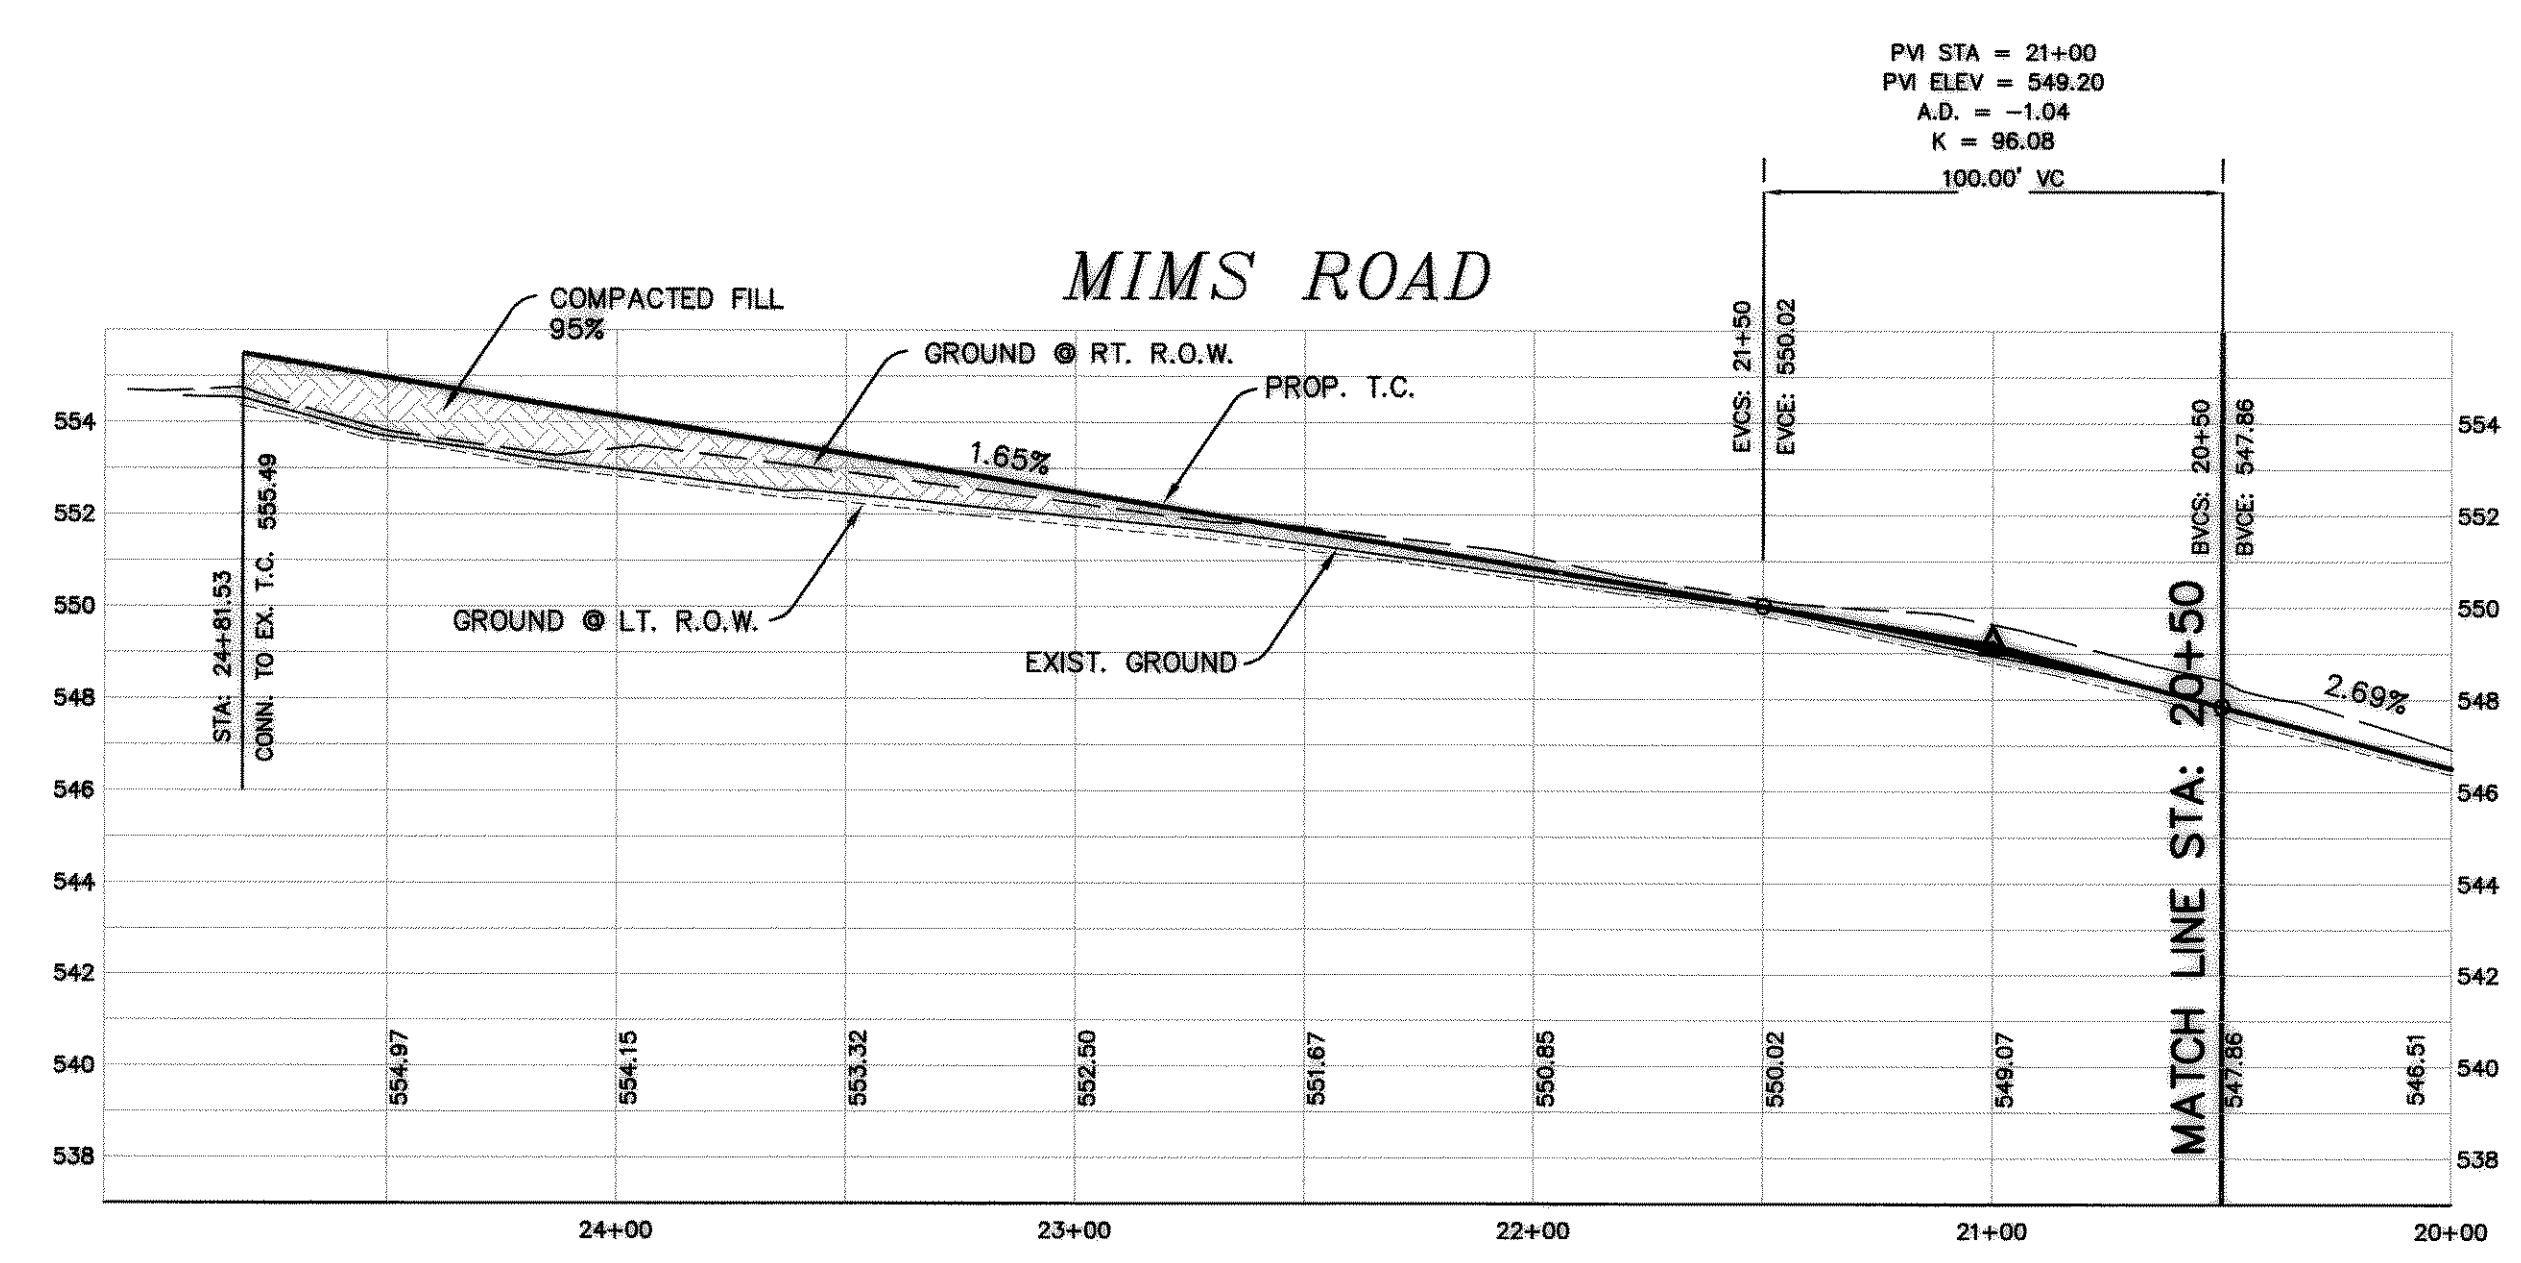
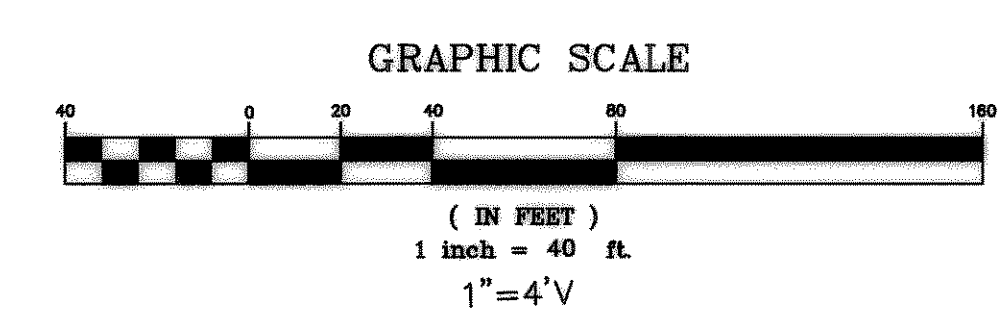


RALPH HALL PKWY.

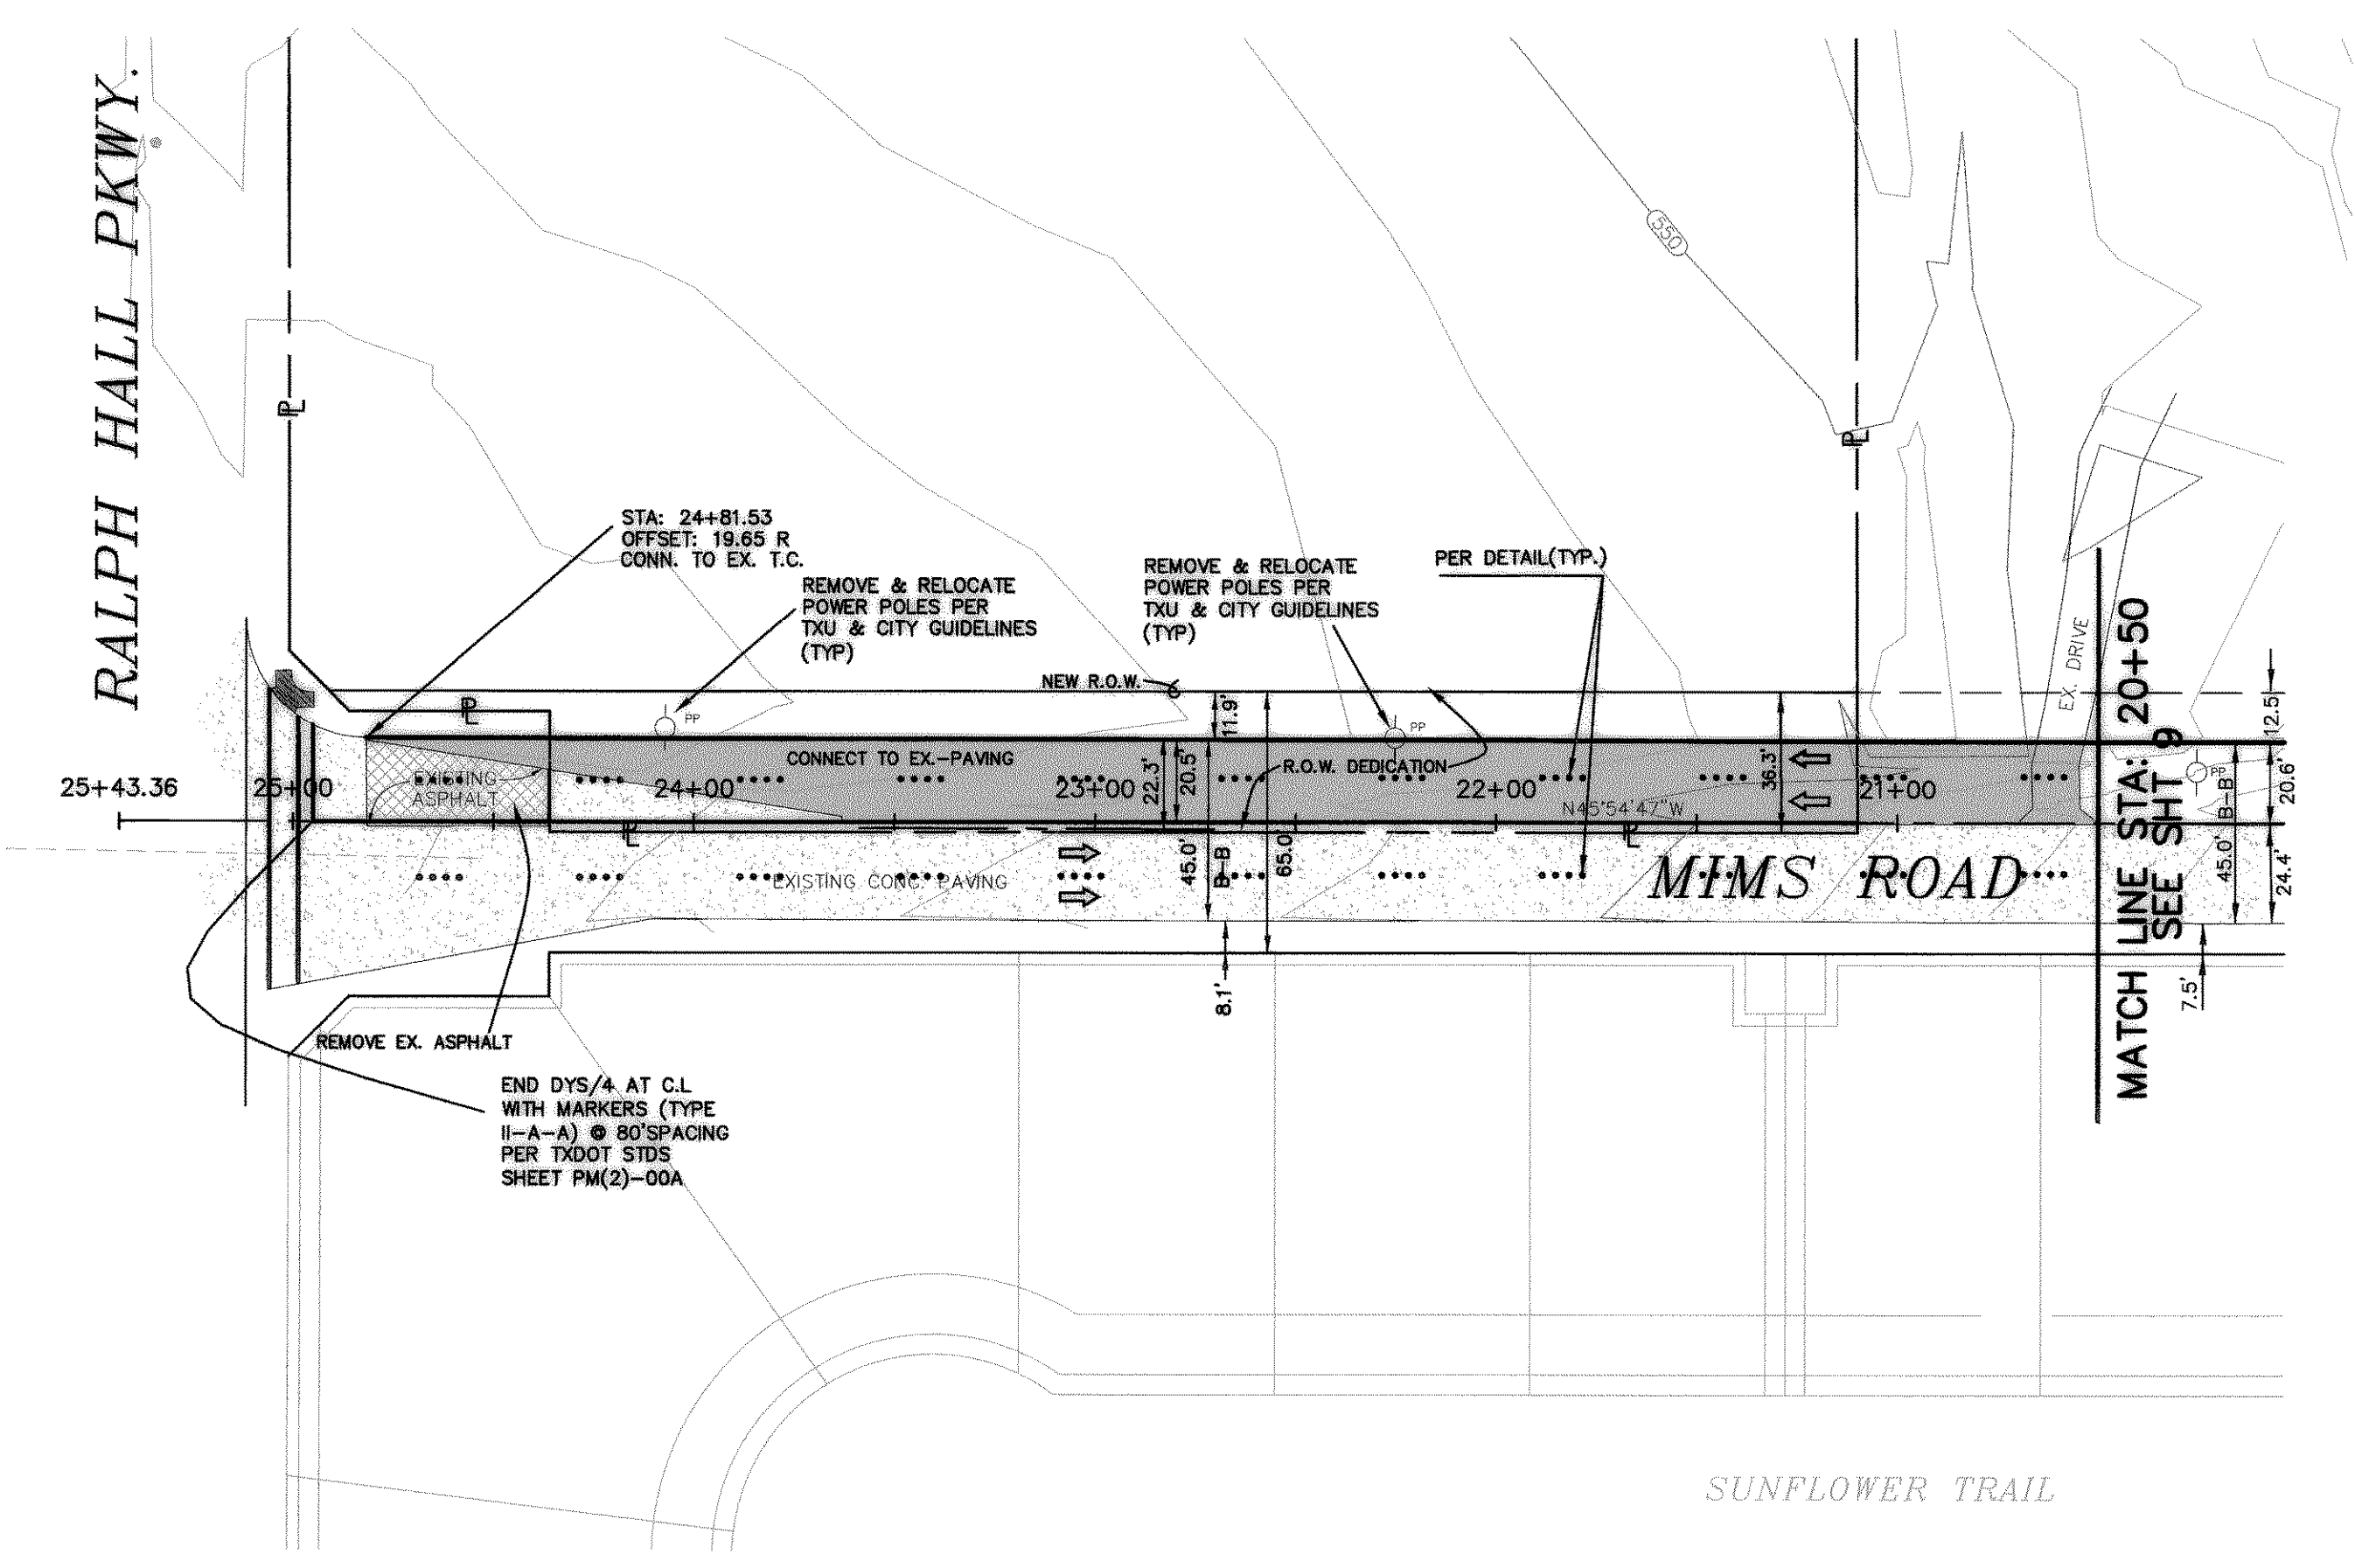

**STRIPING LEGEND**

- SWS/4 = SINGLE WHITE SOLID LINE 4" WIDE
- SWS/6 = SINGLE WHITE SOLID LINE 6" WIDE
- SWS/12 = SINGLE WHITE SOLID LINE 12" WIDE
- SWS/24 = SINGLE WHITE SOLID LINE 24" WIDE
- SWB/4 = SINGLE WHITE BROKEN LINE 4" WIDE  
10' LINE 30' GAP
- DYS/4 = DOUBLE YELLOW SOLID LINE 4" WIDE

↓ DIRECTION OF FLOW OF TRAFFIC


REVISED TO CONFORM TO CONSTRUCTION RECORDS.

*W. Douglas* DATE: 10/12/06

**BENCHMARKS.**

B.M. = SQUARE CUT TOP OF CURB CENTER OF CURB  
INLET N. SIDE OF RALPH HALL PKWY. & 325' EAST OF  
MIMS ROAD (45' W. OF W. PROPERTY LINE) ELEV = 549.34

B.M. = SQUARE CUT TOP OF CURB CENTER OF CURB  
INLET N. SIDE OF RALPH HALL PKWY. & 153' EAST OF  
MIMS ROAD (65' W. OF E. PROPERTY LINE) ELEV = 540.41

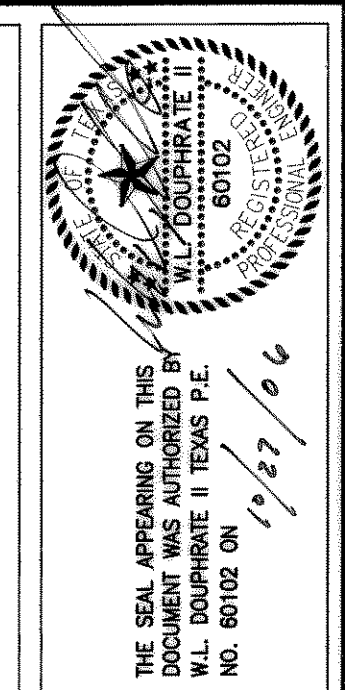

**DOUPHRADE & ASSOCIATES, INC.**

ENGINEERING - PROJECT MANAGEMENT - SURVEYING

2235 RIDGE RD., # 200 ROCKWALL, TEXAS 75087

PHONE: (972)771-9004 FAX: (972)771-9005

**PAVING PLAN & PROFILE**

MIMS ROAD STA: 20+50 - 25+43.36

FLAGSTONE ESTATES

CITY OF ROCKWALL, ROCKWALL COUNTY, TEXAS

REVISION	
CHECKED	SAH
DRAWN	DLB
DATE	3/05
PROJECT	014-PV-2A
	9A
	OF