


REVISED TO CONFORM TO CONSTRUCTION RECORDS.
 DATE: 12/23/16

BENCHMARKS:
 B.M. = SQUARE CUT TOP OF CURB CENTER OF CURB INLET N. SIDE OF RALPH HALL PKWY. & 325' EAST OF MIMS ROAD (45' W. OF W. PROPERTY LINE) ELEV = 549.34
 B.M. = SQUARE CUT TOP OF CURB CENTER OF CURB INLET N. SIDE OF RALPH HALL PKWY. & 1530' EAST OF MIMS ROAD (65' W. OF E. PROPERTY LINE) ELEV = 540.41

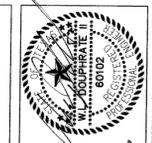

DOUPHRAATE & ASSOCIATES, INC.
 ENGINEERING - PROJECT MANAGEMENT - SURVEYING
 2235 RIDGE RD., # 200 ROCKWALL, TEXAS 75087
 PHONE: (972)771-9004 FAX: (972)771-9005

PAVING PLAN & PROFILE
WATERSTONE LANE STA: 10+00 TO 19+00
FLAGSTONE ESTATES
 CITY OF ROCKWALL, ROCKWALL COUNTY, TEXAS

REVISION	
KEB	
CHECKED	
DLB	
DRAWN	
DATE	07/04
PROJECT	0114PV-8
	15 OF