


THE SEAL APPEARING ON THIS DOCUMENT WAS AUTHORIZED BY THE BOARD OF PROFESSIONAL ENGINEERS AND SURVEYORS OF THE STATE OF TEXAS P.E. NO. 60122 ON 10/27/04

**DOUPHRADE & ASSOCIATES, INC.**  
 ENGINEERING - PROJECT MANAGEMENT - SURVEYING  
 2235 RIDGE RD., # 200 ROCKWALL, TEXAS 75087  
 PHONE: (972)771-9004 FAX: (972)771-9005

**PAVING PLAN & PROFILE**  
 SIERRA LANE STA: 19+00 TO 25+00  
 FLAGSTONE ESTATES  
 CITY OF ROCKWALL, ROCKWALL COUNTY, TEXAS

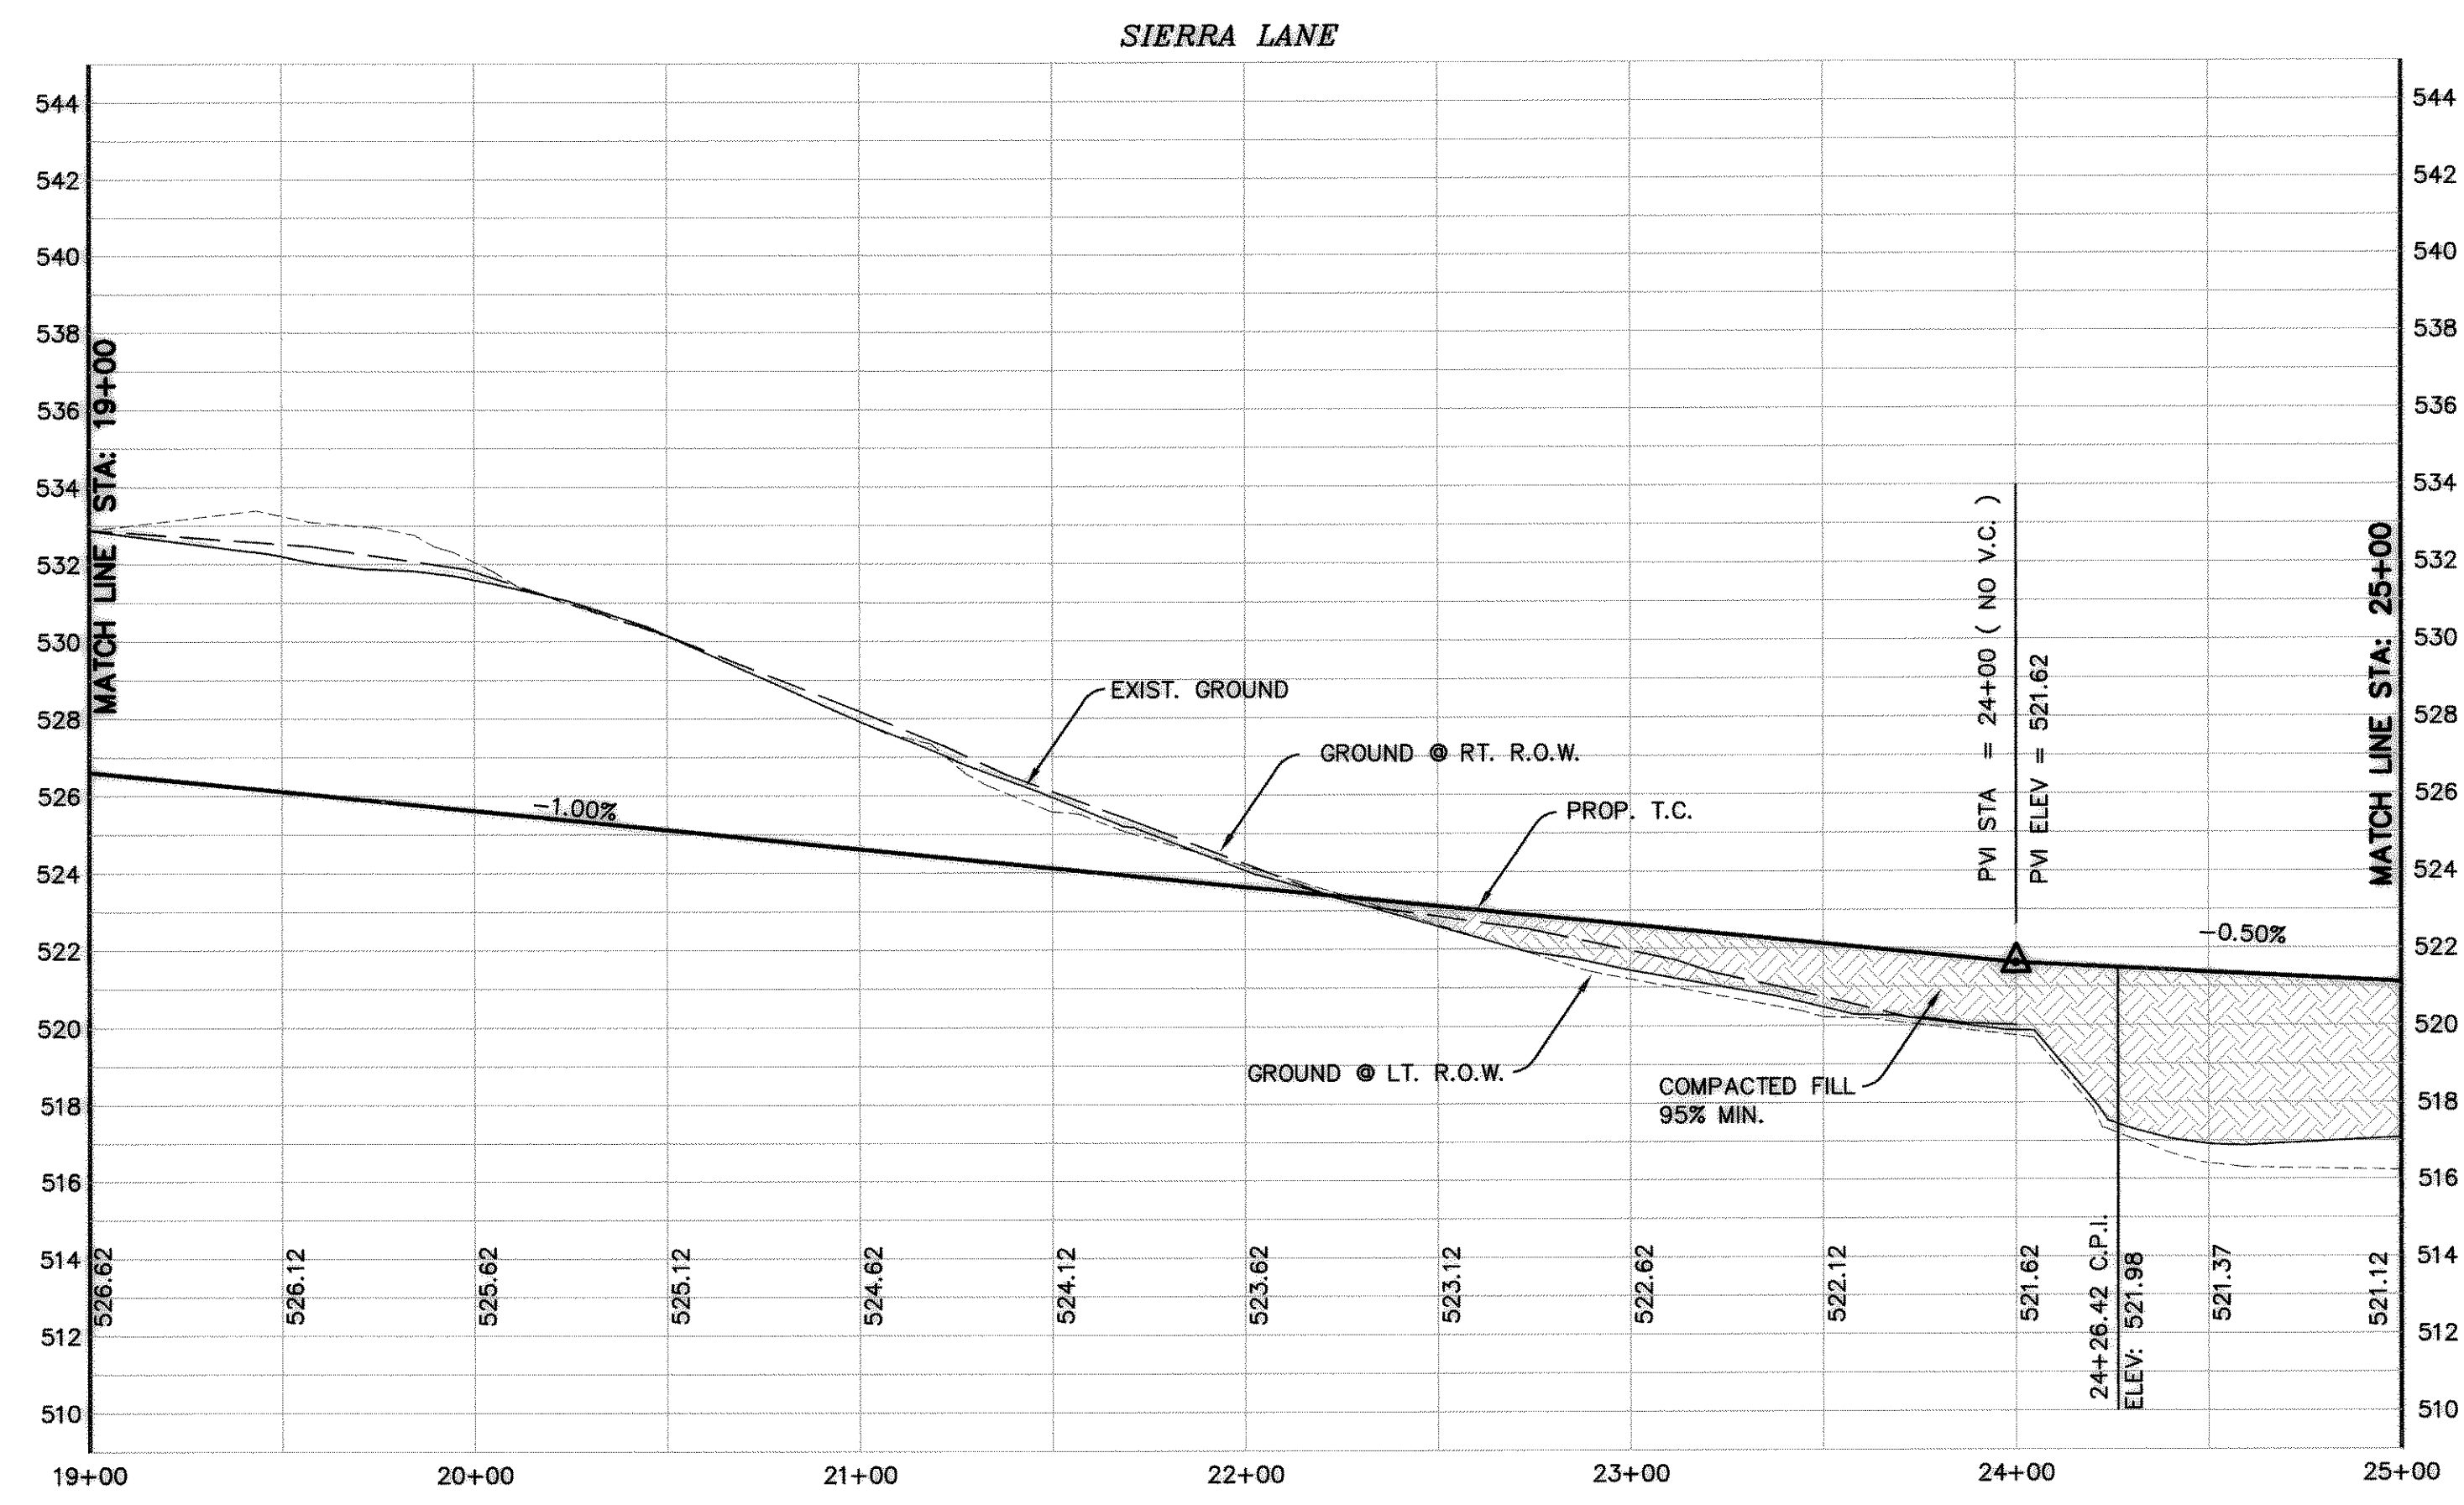

REVISED TO CONFORM TO CONSTRUCTION RECORDS.  
*W. J. ...* DATE: 1/27/06

**BENCHMARKS:**  
 B.M. = SQUARE CUT TOP OF CURB CENTER OF CURB INLET N. SIDE OF RALPH HALL PKWY. & 325' EAST OF MIMS ROAD (45' W. OF W. PROPERTY LINE) ELEV = 549.34  
 B.M. = SQUARE CUT TOP OF CURB CENTER OF CURB INLET N. SIDE OF RALPH HALL PKWY. & 1536' EAST OF MIMS ROAD (65' W. OF E. PROPERTY LINE) ELEV = 540.41

REVISION	
CHECKED	KEB.
DRAWN	DLB.
DATE	07/04
PROJECT	014PV-9