


THE SEAL APPEARING ON THIS DOCUMENT WAS AUTHORIZED BY W.L. DOUPHRATE II TEXAS P.E. NO. 80102 ON 10/27/06

**DOUPHRATE & ASSOCIATES, INC.**  
 ENGINEERING - PROJECT MANAGEMENT - SURVEYING  
 2235 RIDGE RD., # 200 ROCKWALL, TEXAS 75087  
 PHONE: (972)771-9004 FAX: (972)771-9005

STA: 5+78.73 ALLEY D=  
 STA: 10+72.94 WATERSTONE LANE

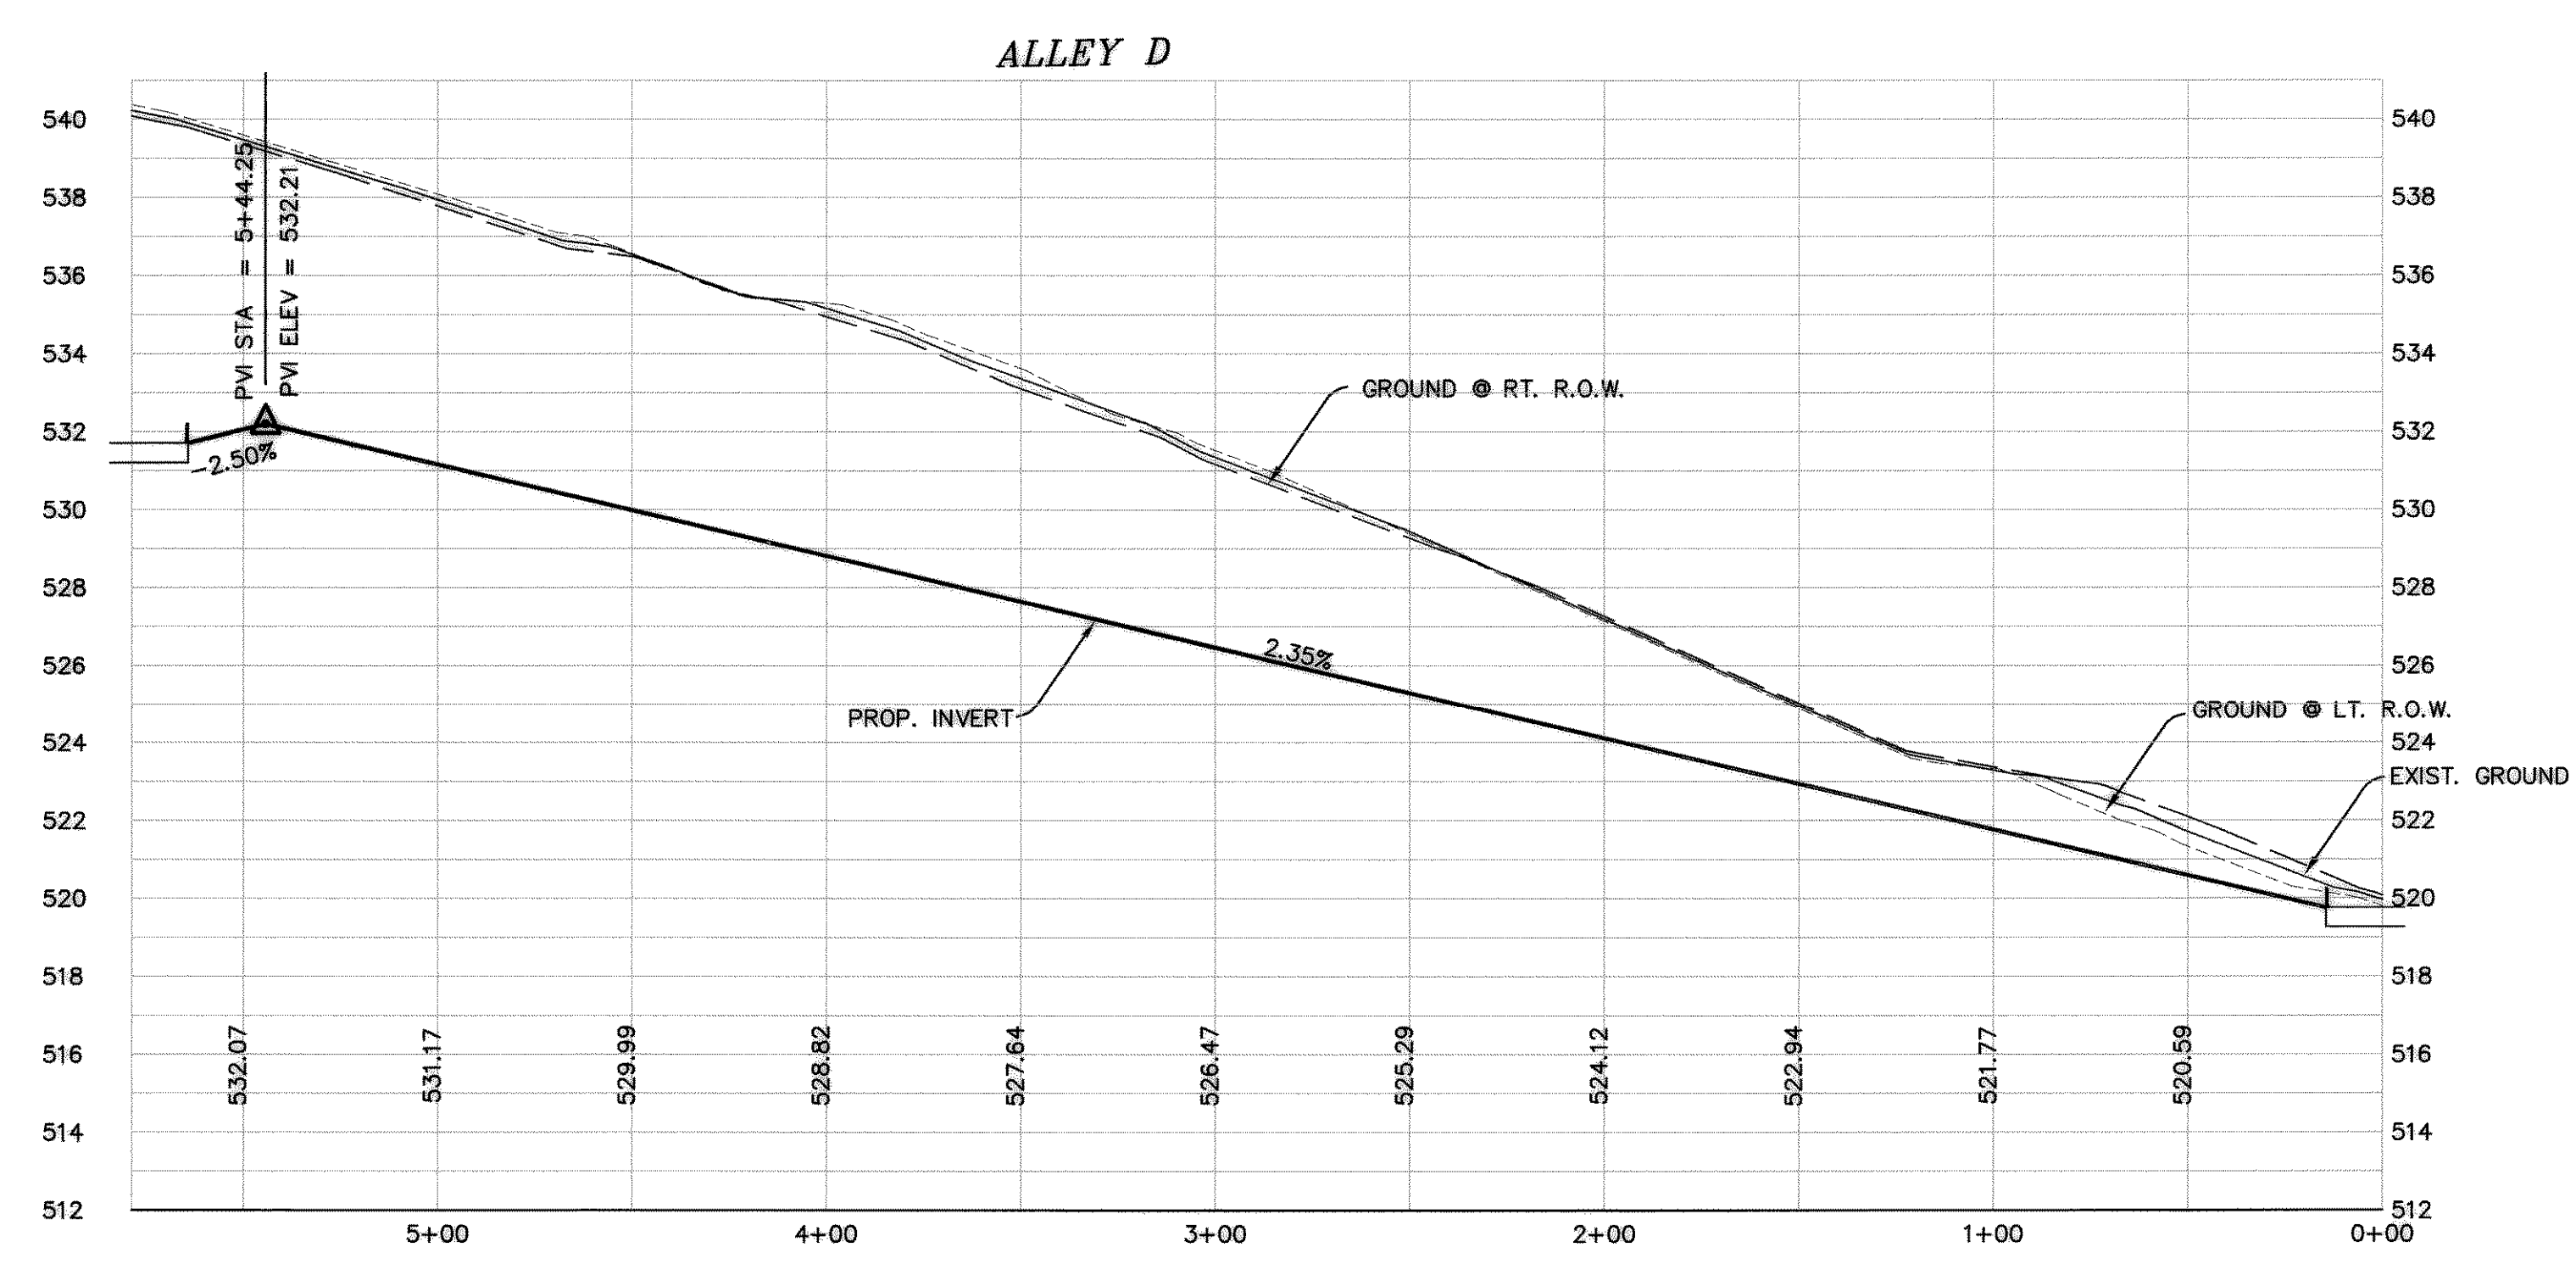

REVISED TO CONFORM TO CONSTRUCTION RECORDS.  
*[Signature]* DATE: 10/27/06

**BENCHMARKS:**  
 B.M. = SQUARE CUT TOP OF CURB CENTER OF CURB INLET N. SIDE OF RALPH HALL PKWY. & 325'± EAST OF MIMS ROAD (45'± W. OF W. PROPERTY LINE) ELEV = 549.34  
 B.M. = SQUARE CUT TOP OF CURB CENTER OF CURB INLET N. SIDE OF RALPH HALL PKWY. & 1530'± EAST OF MIMS ROAD (85'± W. OF E. PROPERTY LINE) ELEV = 540.41

PAVING PLAN & PROFILE  
 ALLEY "D"  
 FLAGSTONE ESTATES  
 CITY OF ROCKWALL, ROCKWALL COUNTY, TEXAS

REVISION	
CHECKED	KEB
DRAWN	DLB
DATE	07/04
PROJECT	014PV-15
	22
	OF