


REVISED TO CONFORM TO CONSTRUCTION RECORDS.
 DATE: 10/27/04

BENCHMARKS:
 ELEV = 549.34
 B.M. = SQUARE CUT TOP OF CURB CENTER OF CURB
 INLET N. SIDE OF RALPH HALL PKWY. & 325 1/2 EAST OF
 MIMS ROAD
 ELEV = 540.41
 B.M. = SQUARE CUT TOP OF CURB CENTER OF CURB
 INLET N. SIDE OF RALPH HALL PKWY. & 1530 1/2 EAST OF
 MIMS ROAD

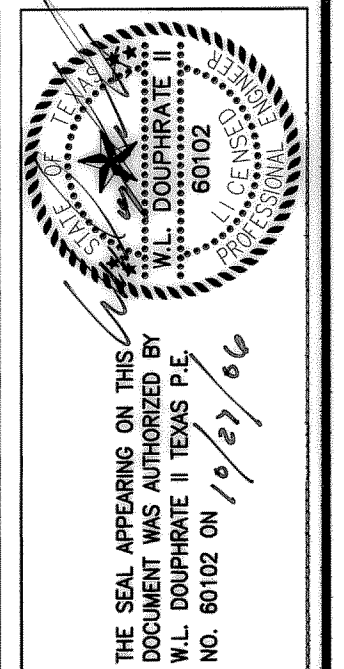

DOUPHRATE & ASSOCIATES, INC.
 ENGINEERING - PROJECT MANAGEMENT - SURVEYING
 2235 RIDGE RD., # 200 ROCKWALL, TEXAS 75087
 PHONE: (972)771-9004 FAX: (972)771-9005

**SANITARY SEWER PROFILE
 LINE A**
 FLAGSTONE ESTATES
 CITY OF ROCKWALL, ROCKWALL COUNTY, TEXAS

REVISION	
CHECKED	W.L.D.
DRAWN	K.E.B.
DATE	9/04
PROJECT	0145AN SP
	26 OF