


- GENERAL NOTES**
1. ALL WORKS RELATED TO CULVERT CONSTRUCTION BE DONE PER TXDOT STANDARDS AND DETAILS.
  2. THE HEADWALLS WILL BE STAKED IN THE FIELD BY DEVELOPER'S ENGINEER PRIOR TO CONSTRUCTION. THE CITY ENGINEER WILL APPROVE HEADWALL LOCATION IN THE FIELD PRIOR TO CONSTRUCTION.
  3. THE CULVERTS WILL NEED TO BE AT ROW AT UPSTREAM AND 5' PAST BACK OF CURB DOWN STREAM.
  4. UP STREAM AND DOWN STREAM SIDE OF BOTH THE CULVERTS WILL BE GRADED PER SHEET 378.
  5. CULVERT RAILS SHALL BE PER CITY OF PLANO STANDARD CONSTRUCTION DETAILS SHEET SD-13 WITH ROUND TOP MEMBER.
- DISCLAIMER: THE CULVERTS SHOWN UNDER MIMS ROAD ARE SOLELY DESIGNED BASED ON THE BUFFALO CREEK H&H STUDY PERFORMED BY O'BRIEN ENGINEERING, INC. DATED: JULY 13, 2005 FOR THE CONSTRUCTION OF FLAGSTONE ESTATES. ANY FUTURE DEVELOPMENT ALONG THE SOUTHERN TRIBUTARY SHOULD BE ANALYZED TO ENSURE NO IMPACT ON THE BOX CULVERTS AT MIMS ROAD.

REVISED TO CONFORM TO CONSTRUCTION RECORDS.

*[Signature]* DATE: 10/27/06

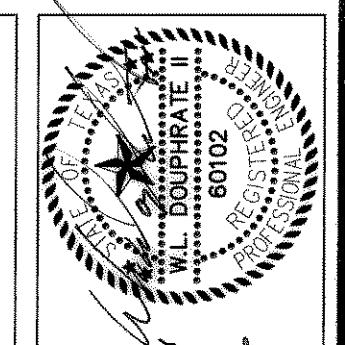

THE SEAL APPEARING ON THIS DOCUMENT WAS AUTHORIZED BY W.L. DOUPHRATE # 60102 STATE OF TEXAS ON 10/27/06

**DOUPHRATE & ASSOCIATES, INC.**  
ENGINEERING - PROJECT MANAGEMENT - SURVEYING  
2295 RIDGE RD., # 200 ROCKWALL, TEXAS 75087  
PHONE: (972)771-9004 FAX: (972)771-9005

**STORM SEWER PLAN - LINE "I" & "J"**  
FLAGSTONE ESTATES  
CITY OF ROCKWALL  
ROCKWALL COUNTY, TEXAS

REVISION	06-21-06
DRAWN	DLB
CHECKED	DLB
DATE	9/04
PROJECT	37A
	OF