


REVISED TO CONFORM TO CONSTRUCTION RECORDS.  
 DATE: 10/27/04

**BENCHMARKS:**  
 ELEV = 549.34  
 B.M. = SQUARE CUT TOP OF CURB CENTER OF CURB  
 INLET N. SIDE OF RALPH HALL PKWY. & 325' EAST OF  
 MIMS ROAD

ELEV = 540.41  
 B.M. = SQUARE CUT TOP OF CURB CENTER OF CURB  
 INLET N. SIDE OF RALPH HALL PKWY. & 1530' EAST OF  
 MIMS ROAD

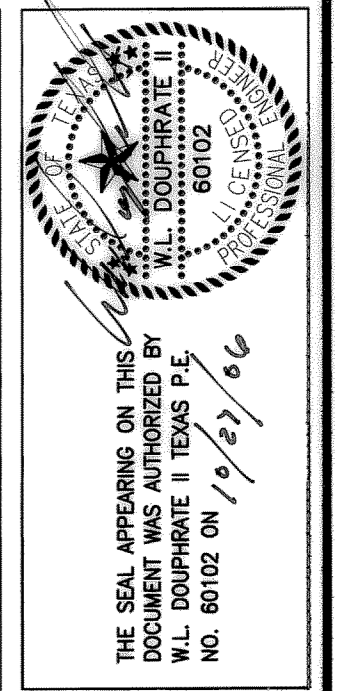

**DOUPHRATE & ASSOCIATES, INC.**  
 ENGINEERING - PROJECT MANAGEMENT - SURVEYING  
 2235 RIDGE RD., # 200 ROCKWALL, TEXAS 75087  
 PHONE: (972)771-9004 FAX: (972)771-9005

**SANITARY SEWER PROFILE  
 LINE A**  
 FLAGSTONE ESTATES  
 CITY OF ROCKWALL, ROCKWALL COUNTY, TEXAS

REVISION	
CHECKED	W.L.D.
DRAWN	K.E.B.
DATE	9/04
PROJECT	0145AN SP
	26 OF