


1) TOTAL COMMERCIAL AREAS

TOTAL COMMERCIAL AREA = COMMERCIAL-I + COMMERCIAL-II		
11.27	= (DA#1,1A)	+ (DA#2,DA#3)
11.27	= (2.58+1.63)	+ (6.15+0.91)
11.27	= 4.21	+ 7.06

2) TOTAL POND CAPACITIES

TOTAL POND CAPACITY = POND-1 + POND-2		
11.27	= 3.05	+ 8.22

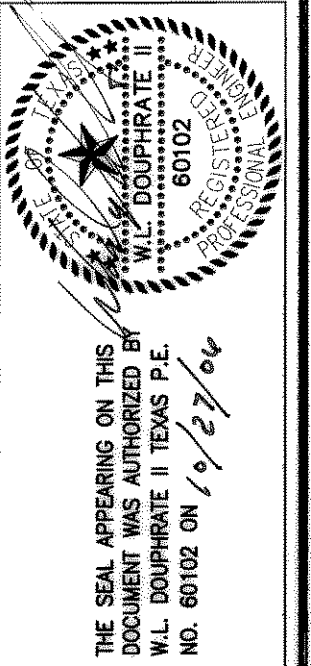

DOUPHRADE & ASSOCIATES, INC.
ENGINEERING - PROJECT MANAGEMENT - SURVEYING
2235 RIDGE RD., # 200 ROCKWALL, TEXAS 75087
PHONE: (972)771-9004 FAX: (972)771-9005

DETENTION PLAN (OVERALL)
FLAGSTONE ESTATES
CITY OF ROCKWALL
ROCKWALL COUNTY, TEXAS

REVISION
CHECKED K.E.B.
DRAWN D.L.B.
DATE 9/04
PROJECT

REVISED TO CONFORM TO CONSTRUCTION RECORDS.
W.L. Douphrate DATE: 10/21/06