


15' DRAINAGE EASEMENTS  
BY SEPARATE INSTRUMENT  
VOL. 04384  
PAGE NO. 00141

15' DRAINAGE EASEMENT  
BY SEPARATE INSTRUMENT  
VOL. 4384, PG. 141

35' R.O.W. DEDICATION  
BY SEPARATE INSTRUMENT  
VOL. 04384  
PAGE NO. 00135

REVISED TO CONFORM TO CONSTRUCTION RECORDS.  
*W. L. Douphrate* DATE: 10/27/06

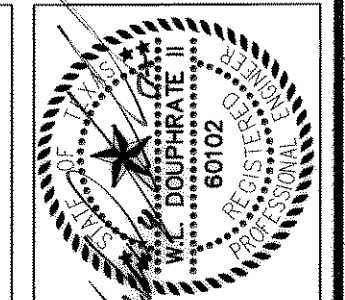

THE SEAL APPEARING ON THIS DOCUMENT WAS AUTHORIZED BY W.L. DOUPHRATE II TEXAS P.E. NO. 60102 ON 09/27/04

**DOUPHRATE & ASSOCIATES, INC.**  
ENGINEERING - PROJECT MANAGEMENT - SURVEYING  
2235 RIDGE RD., # 200 ROCKWALL, TEXAS 75087  
PHONE: (972)771-9004 FAX: (972)771-9005

STORM SEWER PLAN (OVERALL )  
FLAGSTONE ESTATES  
CITY OF ROCKWALL  
ROCKWALL COUNTY, TEXAS

11-15-05

REVISION
KEB
CHECKED
DLB
DRAWN
9/04
DATE
PROJECT