
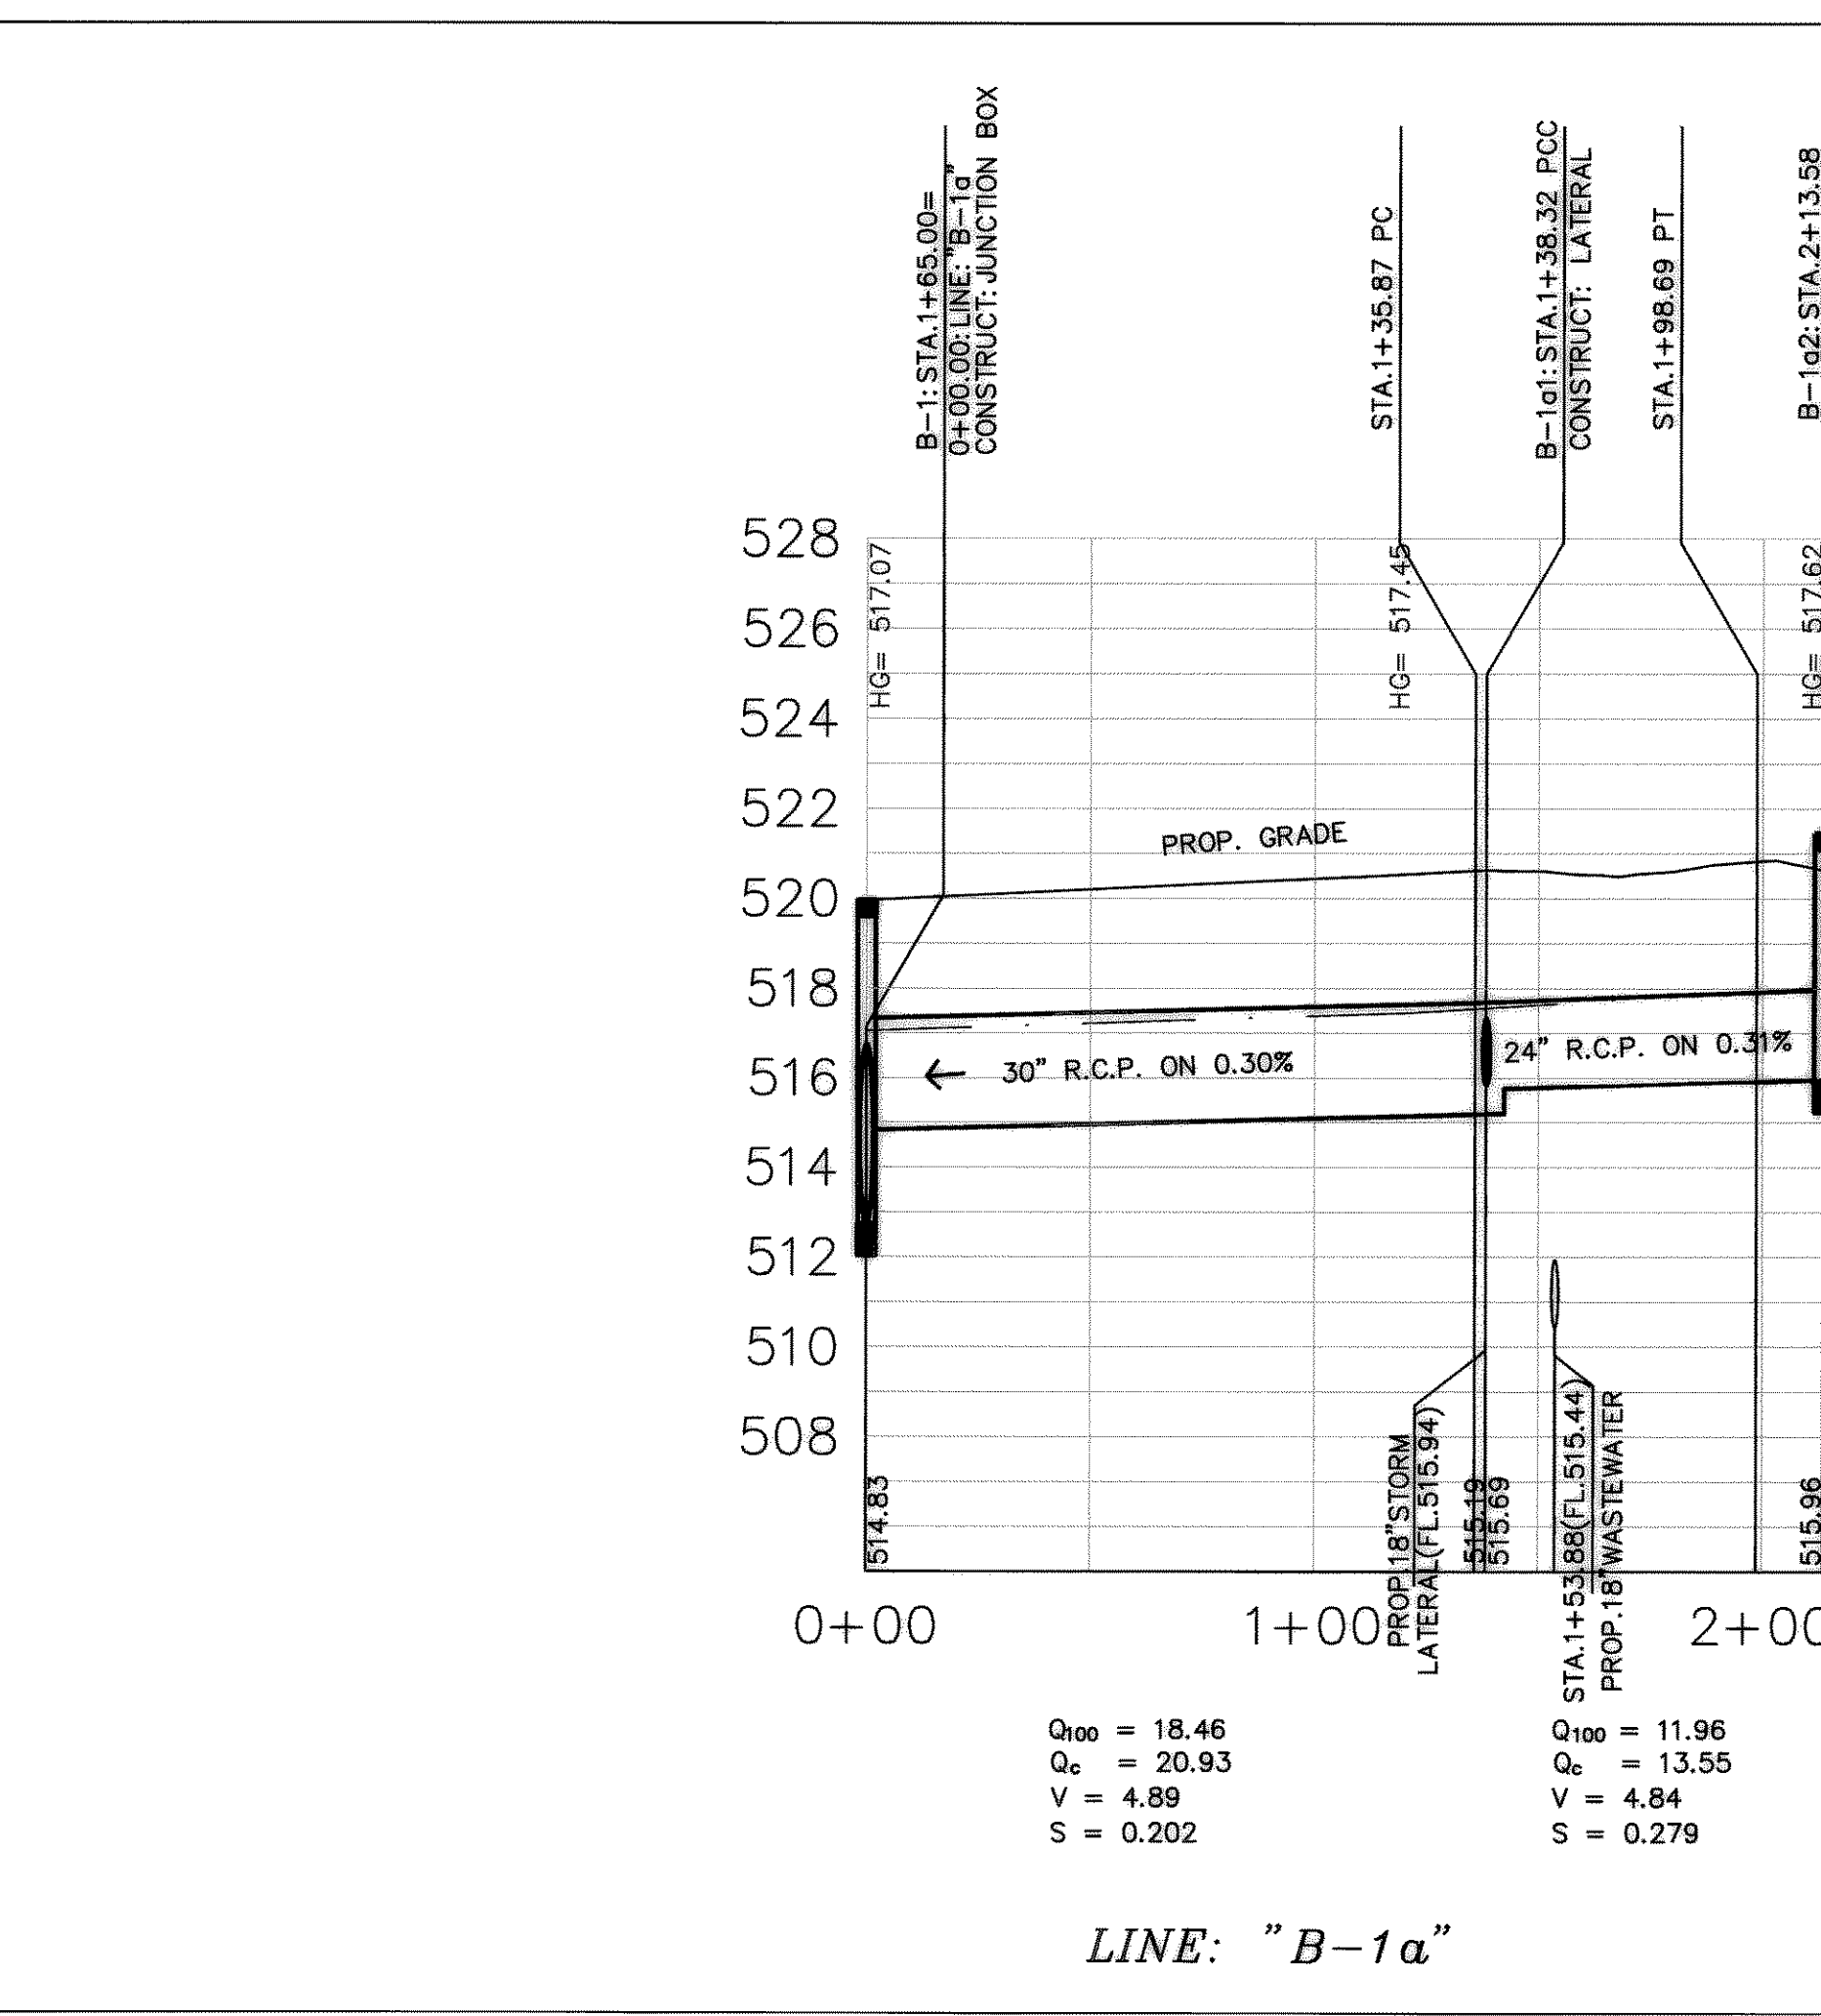
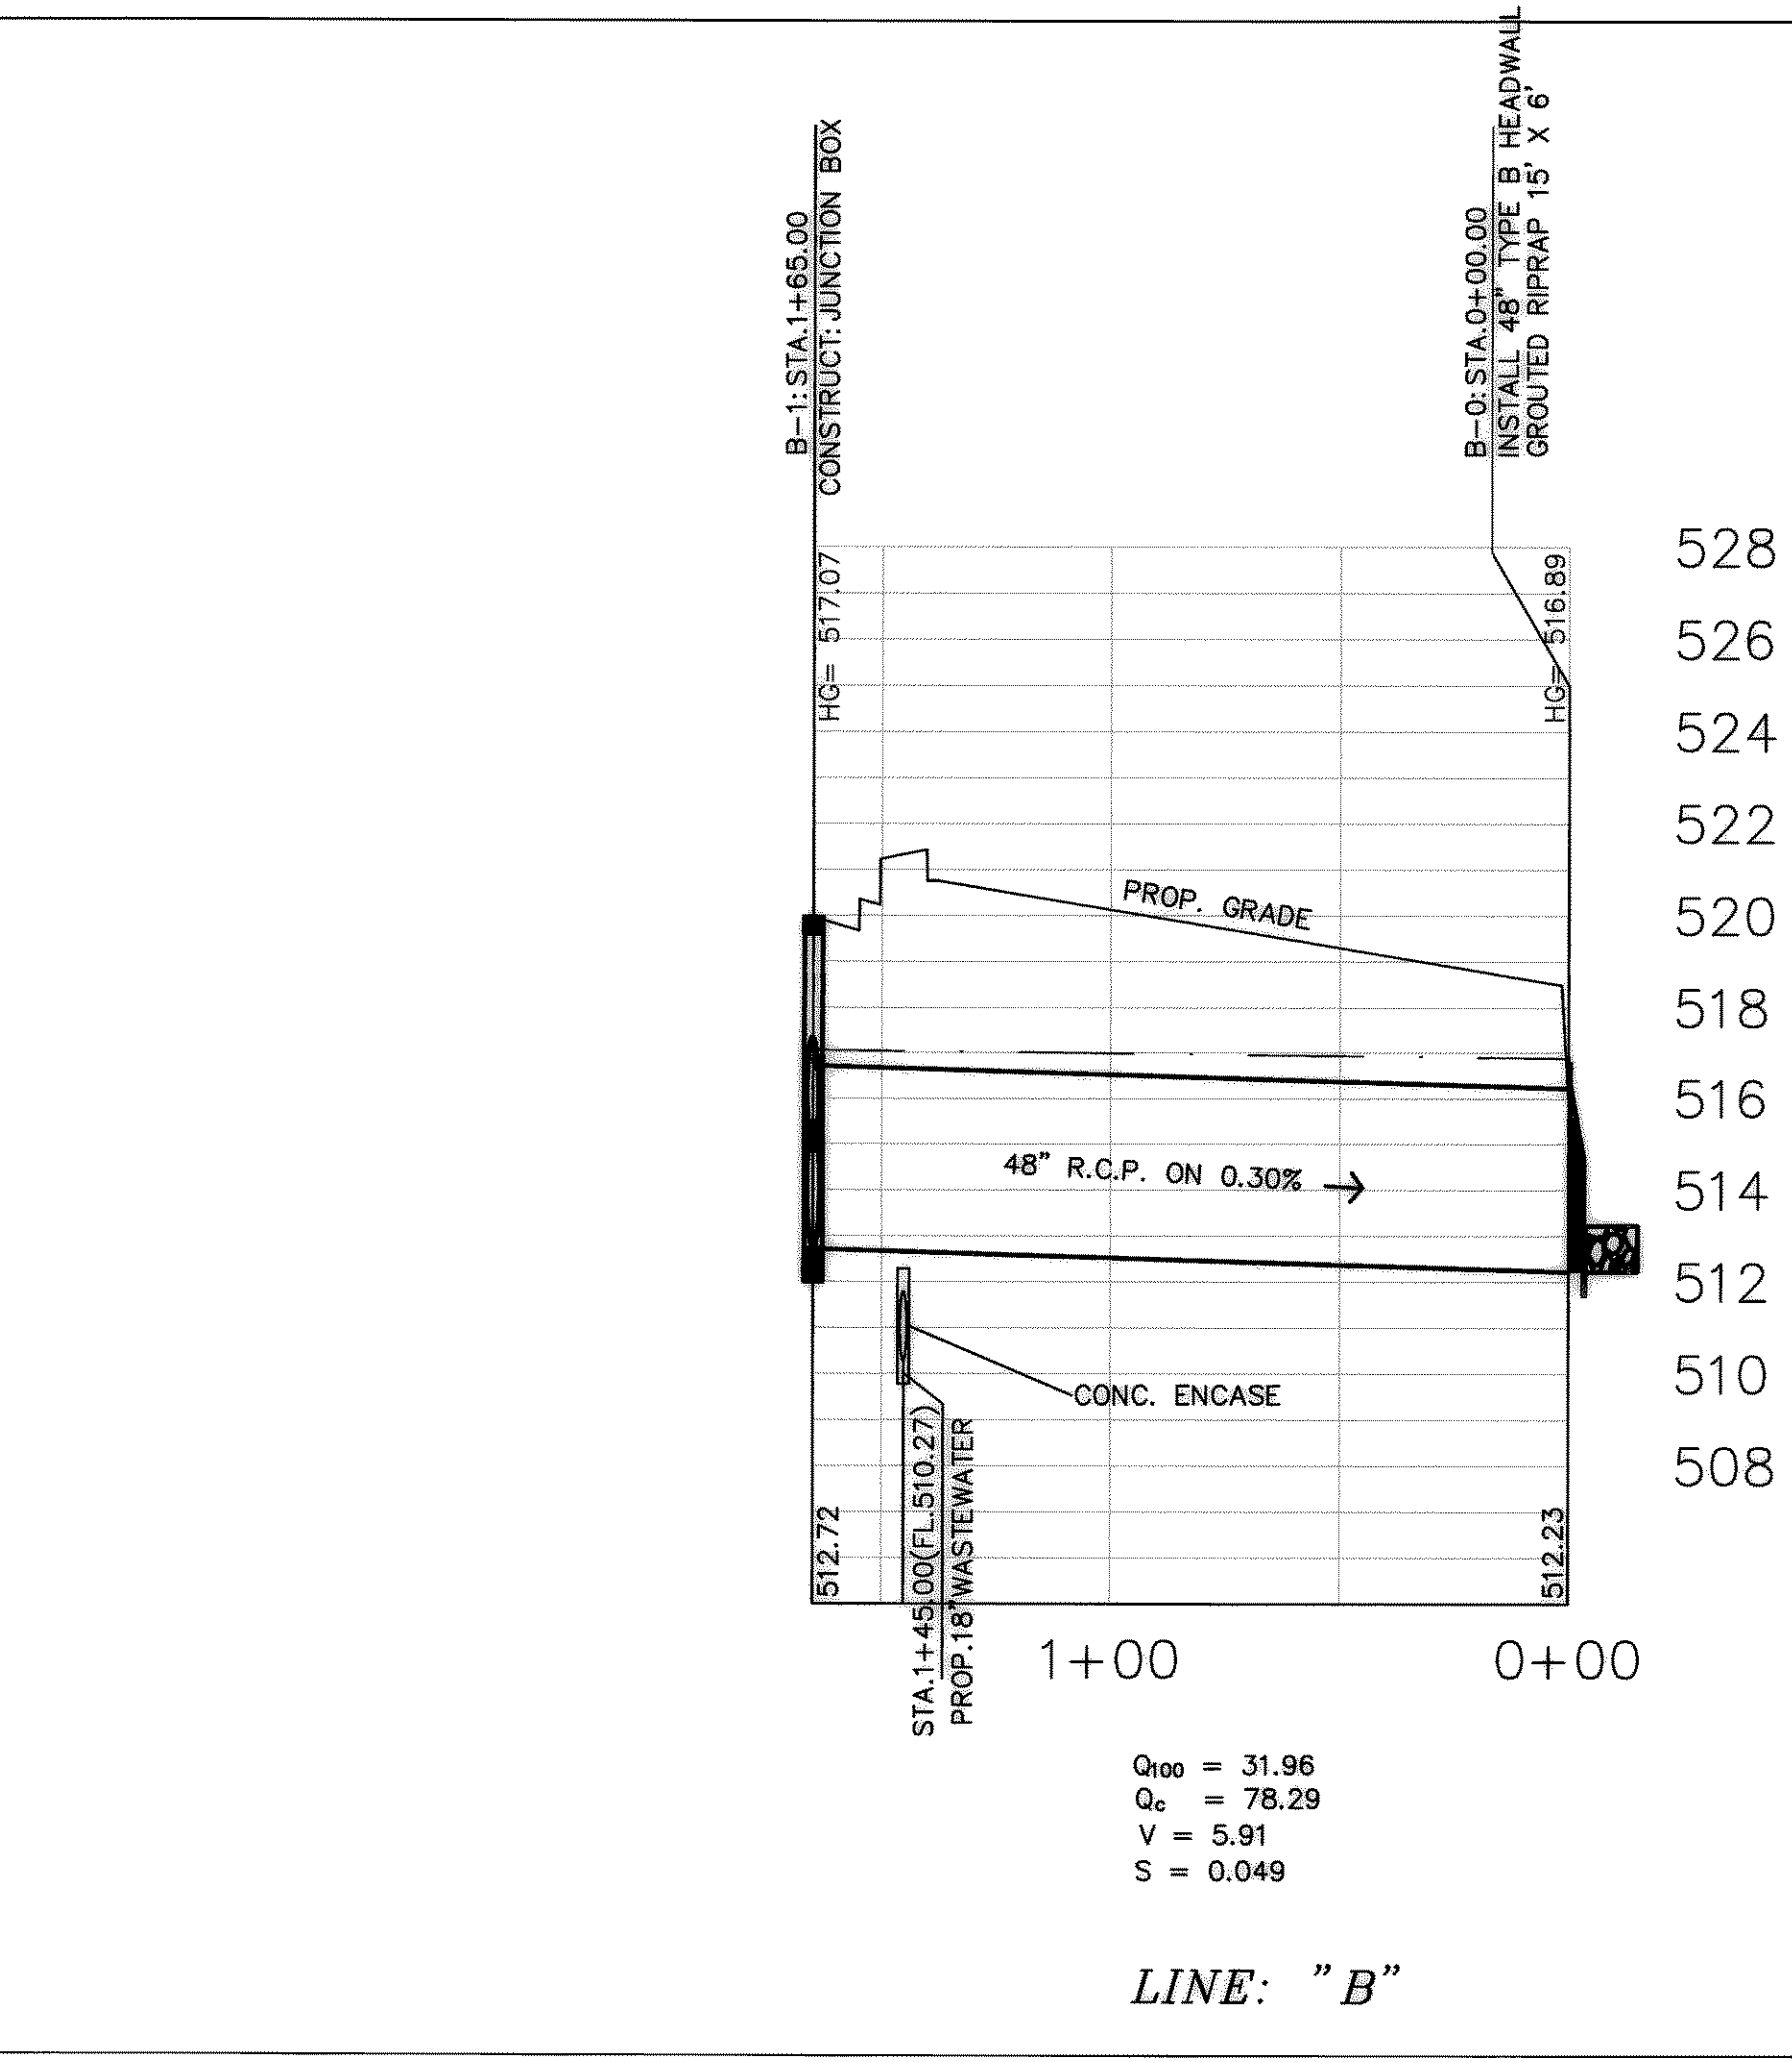


THE SEAL APPEARING ON THIS DOCUMENT WAS AUTHORIZED BY W.L. DOUPHRATE II TEXAS P.E. NO. 6010 ON 10/27/06

**DOUPHRATE & ASSOCIATES, INC.**  
ENGINEERING • PROJECT MANAGEMENT • SURVEYING  
2235 RIDGE RD., # 200 ROCKWALL, TEXAS 75087  
PHONE: (972)771-9004 FAX: (972)771-9005

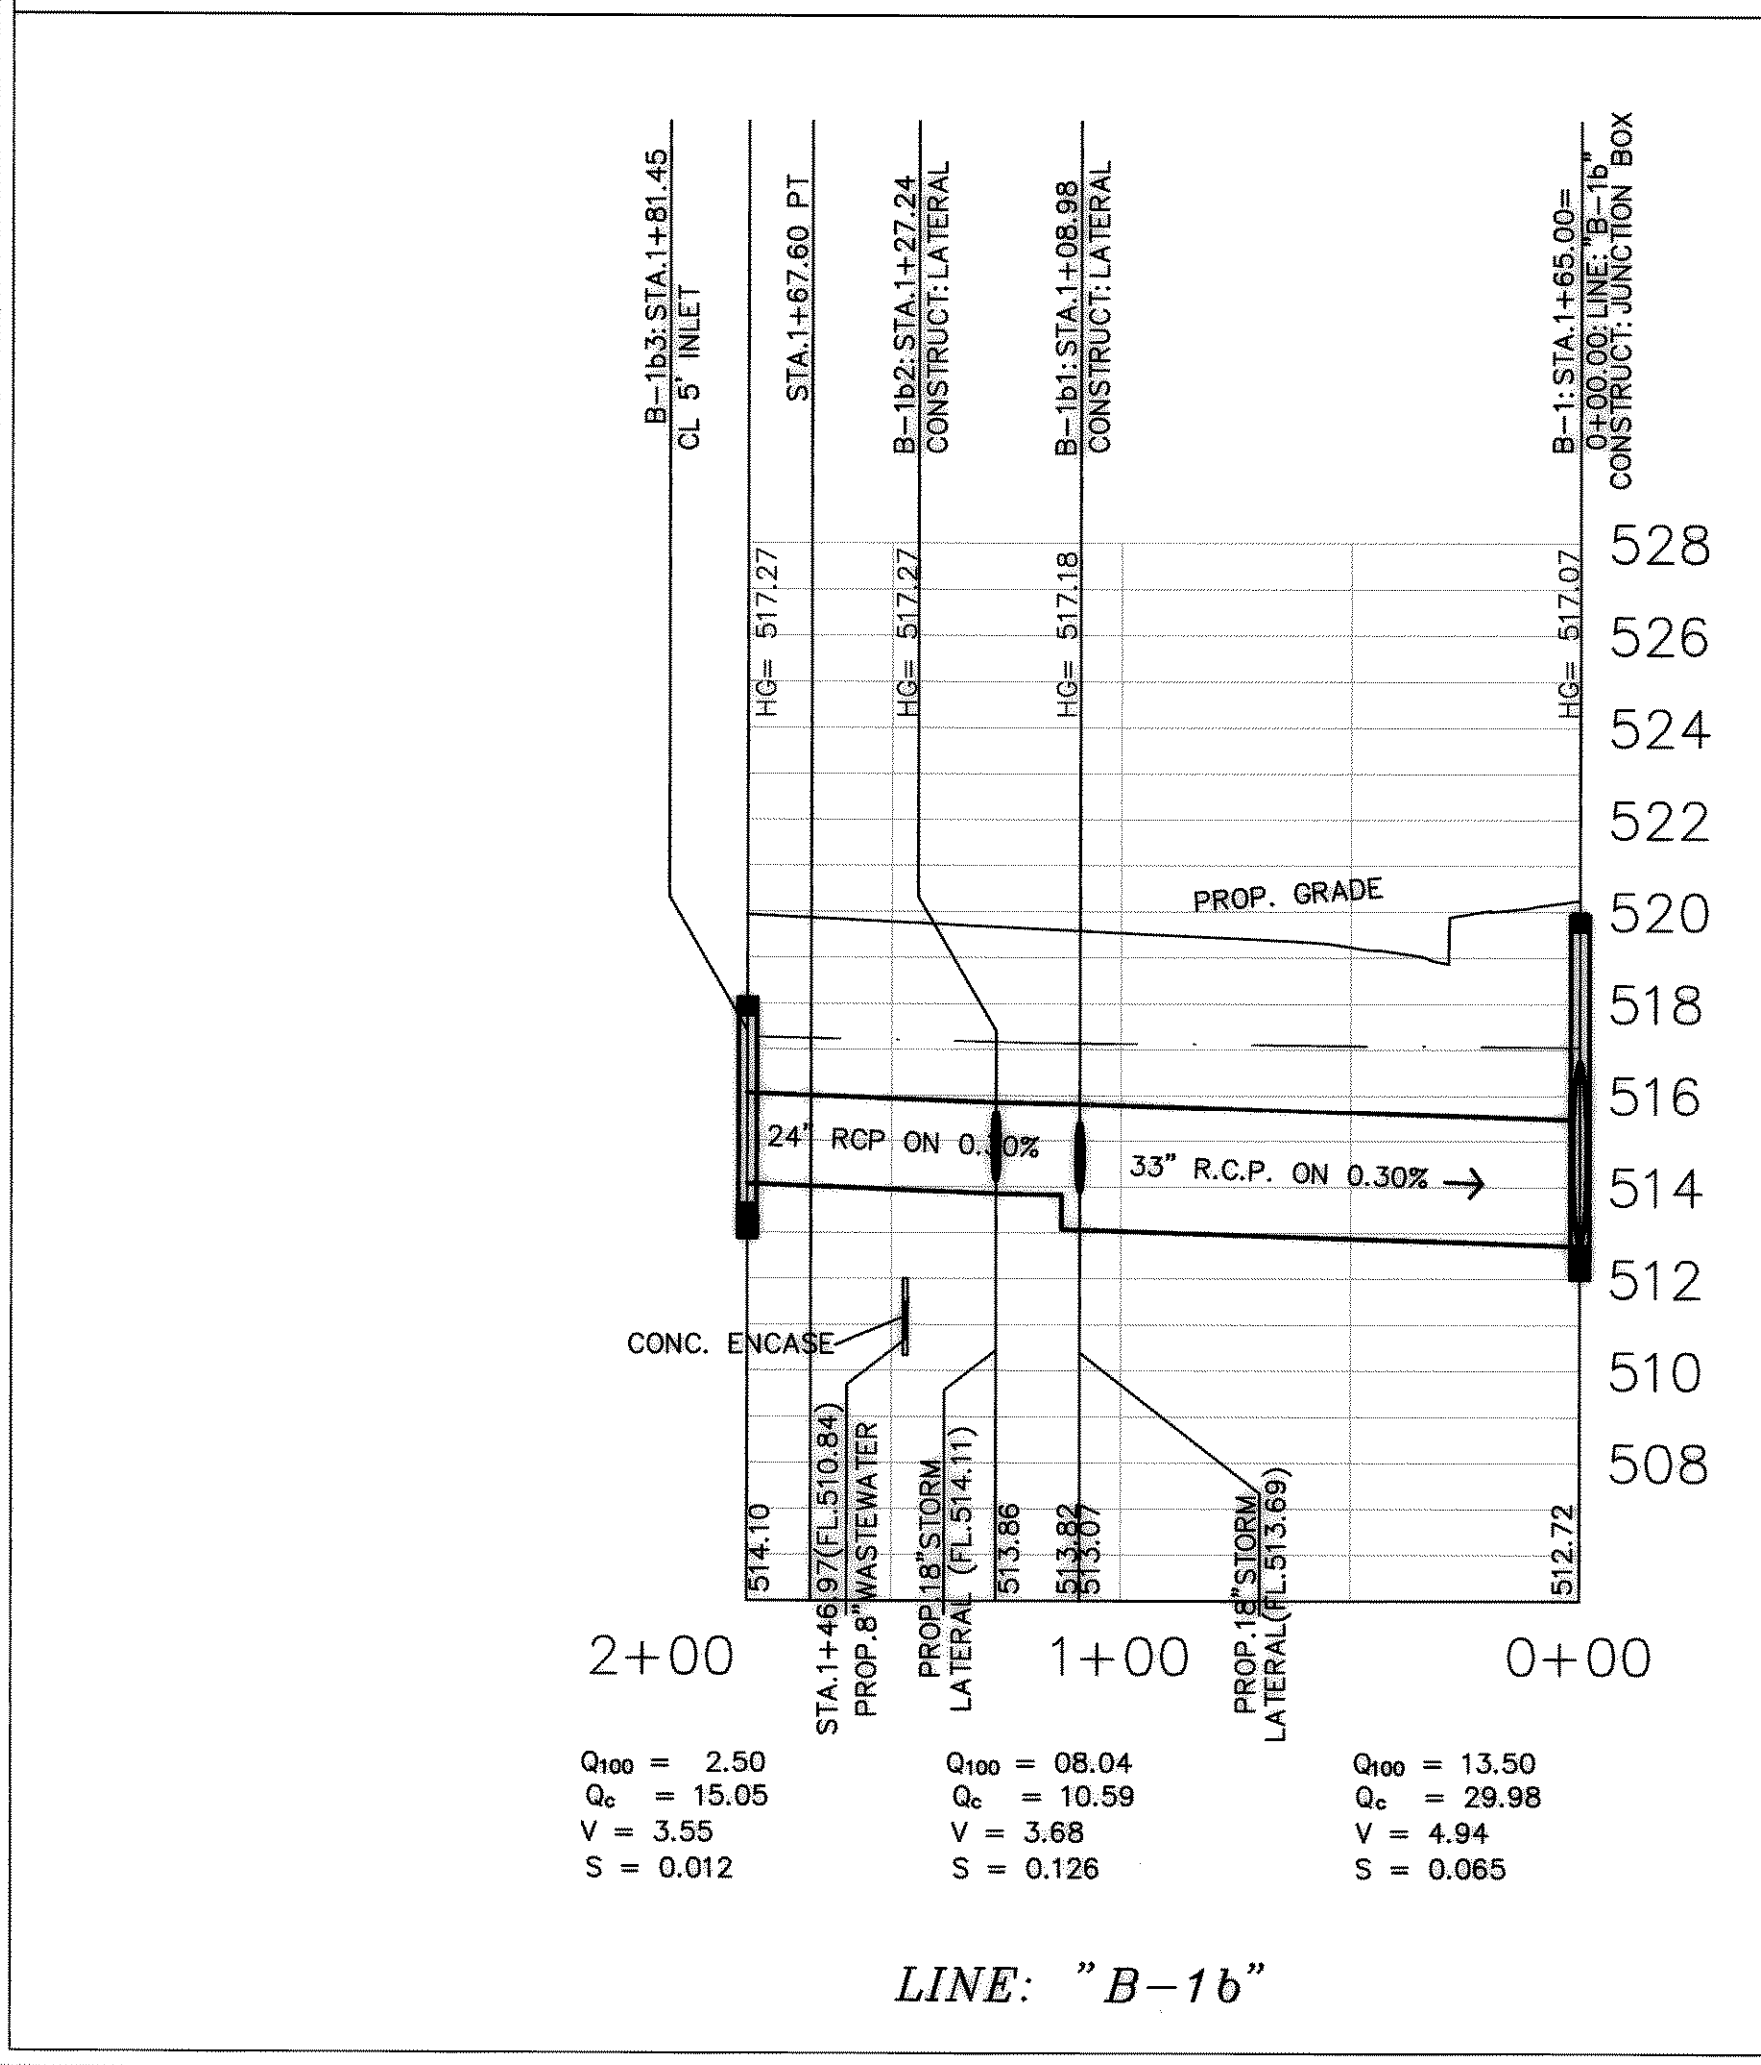

REVISED TO CONFORM TO CONSTRUCTION RECORDS.  
DATE: 10/23/06

**STORM SEWER (LINE B)**  
FLAGSTONE ESTATES  
CITY OF ROCKWALL  
ROCKWALL COUNTY, TEXAS

REVISION	KEB.
CHECKED	DLB.
DRAWN	
DATE	9/04
PROJECT	

35