
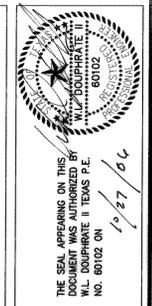
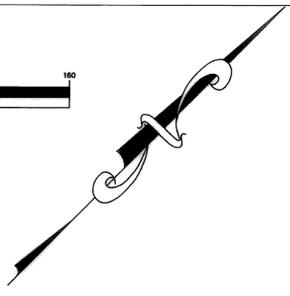


Site		Stratum		Surf1		Surf2		Cut		Fill		Net		Method	
0114		stockpile		0114		stockpile		553		32633		32080 (F)		Grid	
								710		33210		32500 (F)		Composite	
								745		33182		32437 (F)		End area	


LEGEND:

-  SILT FENCING
-  INLET PROTECTION
-  CONSTRUCTION ENTRANCE

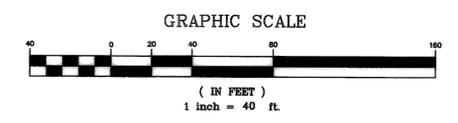

DOUPBRATE & ASSOCIATES, INC.
 ENGINEERING • PROJECT MANAGEMENT • SURVEYING
 2235 RIDGE RD., # 200 ROCKWALL, TEXAS 75087
 PHONE: (972)771-9004 FAX: (972)771-9005

COMMERCIAL GRADING
FLAGSTONE ESTATES
 CITY OF ROCKWALL
 ROCKWALL COUNTY, TEXAS

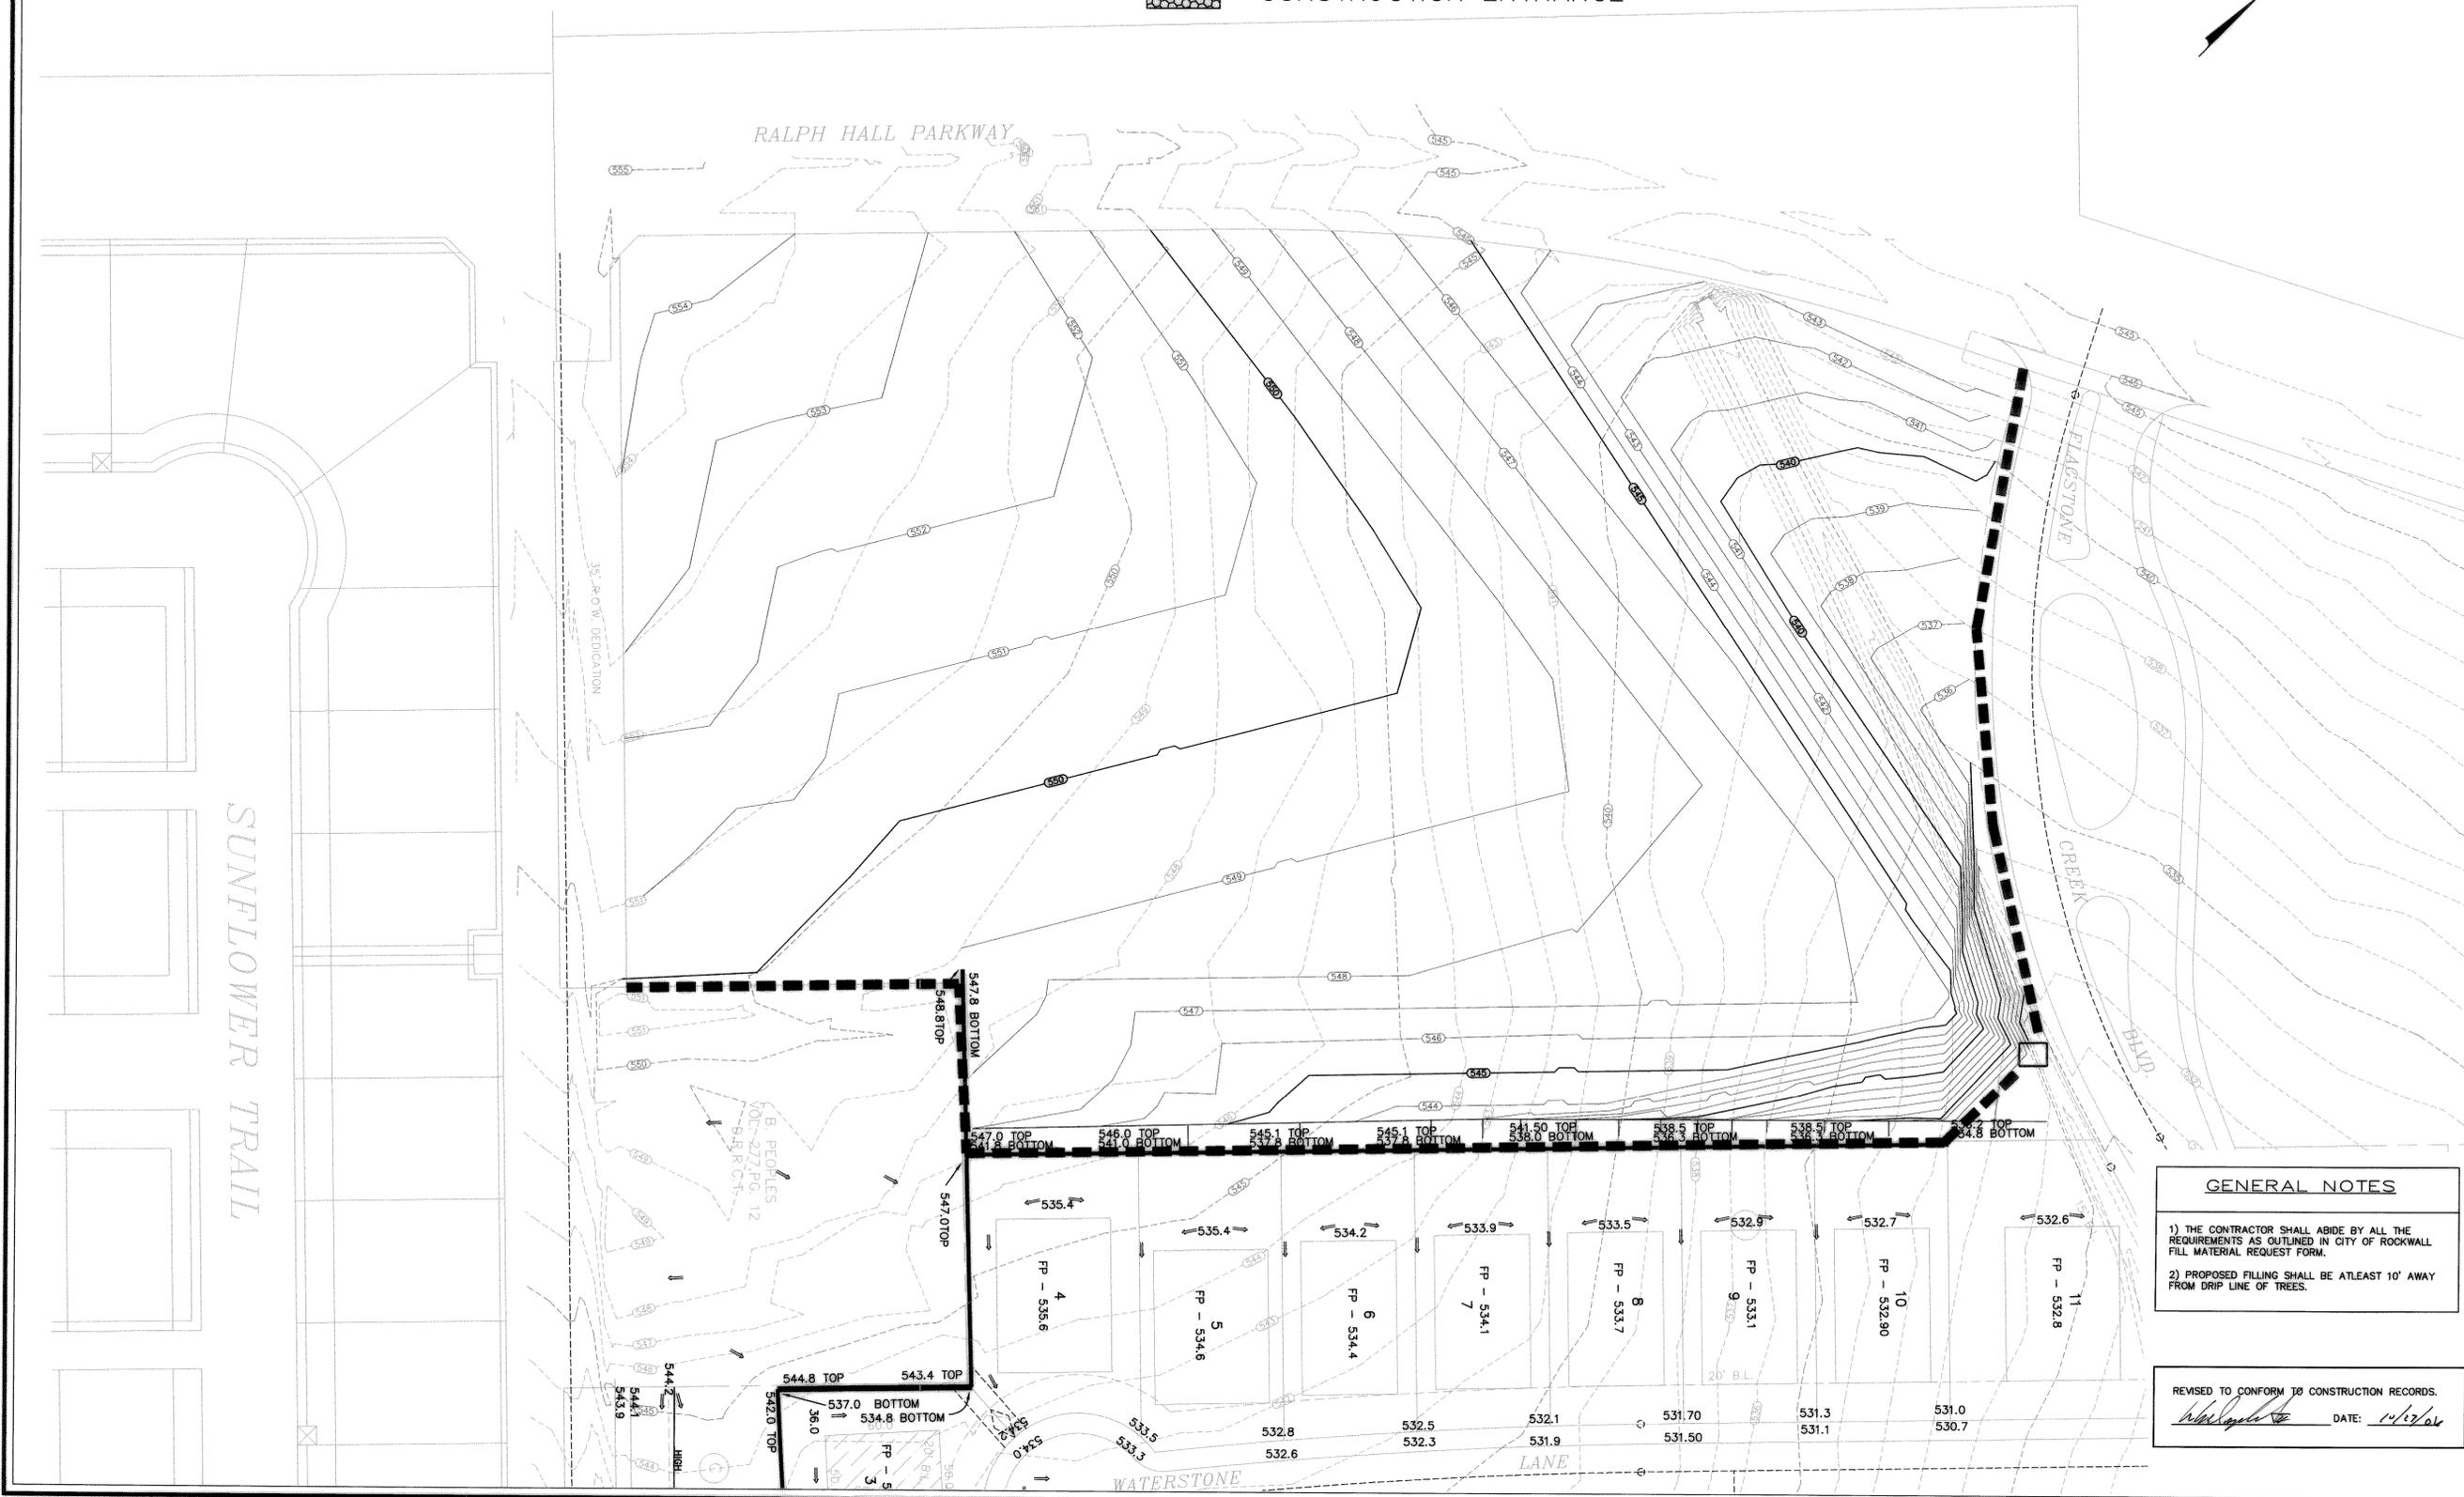

GENERAL NOTES

- 1) THE CONTRACTOR SHALL ABIDE BY ALL THE REQUIREMENTS AS OUTLINED IN CITY OF ROCKWALL FILL MATERIAL REQUEST FORM.
- 2) PROPOSED FILLING SHALL BE ATLEAST 10' AWAY FROM DRIP LINE OF TREES.

REVISED TO CONFORM TO CONSTRUCTION RECORDS.
[Signature] DATE: 11/12/06

REVISION
CHECKED KEB
DATE DLB.
DRAWN 9/04
DATE
PROJECT
7C
OF
1