



MATCHLINE (SEE SHEET 15)

NOTE:
DRIVEWAYS AND CULVERTS TO
BE REPLACED WITH SAME
MATERIAL AS EXISTING.

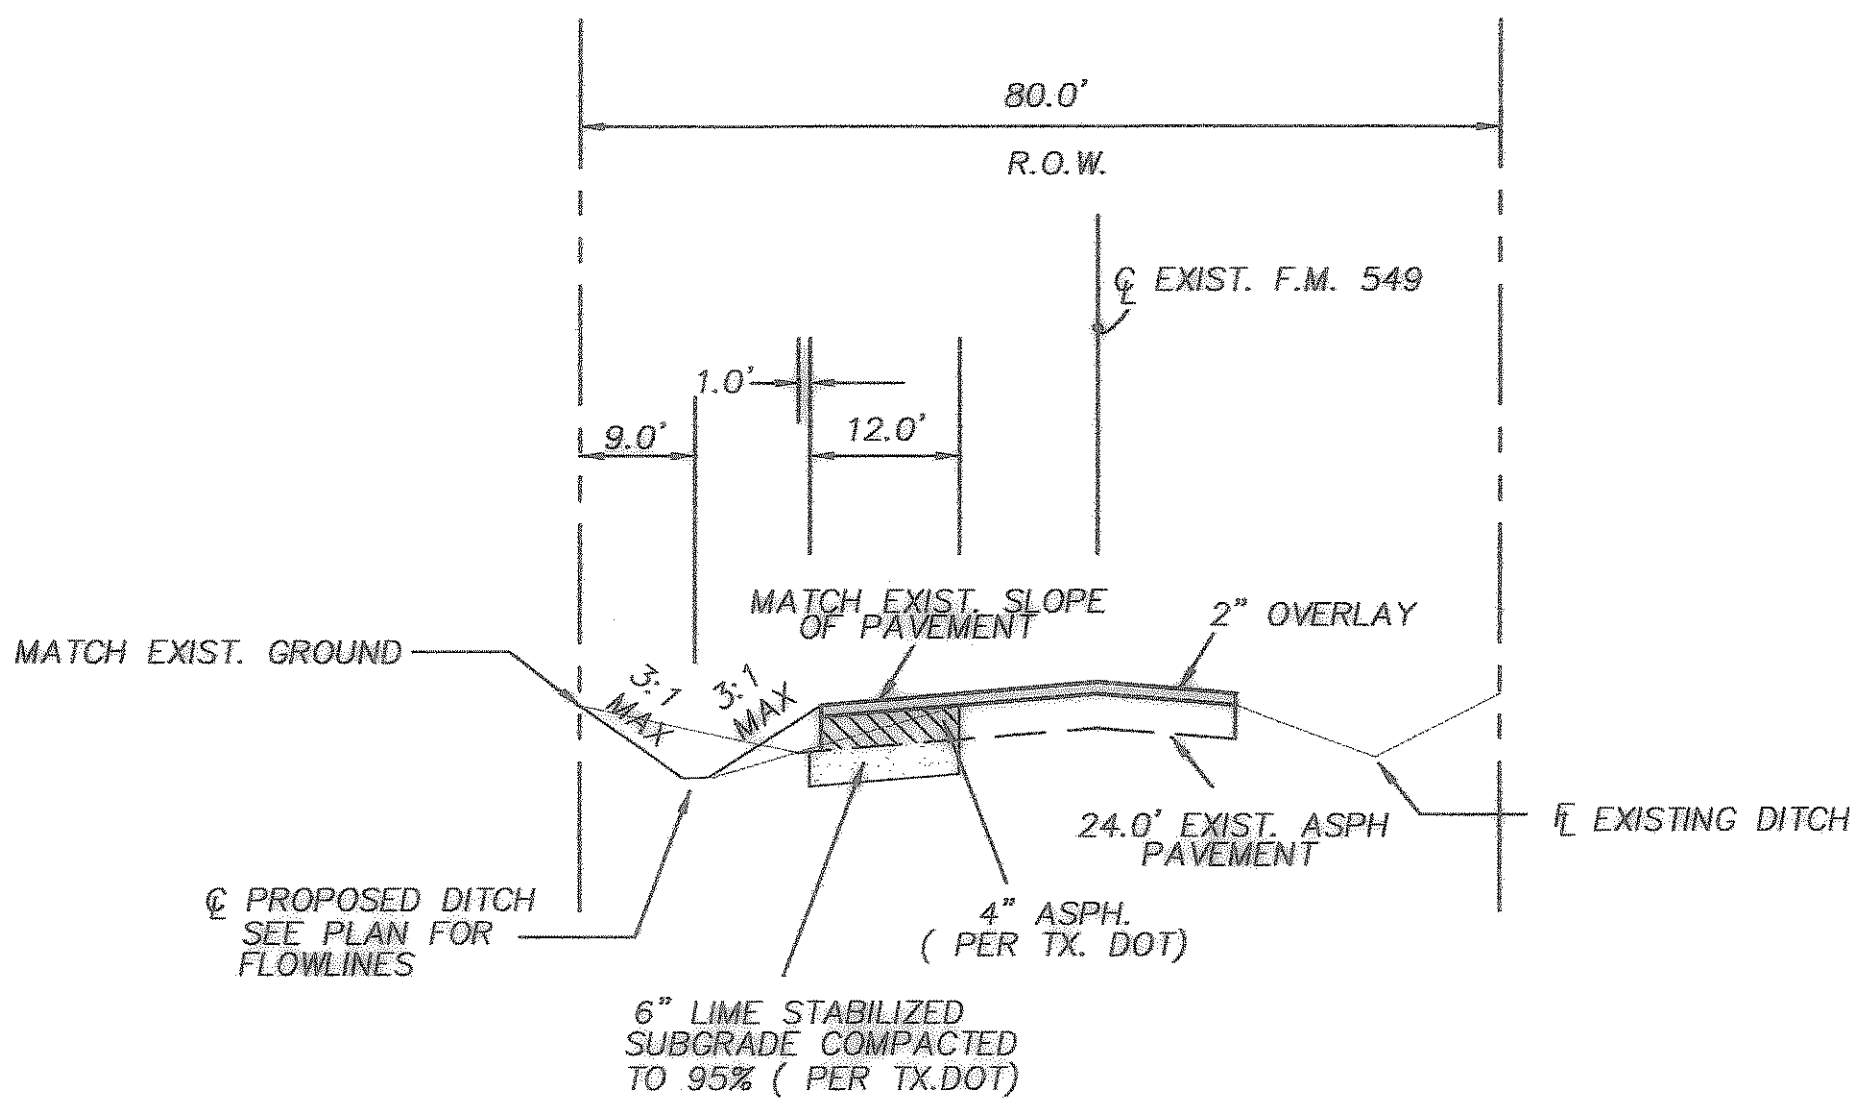

THE SEAL APPEARING ON THIS DOCUMENT WAS AUTHORIZED BY CHRISTOPHER R. CUNY, P.E. 65642

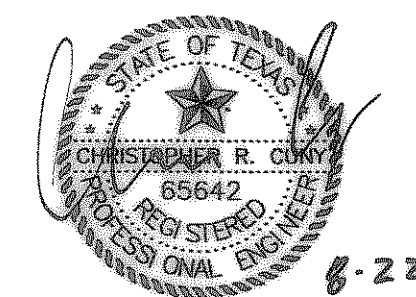

Construction Record Drawing
8-22-2007

F.M. 549 ACCESS PLAN					
Fontanna Ranch					
<i>City of Rockwall, Rockwall County, Texas</i>					
<i>Spring Haven Investments, Inc.</i>					
<small>6750 Hillcrest Plaza Dr. • Suite 305 • Dallas, Texas 75230 • 972.386.3333</small>					
F.C. CUNY CORPORATION					
<small>#2 Horizon Court • Heath, Texas 75032 • 469-402-7700</small>					
Drawn By:	Checked By:	Date:	Scale:	Project No.:	Sheet No.:
MSC	DW	10/16/06	1"=50'	05-013	16 of 45

Z:\Projects\5-Residential\Fontanna\Record Drawings\FONT-FM549 ACCESS.dwg Mon Aug 20 16:45:39 2007