


DEVELOPMENT PLANS

Fontanna Ranch Phase 2


CITY OF ROCKWALL, TEXAS

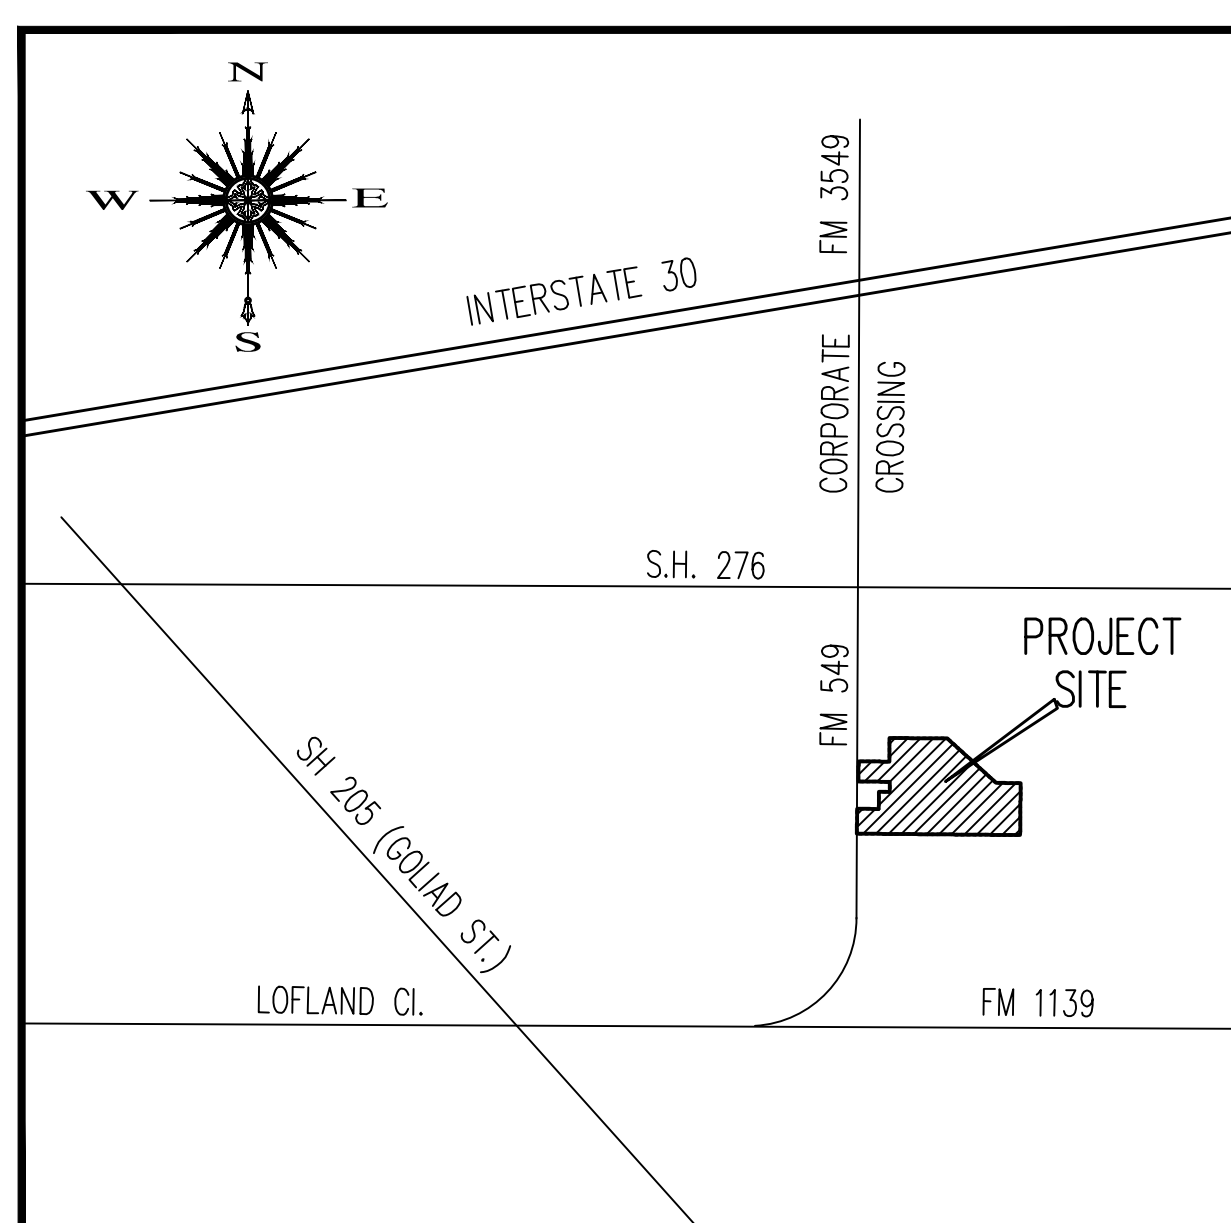

LOCATION MAP

INDEX of SHEETS

Sheet No.	Title
1	Cover Sheet
2 & 3	Final Plat
4-7	Paving Plan & Profile
8	Grading Plan
9	Drainage Area Map
10A-B	Detention Pond Calculations
11-12A	Storm Sewer Plan & Profile
13	Water and Sewer Plan
14-15	Sanitary Sewer Profiles
16	Erosion Control Plan
17	Lighting and Signage Plan

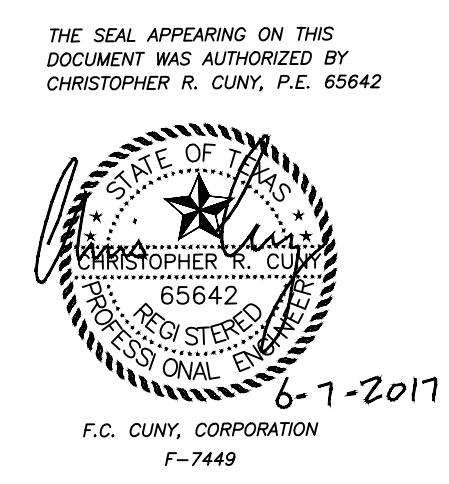

Applicant ~ Developer
 Fontanna Ranch, Ltd.
 6750 Hillcrest Plaza Dr.
 Suite 325
 Dallas Texas 75230
 (972) 386-3333

RECORD DRAWINGS

June 7, 2017

~ Engineer ~
F.C. CUNY CORPORATION
 #2 Horizon Court • Heath, Texas 75032 • (469) 402-7700
 Texas Registered Engineering Firm F-7449