


Revision	Date	Description

FONTANNA RANCH, LTD.
 6750 HILLCREST PLAZA DR., S. 325 • DALLAS, TX 75230 • 972-386-3333

**Fontanna
Ranch Ph. 2**

F.C. CUNY CORPORATION
 #2 Horizon Court • Ste. 300 • Heath, Texas 75032
 Phone: 469-402-7700
 Fax: 469-402-0700
 Texas Registered Engineering Firm F-7449

THE SEAL APPEARING ON THIS DOCUMENT WAS AUTHORIZED BY CHRISTOPHER R. CUNY, P.E. 65642

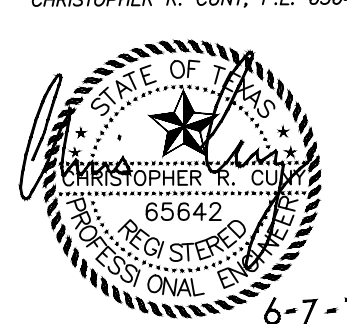

6-7-2017
 F.C. CUNY, CORPORATION
 F-7449

Drawn By: FC CUNY	Checked By: FC CUNY
Date: 4-16	Project No.:
Sheet Title: Lines 'B', 'J-1' & 'L' Sanitary Sewer Profiles	
Scale:	Sheet No.:
h : 1" = 40'	14 of 17
v : 1" = 4'	

RECORD DRAWING