


# DEVELOPMENT PLANS

# Fontanna Ranch Phase 3

## CITY OF ROCKWALL, TEXAS

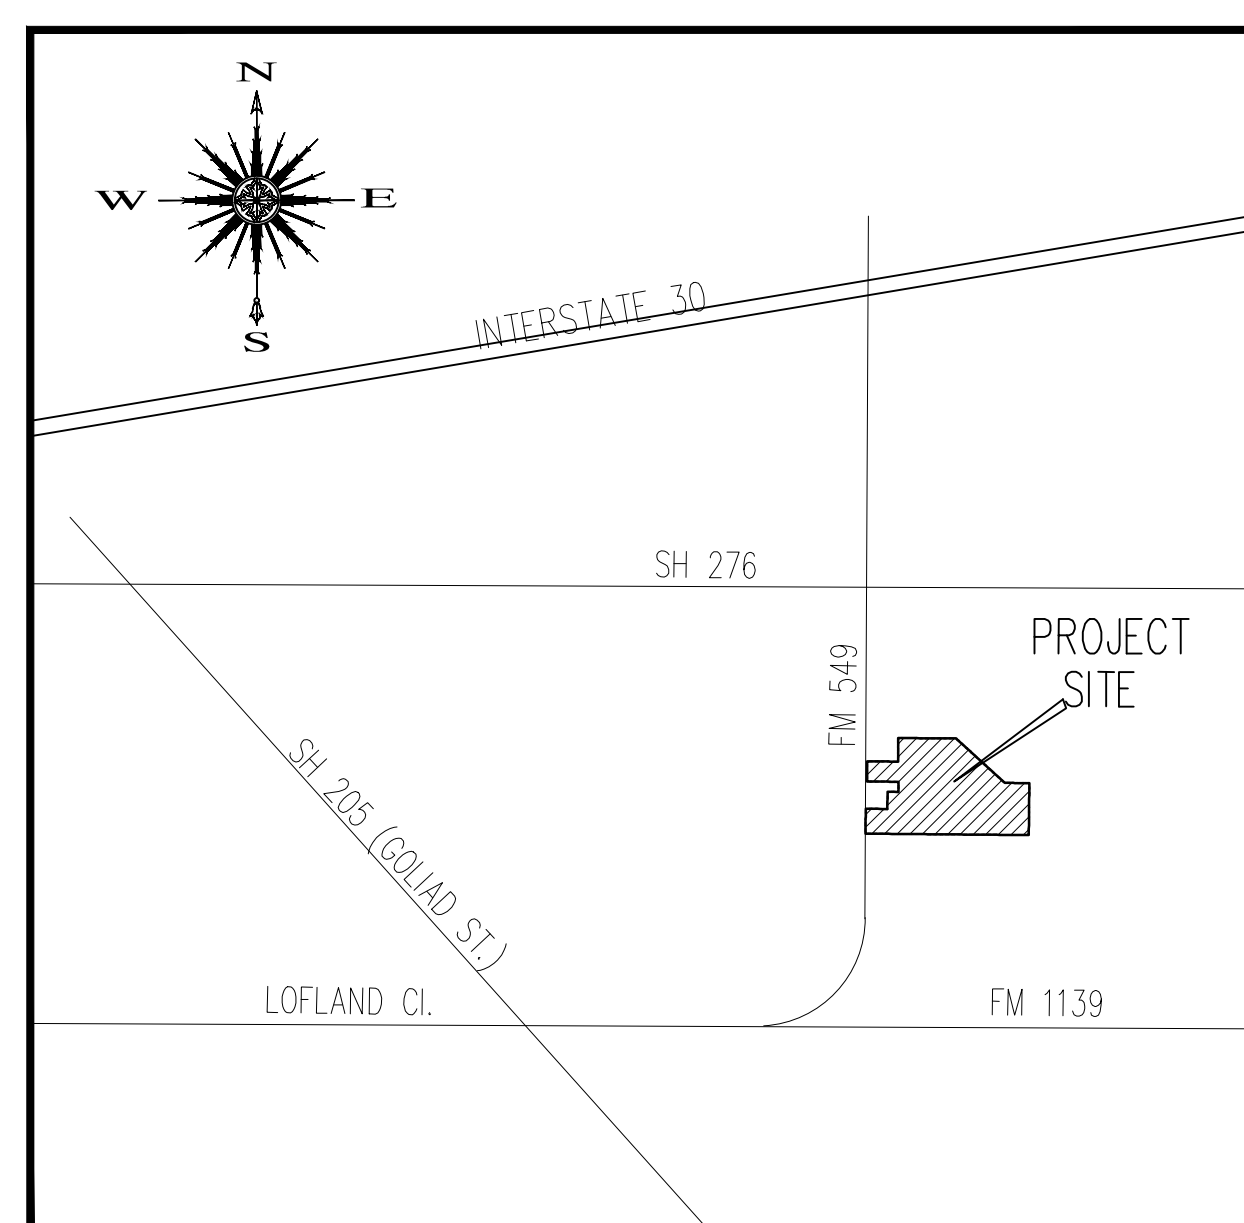

LOCATION MAP

### INDEX of SHEETS

Sheet No.	Title
1	Cover Sheet
2 & 3	Final Plat
4-6	Paving Plan & Profiles
7-8	Grading Plan
9	Drainage Area Map
9a	Pre Development Drainage Conditions
10-11	Detention Pond Sheet
12-13	Storm Sewer Plan & Profiles
14	Water and Sewer Plan
15-16	Sanitary Sewer Profiles
17	Erosion Control Plan
18	Lighting and Signage Plan

## RECORD DRAWINGS

## September 11, 2018

Applicant ~ Developer  
Fontanna Ranch, Ltd.  
6750 Hillcrest Plaza Dr.  
Suite 325  
Dallas Texas 75230  
(972) 386-3333

THE SEAL APPEARING ON THIS DOCUMENT WAS AUTHORIZED BY CHRISTOPHER R. CUNY, P.E. 65642



F.C. CUNY CORPORATION  
F-7449

~ Engineer ~



**F.C. CUNY CORPORATION**

#2 Horizon Court • Heath, Texas 75032 • (469) 402-7700  
Texas Registered Engineering Firm F-7449