


DEVELOPMENT PLANS
Fontanna Ranch
 CITY OF ROCKWALL, TEXAS

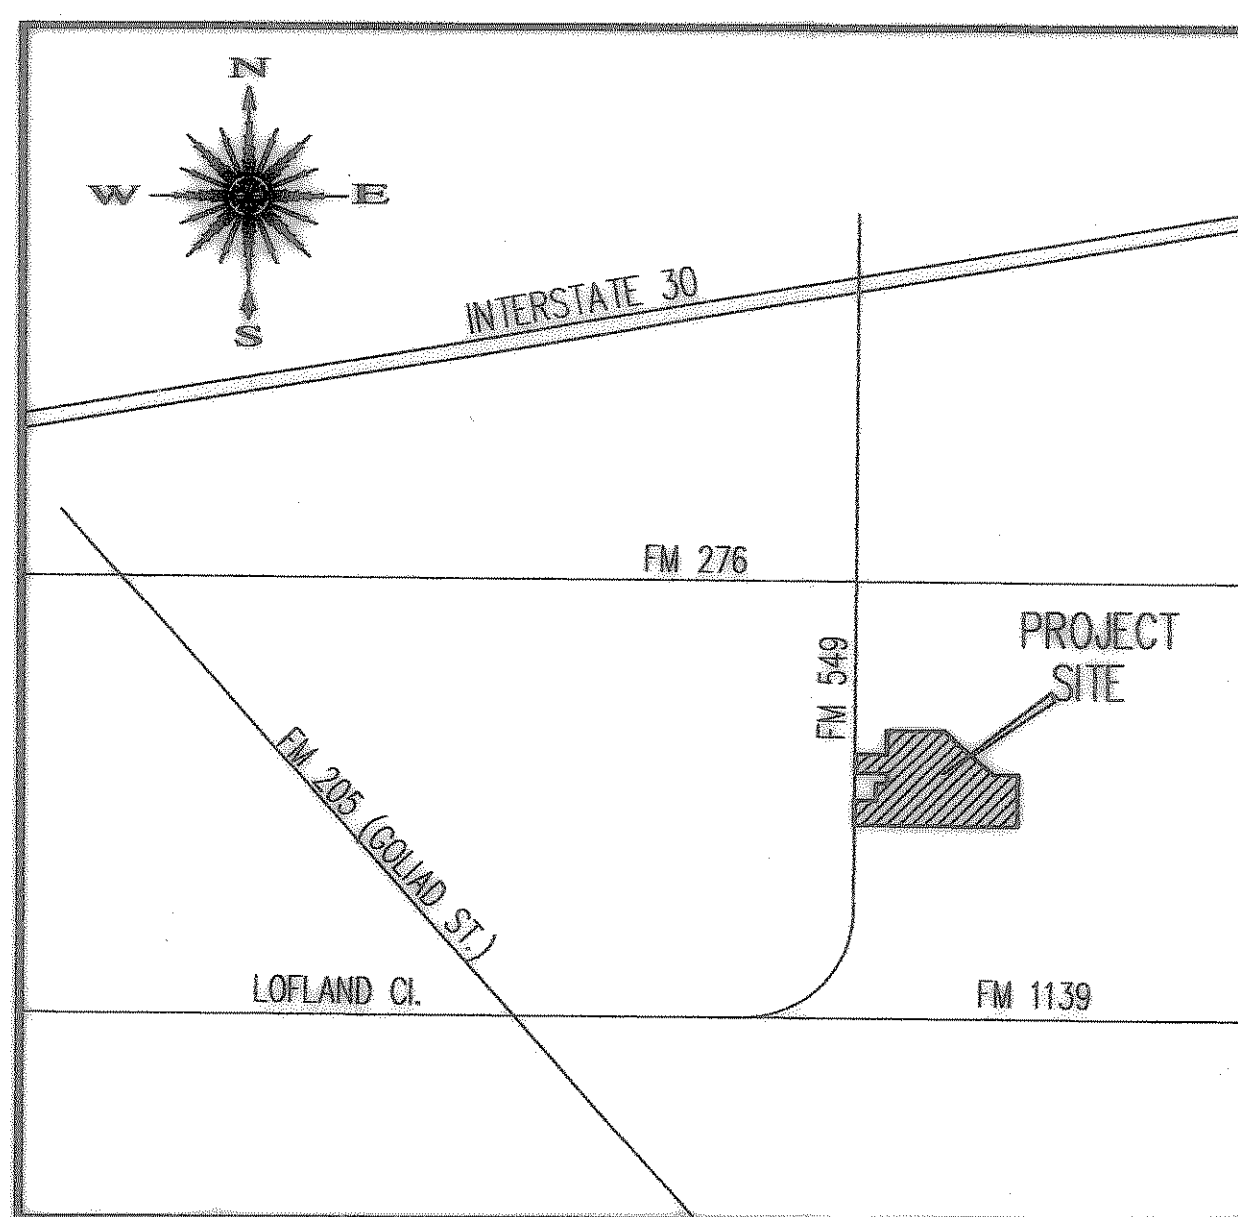


LOCATION MAP

INDEX of SHEETS

<u>Sheet No.</u>	<u>Title</u>
1	Cover Sheet
2-5	Final Plat
6-14	Paving Plan & Profile
15-16	F.M. 549 Access Plan
17-20	Grading Plan
21	Drainage Area Map
22	OS Ditch Plan
23	Detention and Retention Pond Calculations
24-28	Storm Sewer Plan & Profiles
29	Storm Sewer Laterals
30	Water and Sewer Plan
31-32	Offsite Sanitary Sewer Plan
33-36	Lift Station Detail
37	Lift Station Site Plan
38-43	Sanitary Sewer Profiles
44	S.W.P.P.P.
45	Lighting and Signage Plan

THE SEAL APPEARING ON THIS DOCUMENT WAS AUTHORIZED BY CHRISTOPHER R. CUNY, P.E. 65642

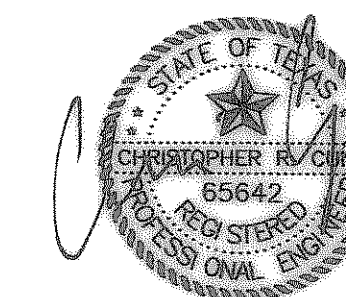

8-22-2007

Applicant ~ Developer
 Spring Haven Investments, Inc.
 6750 Hillcrest Plaza Dr.
 Suite 305
 Dallas Texas 75230
 (972) 368-3333

Construction Record Drawings

PROJECT # 05-013
 August 22, 2007

~ Engineer ~
F.C. CUNY CORPORATION
 #2 Horizon Court • Heath, Texas 75032 • (469) 402-7700