

Detention Pond A

MODIFIED RATIONAL METHOD DETENTION VOLUME CALCULATIONS- Detention Pond "A"
(10ac. School Site & 9.3 ac. Sheet flow from subdivision)

Return Period	Existing					Proposed				
	Existing Area	T _c	i	c	Q _{inlet}	Detained Area	T _c	i	c	Q _p
100	19.30	20	8.30	0.35	56.07	19.30	10	9.80	0.60	113.5

Modified Rational Calculations
Return Period 100
Q_{allow}³ 56.07
T_c prop (min) 10

T _d (min)	I (in/hr)	CA	Q _p (cfs)	Vol _{in} (ft ³)	Vol _{out} (ft ³)	Total Storage
10	9.8	11.580	113.48	68090	33640	34451
20	8.3	11.580	96.11	115337	50460	64877
30	6.82	11.580	78.98	142156	67280	74876
40	5.8	11.580	67.16	161194	84100	77094
50	5	11.580	57.90	173700	100920	72780
60	4.44	11.580	51.42	185095	117740	67355
70	3.98	11.580	46.09	193571	134560	59012
80	3.62	11.580	41.92	201214	151380	49835
90	3.32	11.580	38.45	207806	169200	39407

Example (40 min)
Inflow Volume = T_d*Q_p*60 = 40min*67.16cfs*60sec/min = 161,194 ft³
Outflow Volume = 0.5*(T_d+T_c)*Q_{allow}*60 = 0.5*(40+10)min*56.07cfs*60sec/min = 84,100 ft³
Storage Volume = Inflow Volume - Outflow Volume = 161,194 ft³ - 84,100 ft³ = 77,094 ft³
* numerical difference is due to rounding

Detention Pond B


MODIFIED RATIONAL METHOD DETENTION VOLUME CALCULATIONS

Return Period	Existing					Proposed				
	Existing Area	T _c	i	c	Q _{inlet}	Detained Area	T _c	i	c	Q _p
100	27.00	20	8.30	0.35	78.44	27.00	10	9.80	0.50	132.3

Modified Rational Calculations
Return Period 100
Q_{allow}³ 78.44
T_c prop (min) 10

T _d (min)	I (in/hr)	CA	Q _p (cfs)	Vol _{in} (ft ³)	Vol _{out} (ft ³)	Total Storage
10	9.8	13.500	132.30	79380	47061	32319
20	8.3	13.500	112.05	134460	70592	63868
30	6.82	13.500	92.07	165726	94122	71604
40	5.8	13.500	78.30	187920	117853	70268
50	5	13.500	67.50	202500	141183	61317
60	4.44	13.500	59.94	215784	164714	51071
70	3.98	13.500	53.73	225666	188244	37422
80	3.62	13.500	48.87	234576	211775	22802
90	3.32	13.500	44.82	242028	235305	6723

Example (80 min)
Inflow Volume = T_d*Q_p*60 = 80min*48.87cfs*60sec/min = 14,304 ft³
Outflow Volume = 0.5*(T_d+T_c)*Q_{allow}*60 = 0.5*(80+10)min*1.69cfs*60sec/min = 4563 ft³
Storage Volume = Inflow Volume - Outflow Volume = 14,304 ft³ - 4563 ft³ = 9,741 ft³
* numerical difference is due to rounding

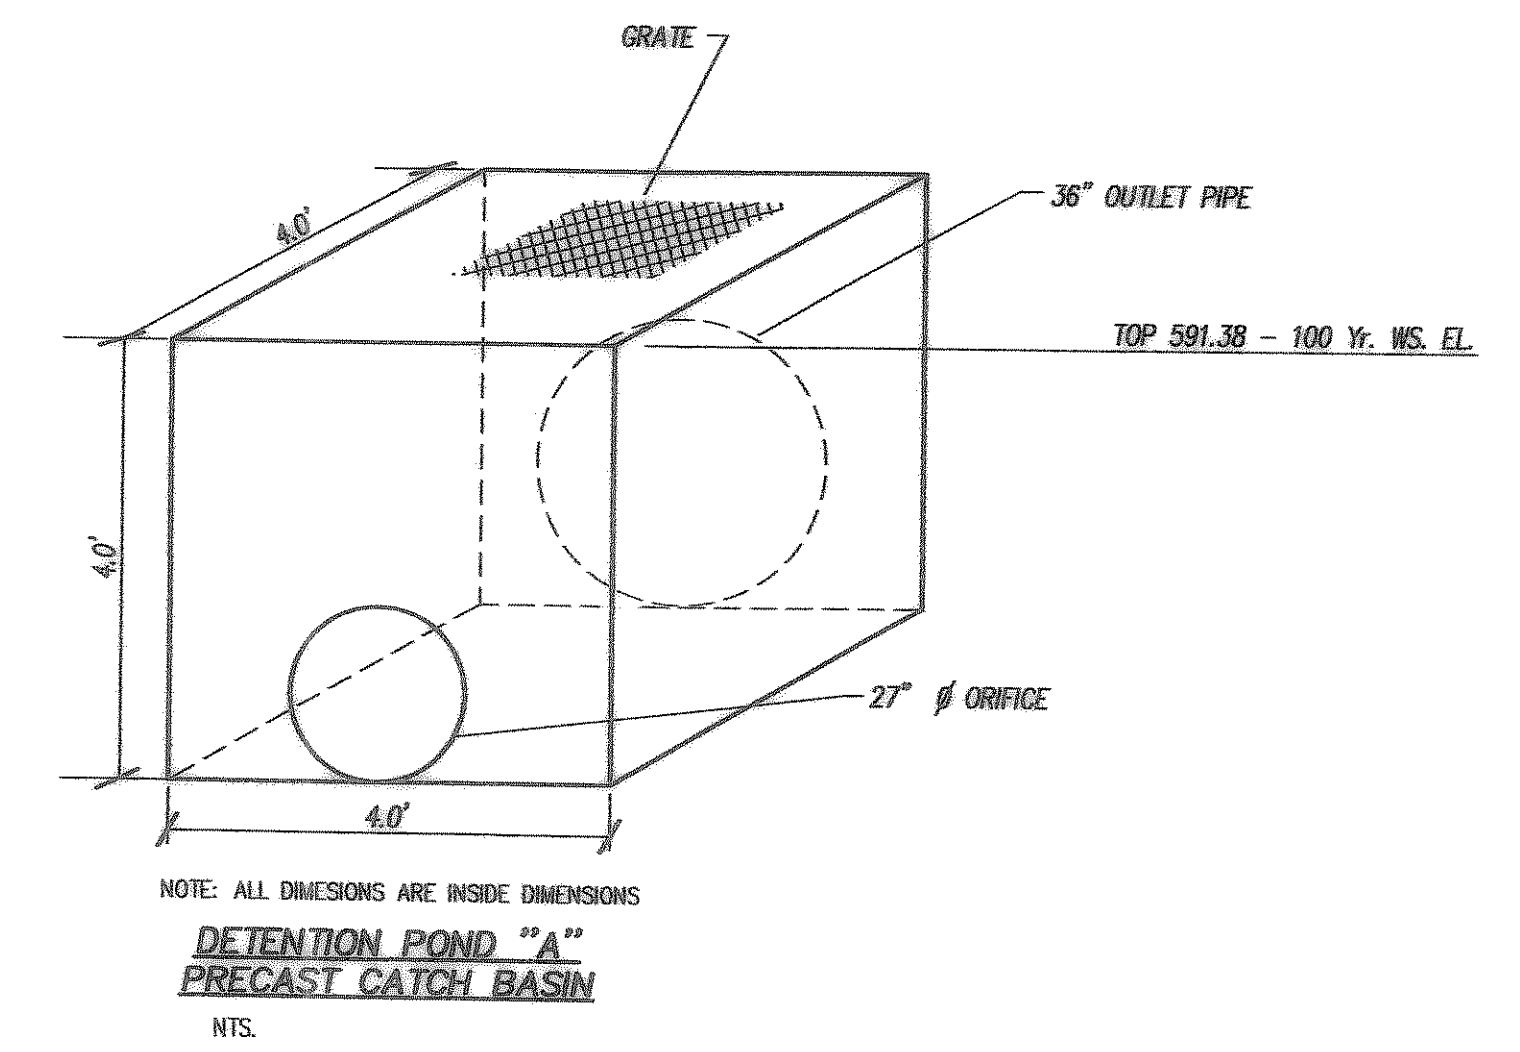

Detention Pond A
Pond Storage Volume Required = 77,094 cubic feet
Pond Storage Volume Provided = 108,252 cubic feet

Detention Pond A Storage Calculations

Elevation	Area (ft ²)	Average Area (ft ²)	Incremental Storage (ft ³)	Cumulative Storage (ft ³)
587	0	0	0	0
587.5	486	243	121.5	121.5
588	5507	2996.5	1498.25	1619.75
589	10858	8182.5	8182.5	9802.25
590	23294	17076	17076	26878.25
591	39530	31412	31412	58290.25
592	60393	49961.5	49961.5	108251.75

Detention Pond A Summary

Return Period (yrs)	Required			
	Q _{allow} (cfs)	Storage (ft ³)	Min. Pond Elevation (ft)	Q _{released} at Min. Pond Elev. (cfs)
10	39.11	52501	590.82	34.8
25	44.85	61397	591.06	41.6
50	49.99	69538	591.22	47.8
100	56.07	77094	591.38	55.05



Detention Pond B
Pond Storage Volume Required = 71,604 cubic feet
Pond Storage Volume Provided = 75,919 cubic feet

Detention Pond B Storage Calculations

Elevation	Area (ft ²)	Average Area (ft ²)	Incremental Storage (ft ³)	Cumulative Storage (ft ³)
564	36000	0	0	0
565	41250	38625	38625	38625
565.85	46500	43875	37294	75919

Detention Pond B Summary

Return Period (yrs)	Required			
	Q _{allow} (cfs)	Storage (ft ³)	Min. Pond Elevation (ft)	Q _{released} at Min. Pond Elev. (cfs)
10	54.72	50009	565.29	48.3
25	62.75	57866	565.47	58.8
50	69.93	65772	565.65	69.9
100	78.44	71604	565.78	78.4

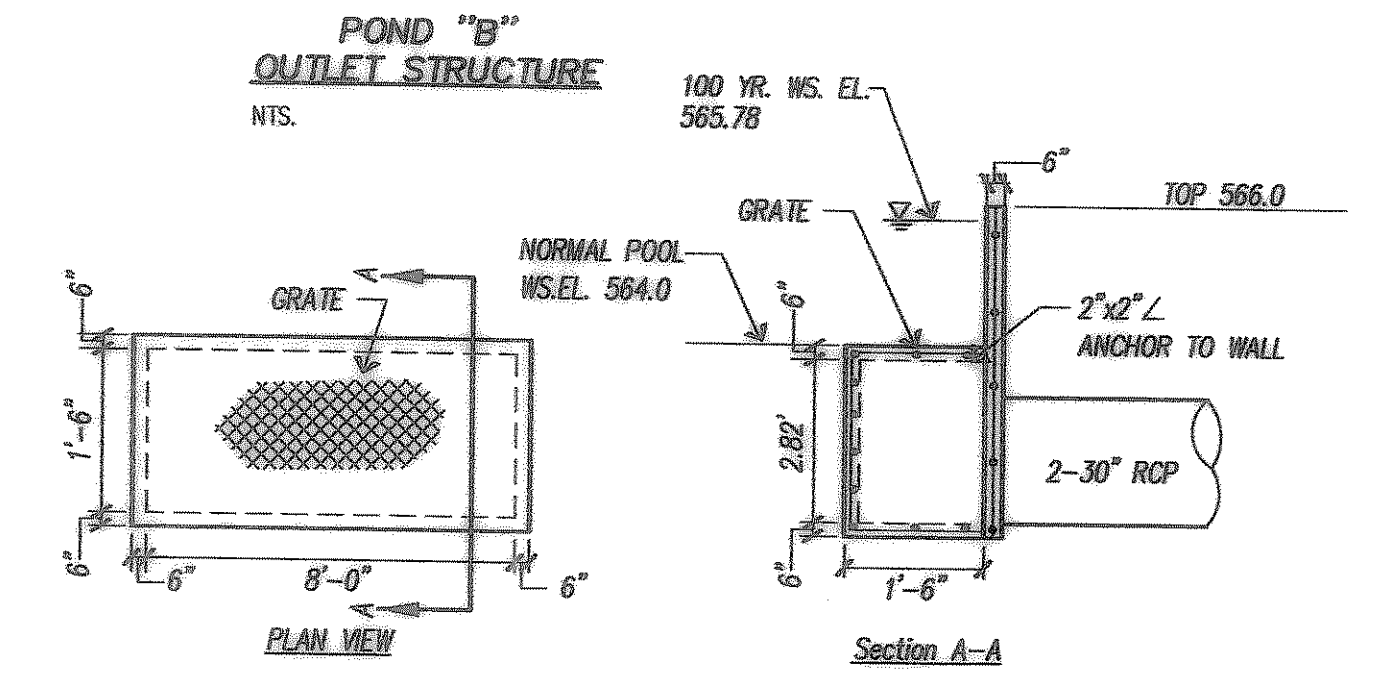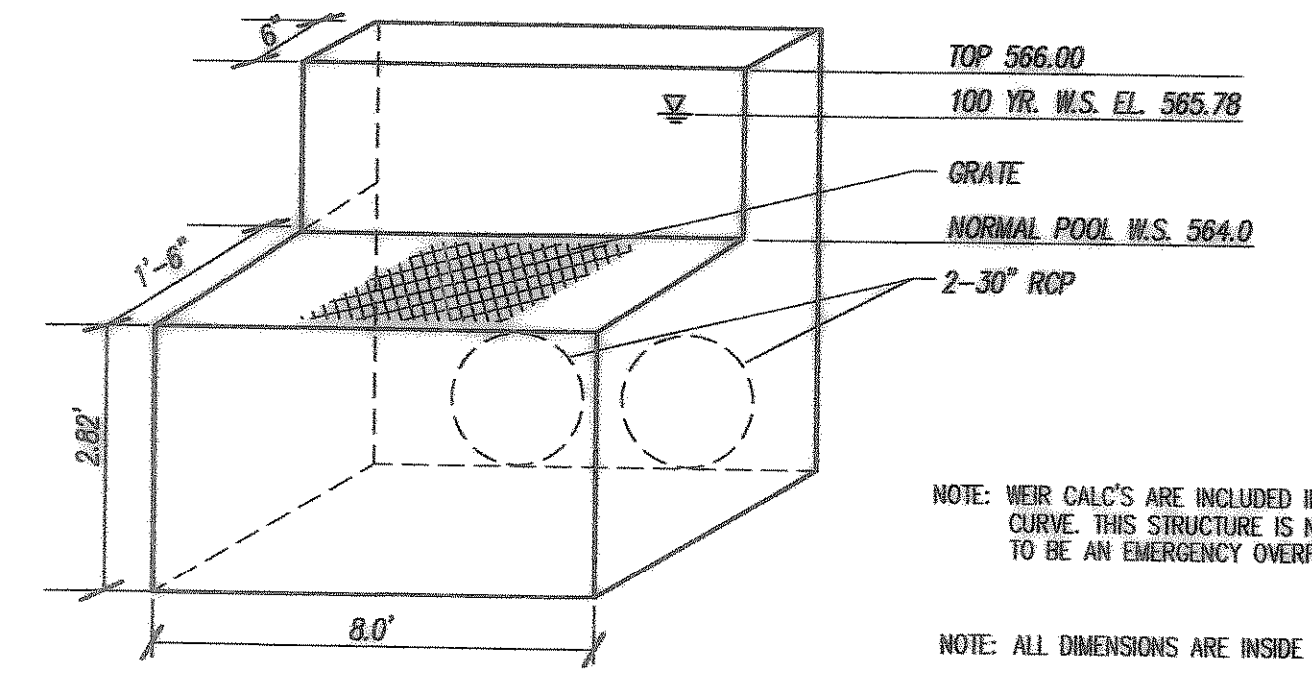

NOTE: ALL REINF. SHALL BE #3 BARS ON 12\"/>

THE SEAL APPEARING ON THIS DOCUMENT WAS AUTHORIZED BY CHRISTOPHER R. CUNY, P.E. 65642



Construction Record Drawing
8-22-2007

Detention and Retention	
Pond calculations	
Fontanna Ranch	
City of Rockwall, Rockwall County, Texas	
Spring Haven Investments, Inc.	
<small>6750 Hillcrest Plaza Dr. • Suite 305 • Dallas, Texas 75230 • 972.386.3333</small>	
F.C. CUNY CORPORATION	
<small>#2 Horizon Court • Heath, Texas 75032 • 469-402-7700</small>	
Drawn By: NSC	Checked By: DJW
Date: 10/18/06	Scale: No Scale
Project No.: 05-013	Sheet No.: 23 of 45