



NTS
 Slope = 0.40% Min.
 $n = 0.03$
 $h = 1.5'$
 $Q = 1.486/0.03 \times A \times A'/sp \times 51/2$
 $Q = 32.77$ cfs Cap.
 $Q = 31.67$ cfs Exist.

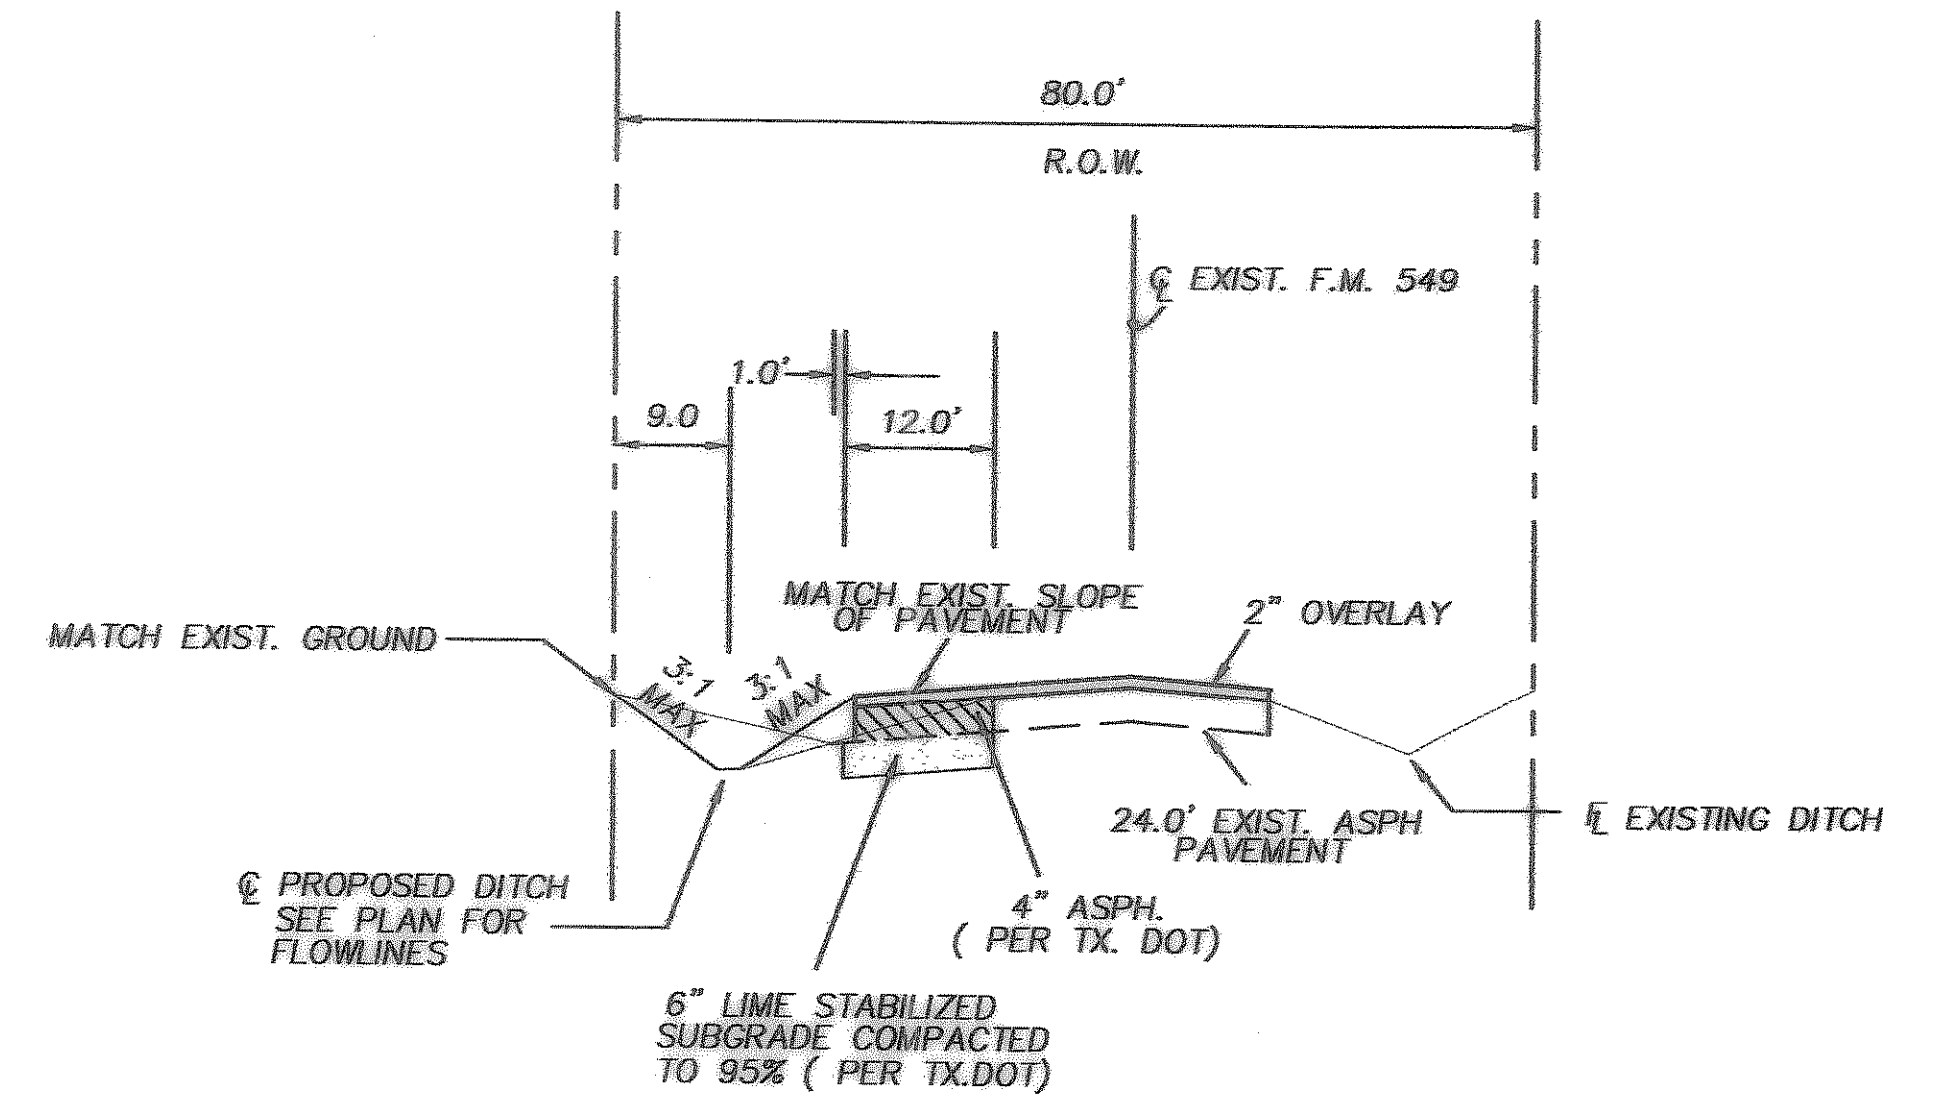


SECTION A-A
 NTS

MATCHLINE (SEE SHEET 16)

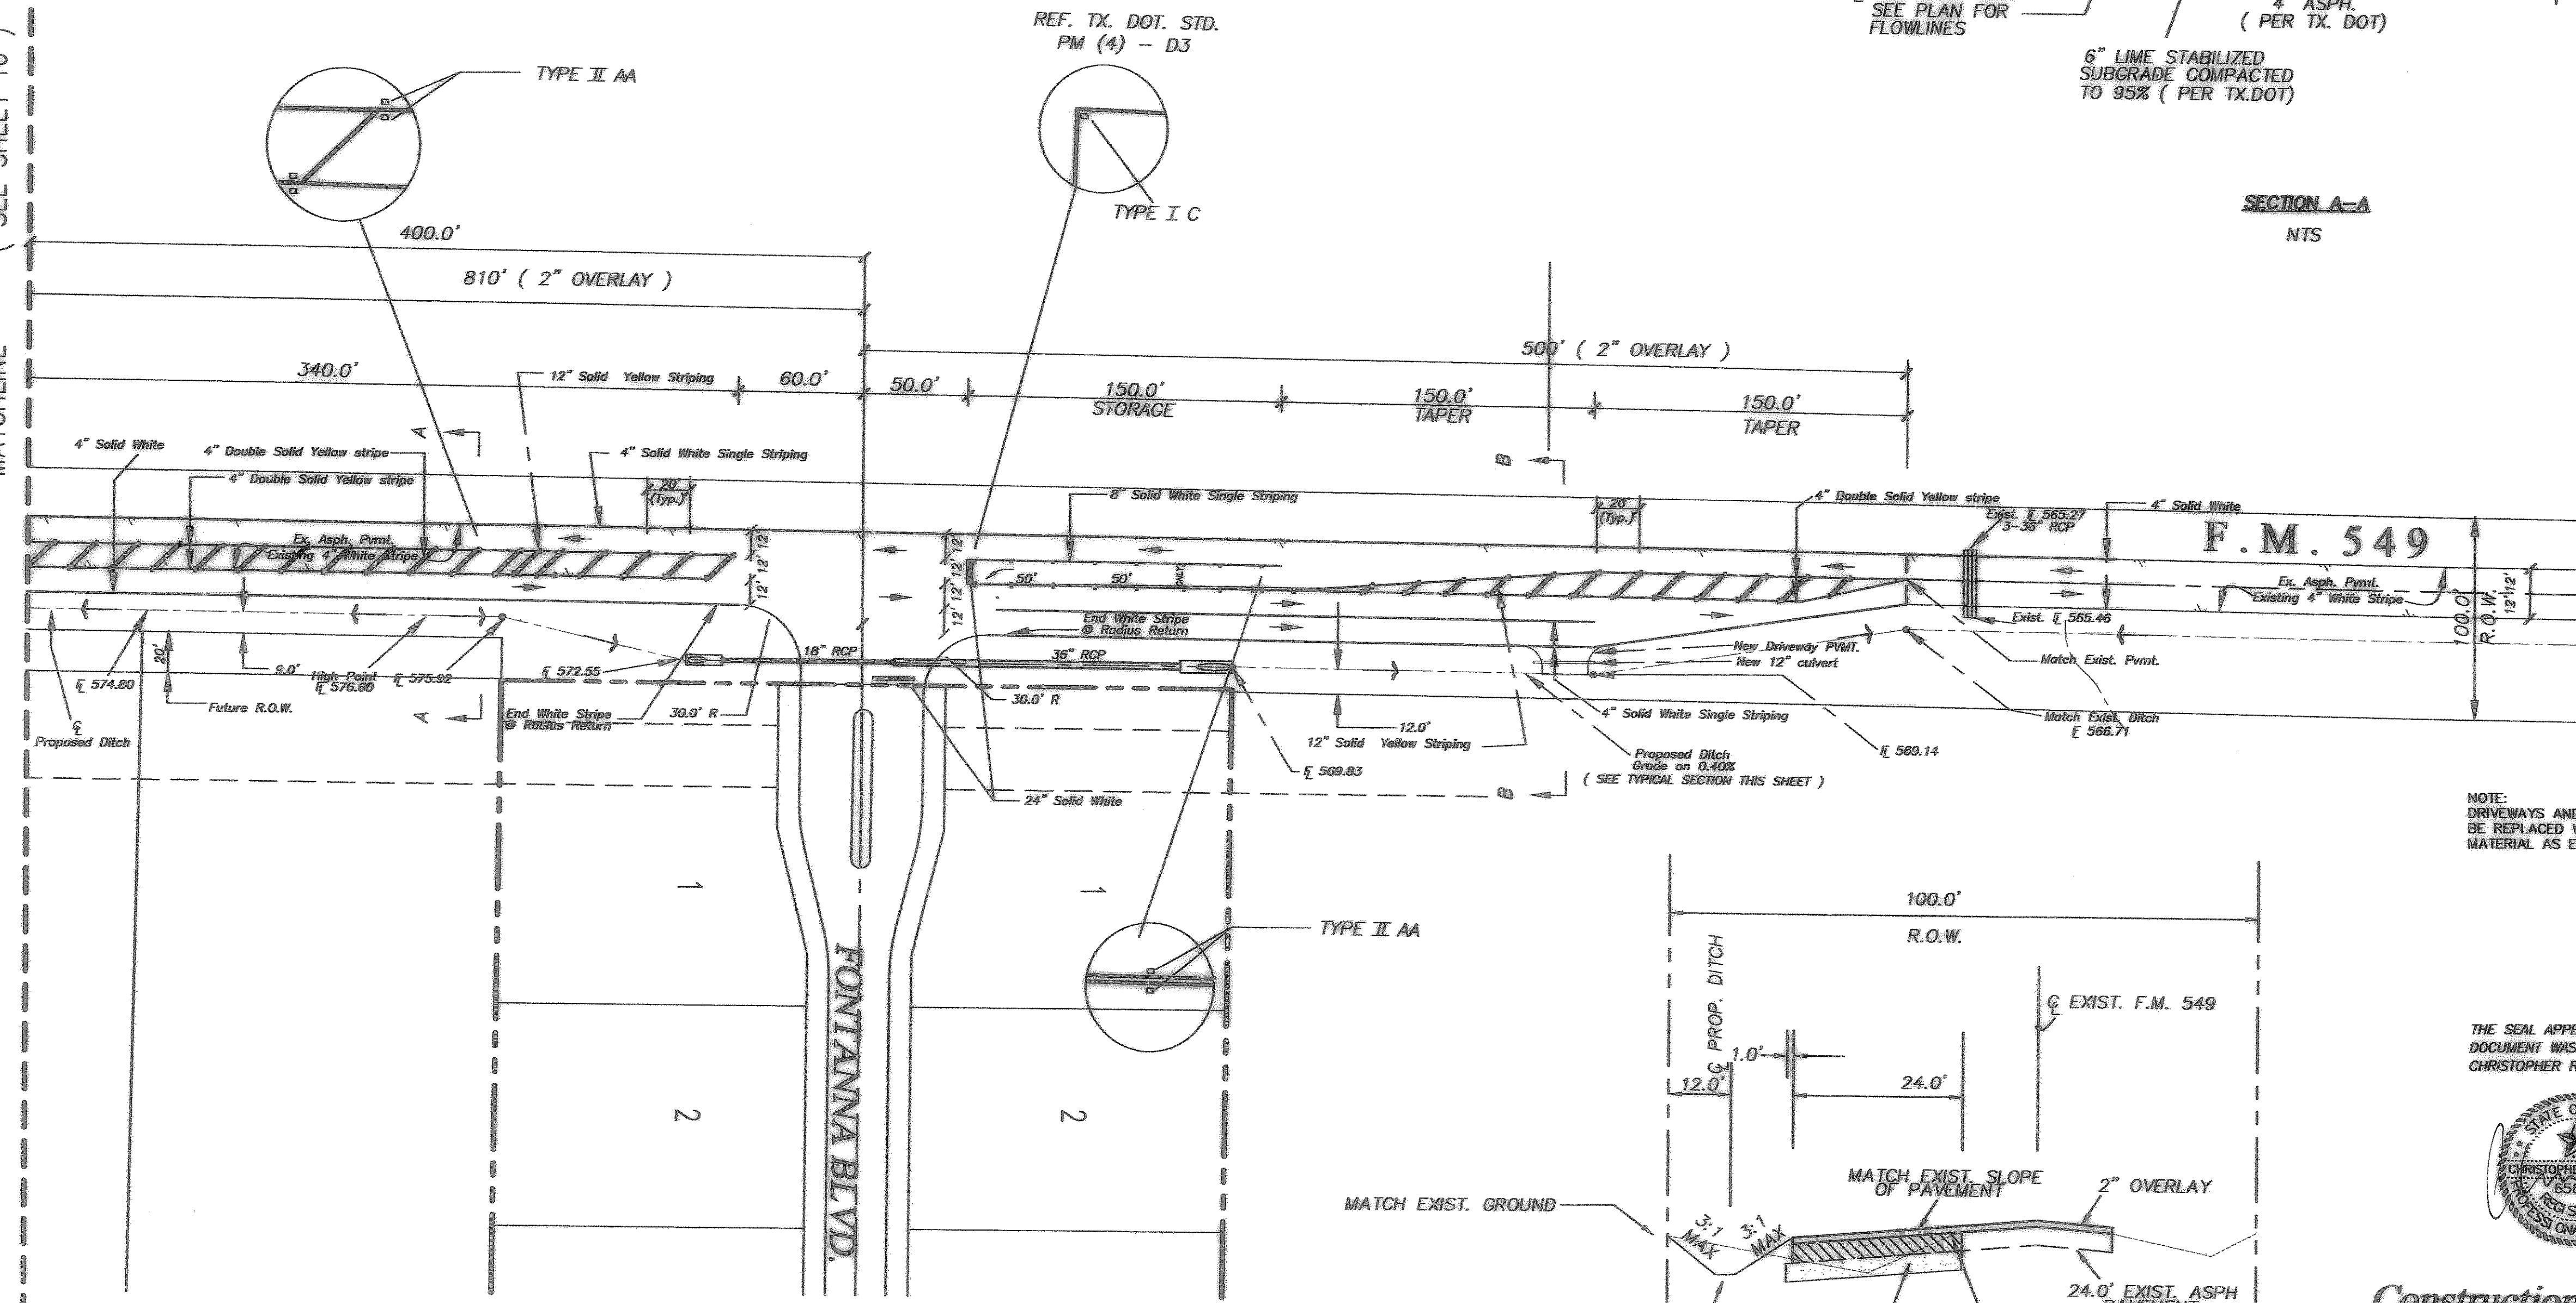


NOTE: DRIVEWAYS AND CULVERTS TO BE REPLACED WITH SAME MATERIAL AS EXISTING.

THE SEAL APPEARING ON THIS DOCUMENT WAS AUTHORIZED BY CHRISTOPHER R. CUNY, P.E. 65642

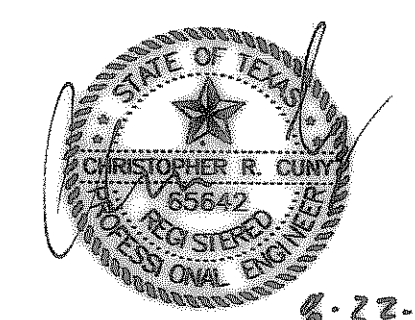

Construction Record Drawing
 8-22-2007

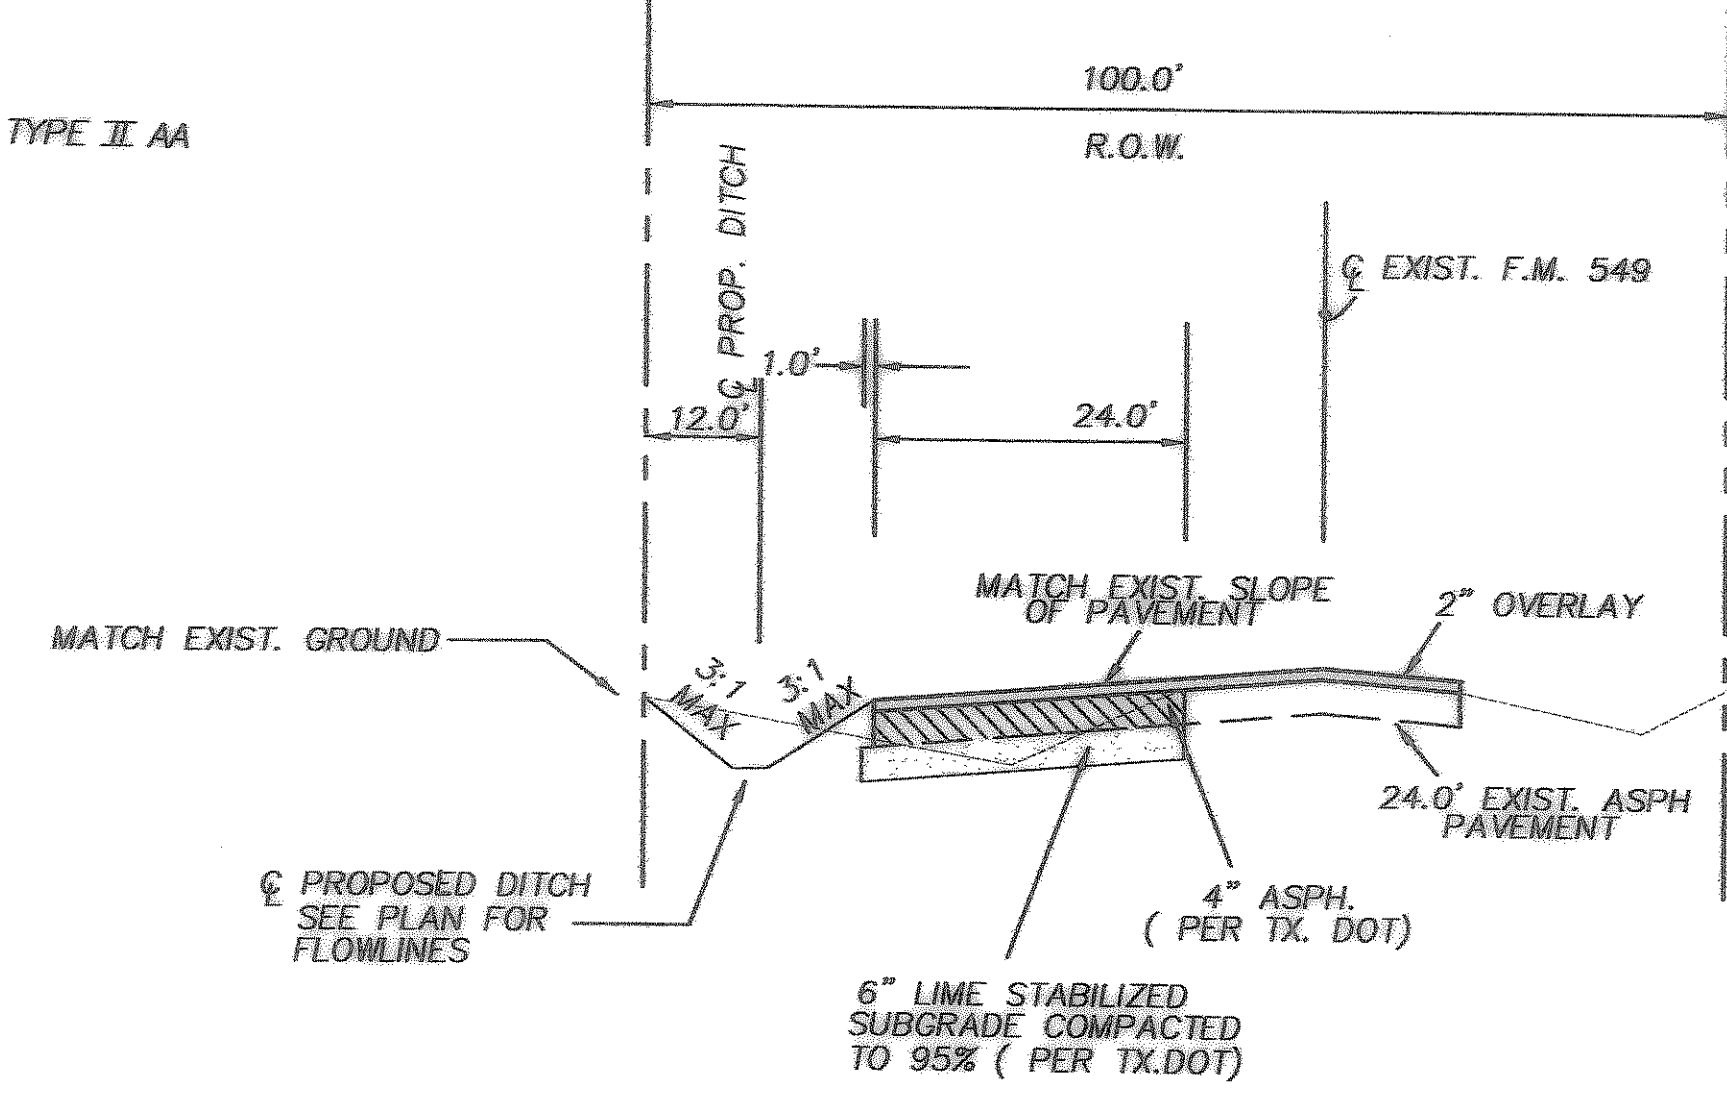

SECTION B-B
 NTS

| | | | | | |
|---|-------------|----------|--------|--------------|------------|
| F.M. 549 ACCESS PLAN | | | | | |
| Fontanna Ranch | | | | | |
| City of Rockwall, Rockwall County, Texas | | | | | |
| Spring Haven Investments, Inc. | | | | | |
| 6750 Millcrest Plaza Dr. • Suite 305 • Dallas, Texas 75230 • 972.386.3333 | | | | | |
| | | | | | |
| #2 Horizon Court • Heath, Texas 75032 • 469-402-7700 | | | | | |
| Drawn By: | Checked By: | Date: | Scale: | Project No.: | Sheet No.: |
| MSC | DM | 10/16/06 | 1"-50' | 05-013 | 15 of 45 |