

Z:\Projects\6-Residential\Fontanna Record Drawings\font-sane.dwg Wed Aug 22 11:57:02 2007


0+00 LINE "H" = 2+97.95 LINE "B-2"
CONSTRUCT 4.0' DIA. M.H.
RIM EL. 584.00
2520 PROP. 24" STORM

2+41.54 LINE "H"
CONSTRUCT 4.0' DIA. M.H.
RIM EL. 584.60


3+71.92 LINE "H"
CONSTRUCT 4.0' DIA. M.H.
RIM EL. 586.80

5+34.21 LINE "H"
CONSTRUCT 4.0' DIA. M.H.
RIM EL. 588.00

6+46.28 END LINE "H"
INSTALL CLEWOUT
TOP 800.65

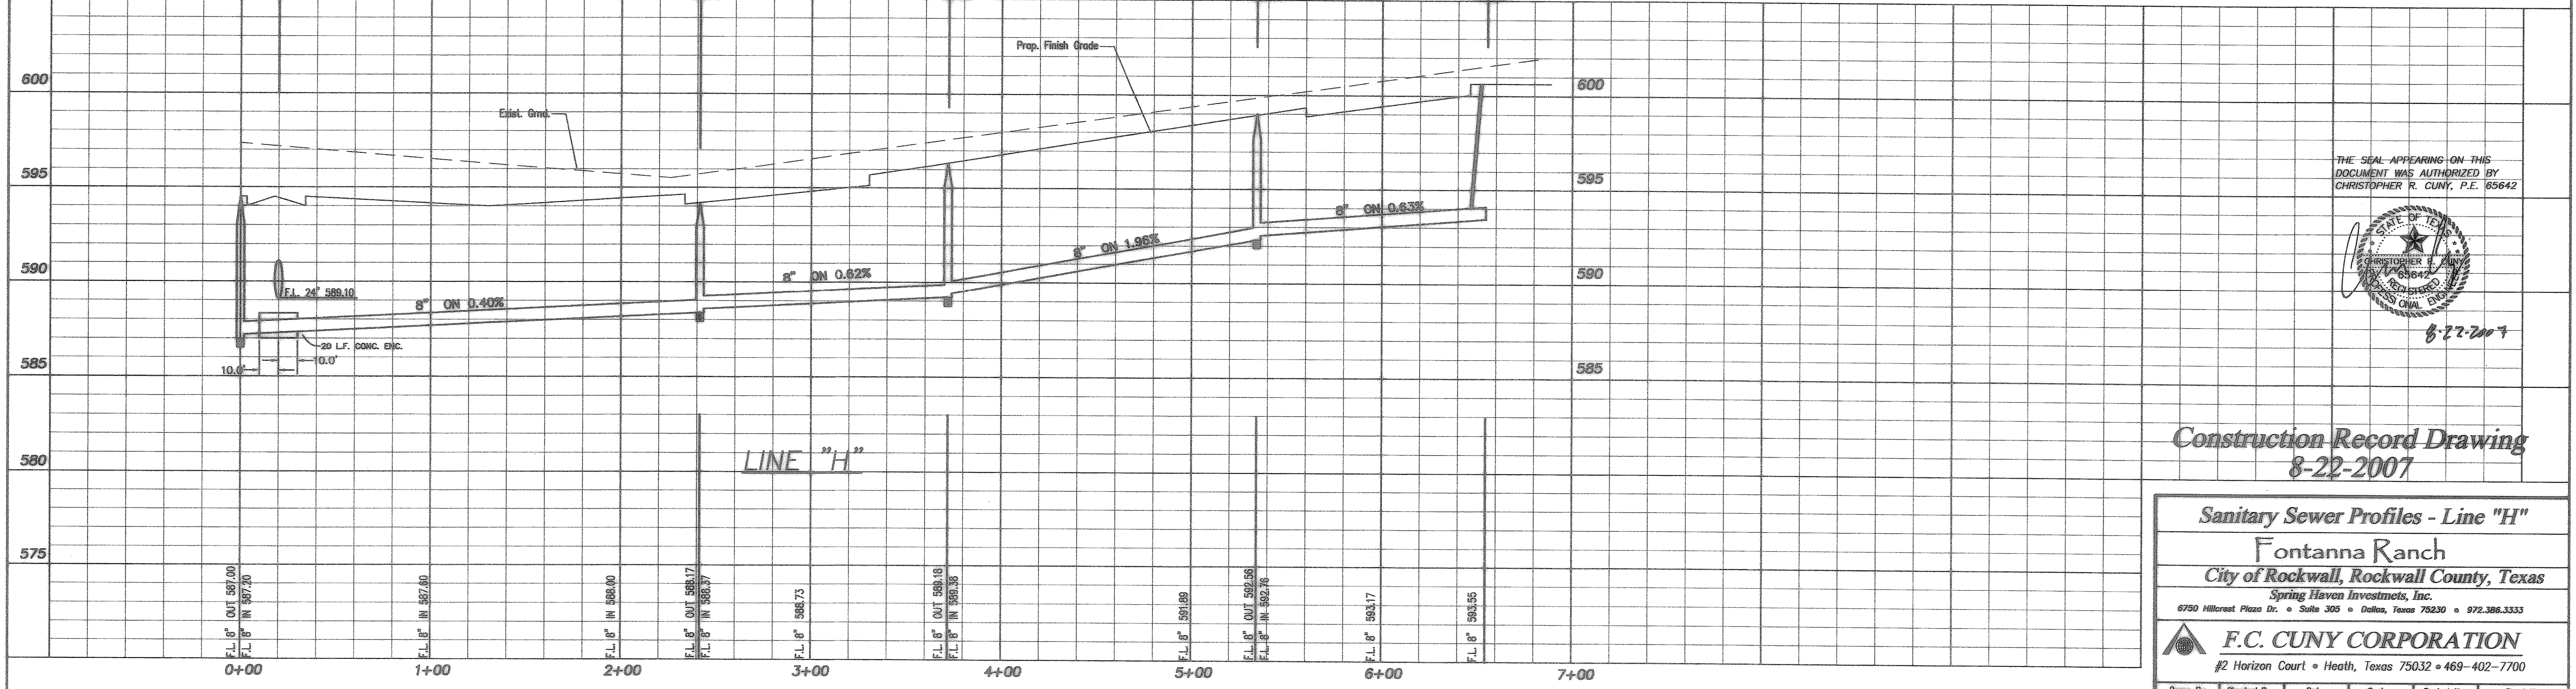

THE SEAL APPEARING ON THIS DOCUMENT WAS AUTHORIZED BY CHRISTOPHER R. CUNY, P.E. 65642

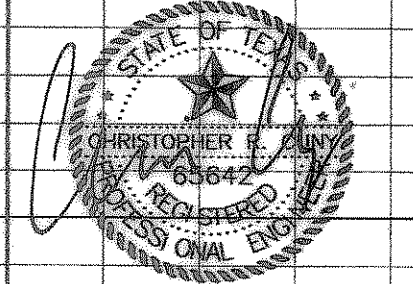

8-22-2007

Construction Record Drawing 8-22-2007

Sanitary Sewer Profiles - Line "H"
Fontanna Ranch
 City of Rockwall, Rockwall County, Texas
 Spring Haven Investments, Inc.
 6750 Hillcrest Plaza Dr. • Suite 305 • Dallas, Texas 75230 • 972.366.3333

F.C. CUNY CORPORATION
 #2 Horizon Court • Heath, Texas 75032 • 469-402-7700

Drawn By:	Checked By:	Date:	Scale:	Project No.:	Sheet No.:
MSC	DW	10/18/06	H:1"=40' V:1"=4'	05-013	43 of 45