




NO.	REVISION	DATE
1	CR# 2	4/24
2		
3		
4		
5		
6		
7		
8		
9		
10		

ARTECH
DESIGN GROUP INC.


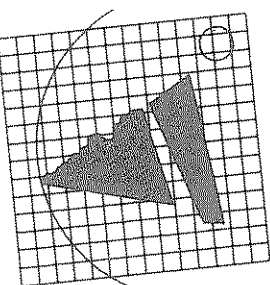


2525 Broad Street, Suite 201, Charleston, TN 37608 615/265-4333 Fax 615/265-5413

FOOD LION, INC.
F.M. 740 @ F. M. 3097
Rockwall County
Rockwall, Texas

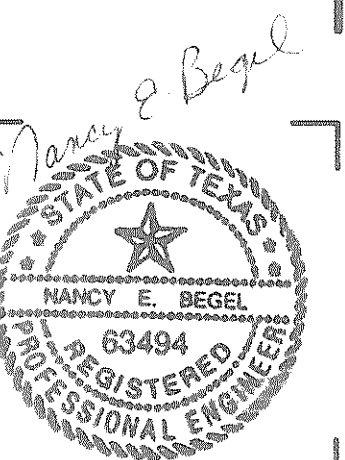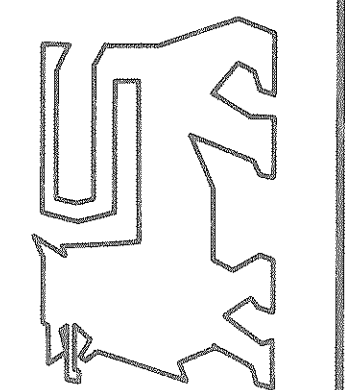

JOB NO.	06416.01
DATE	4-1-91
DRAWN	M.F.L.
CHK	N.E.B.
DISC	6416PROF.DWG
SHEET	C-4
UTILITY PROFILES	

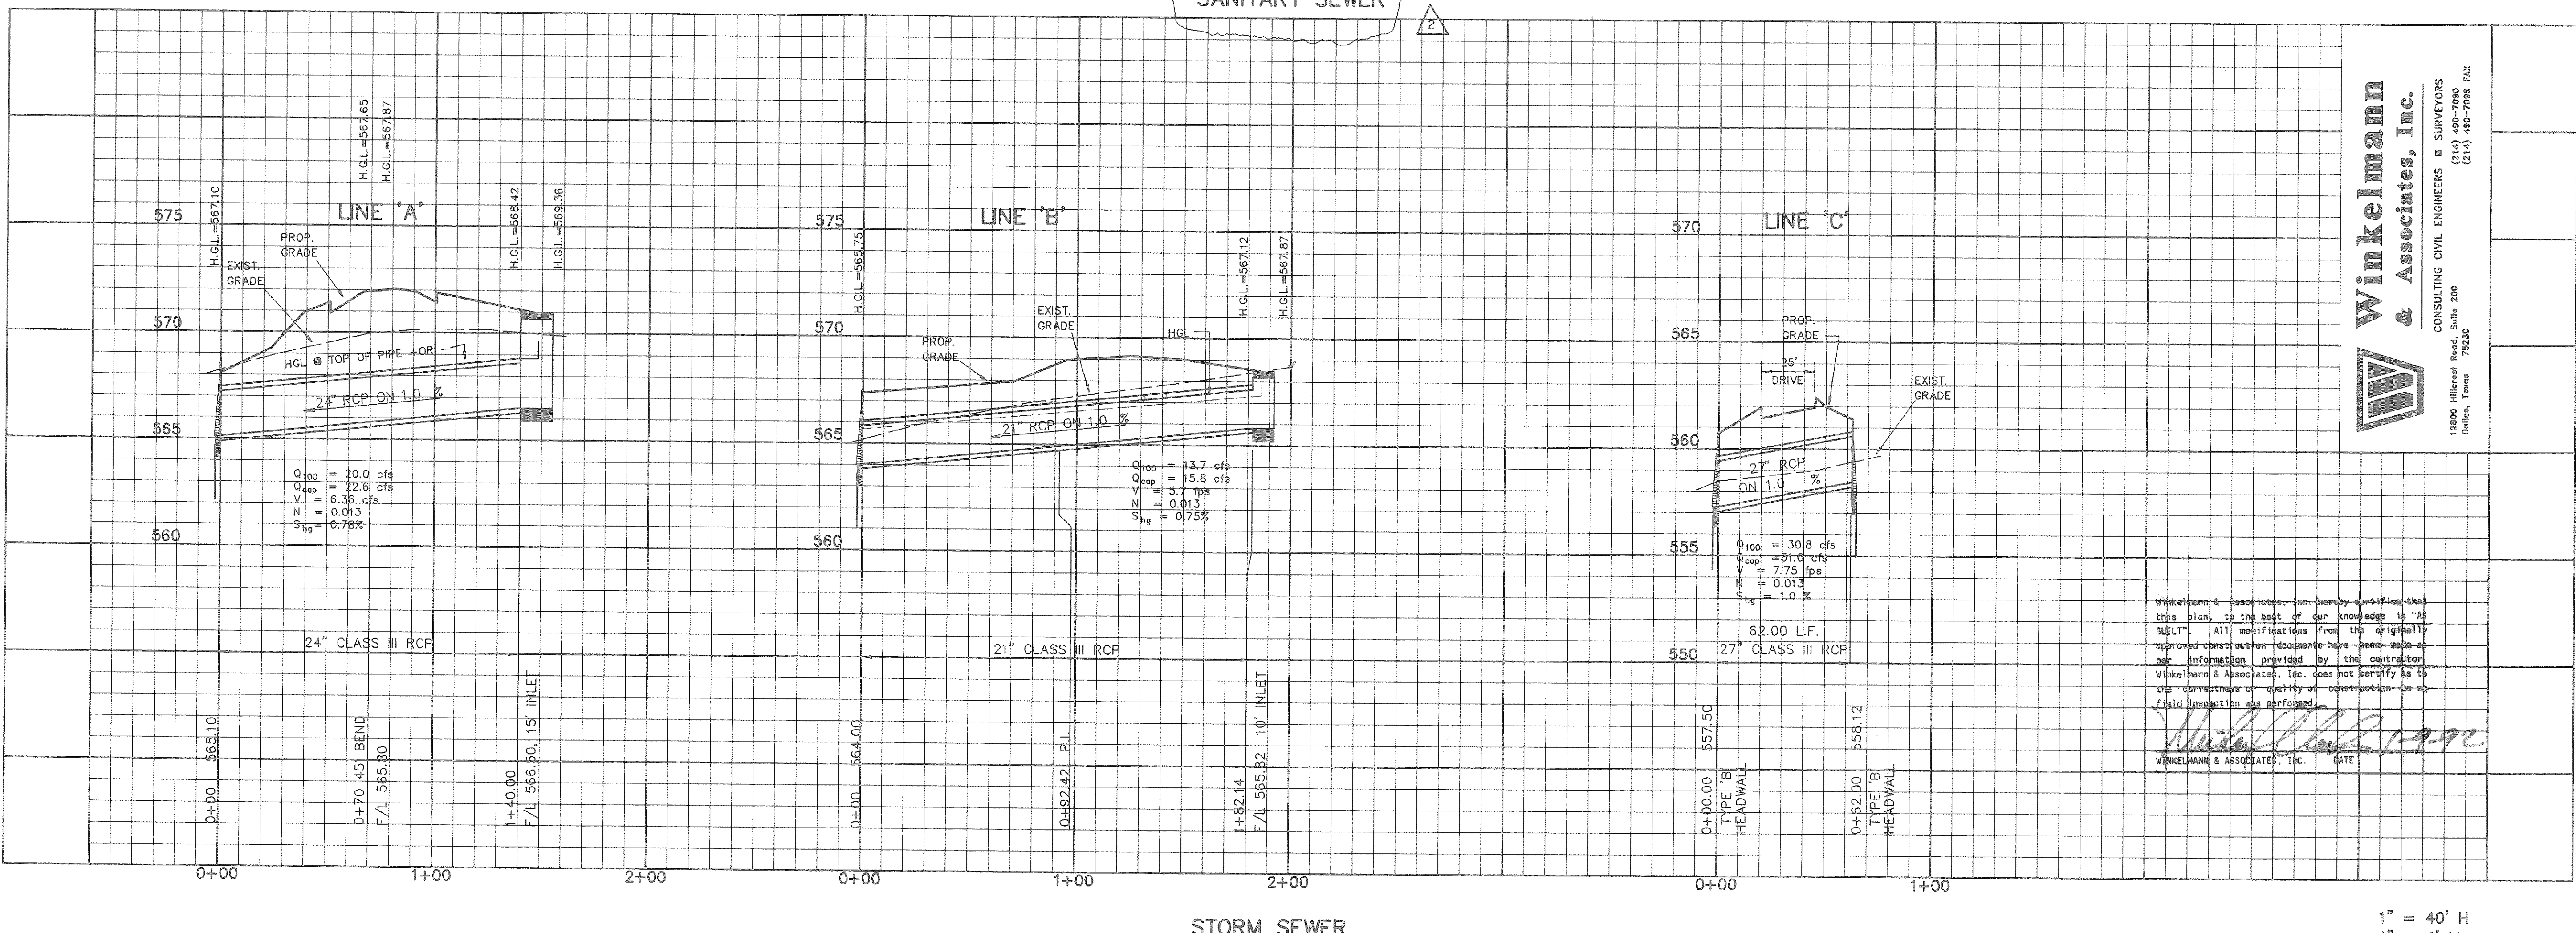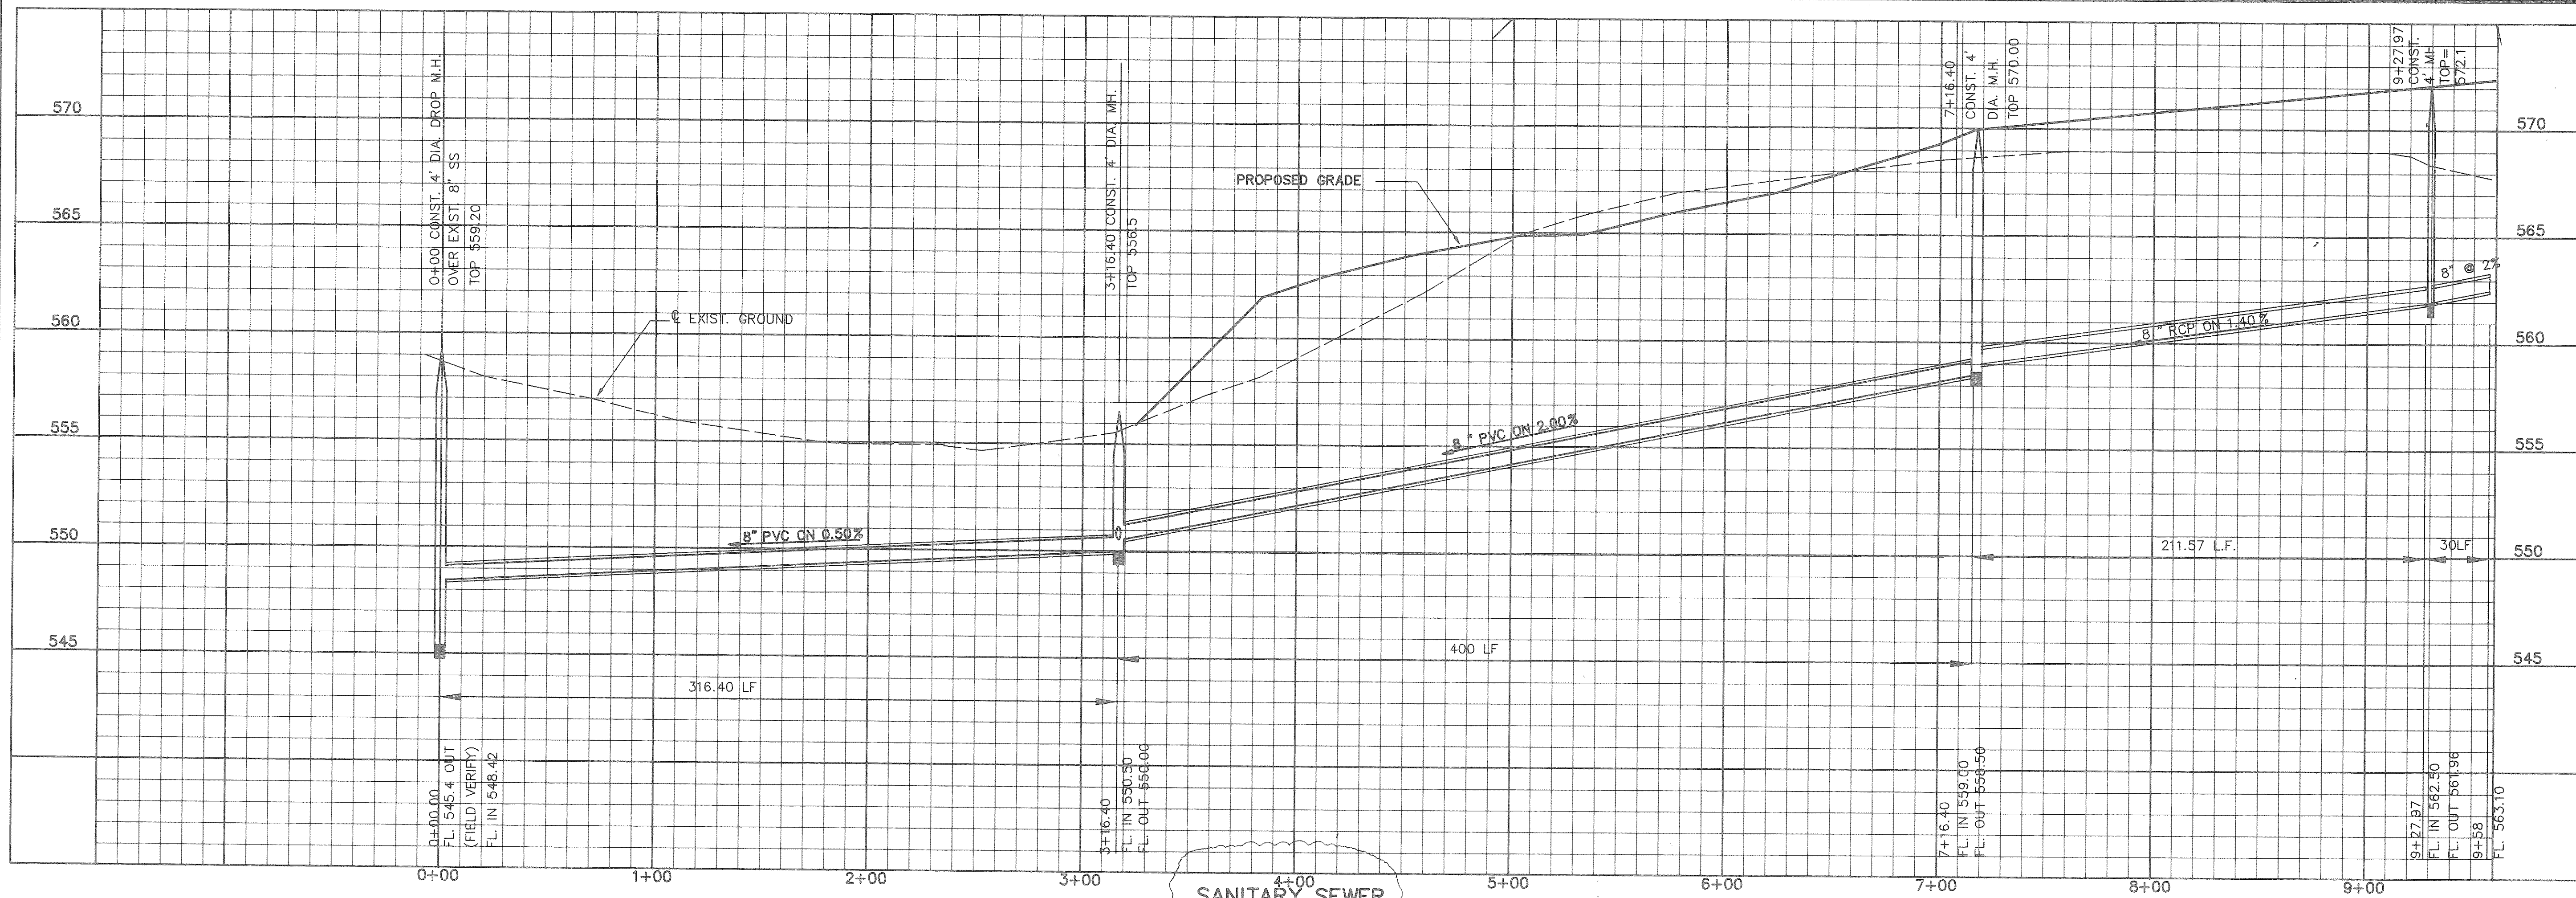

1" = 40' H
1" = 4' V