


MPP
MICHAEL PEEPLES
Engineers and Planners
(214) 248-1968
4660 Sunbelt Dallas, Texas 75248



ALL WORK AND MATERIALS SHALL BE IN ACCORDANCE WITH CITY OF ROCKWALL STANDARDS AND SPECIFICATIONS.

TRENCH SAFETY:
STATE LAW REQUIRES THAT THE CONTRACTOR PROVIDE A TRENCH SAFETY PLAN (TRENCH SHORING), PREPARED BY A PROFESSIONAL ENGINEER, FOR UTILITY TRENCHES IF A DEPTH GREATER THAN FIVE (5) FEET. THE CONTRACTOR SHALL OBTAIN THE TRENCH SAFETY PLAN FROM THE CITY ENGINEER, WATER UTILITIES DEPT. PRIOR TO THE START OF CONSTRUCTION.

CONTRACTOR SHALL HAVE ALL UNDERGROUND UTILITIES FLAGGED FOR EXCAVATION.

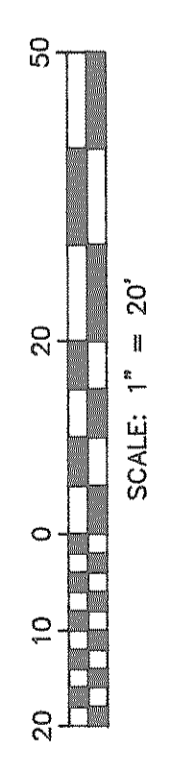

BENCHMARK:
Top of headwall of the 3'X 2' box culvert at the Northeast corner of F.M. Road 740 and F.M. Road 3097. ELEV. 568.07 M.S.L.

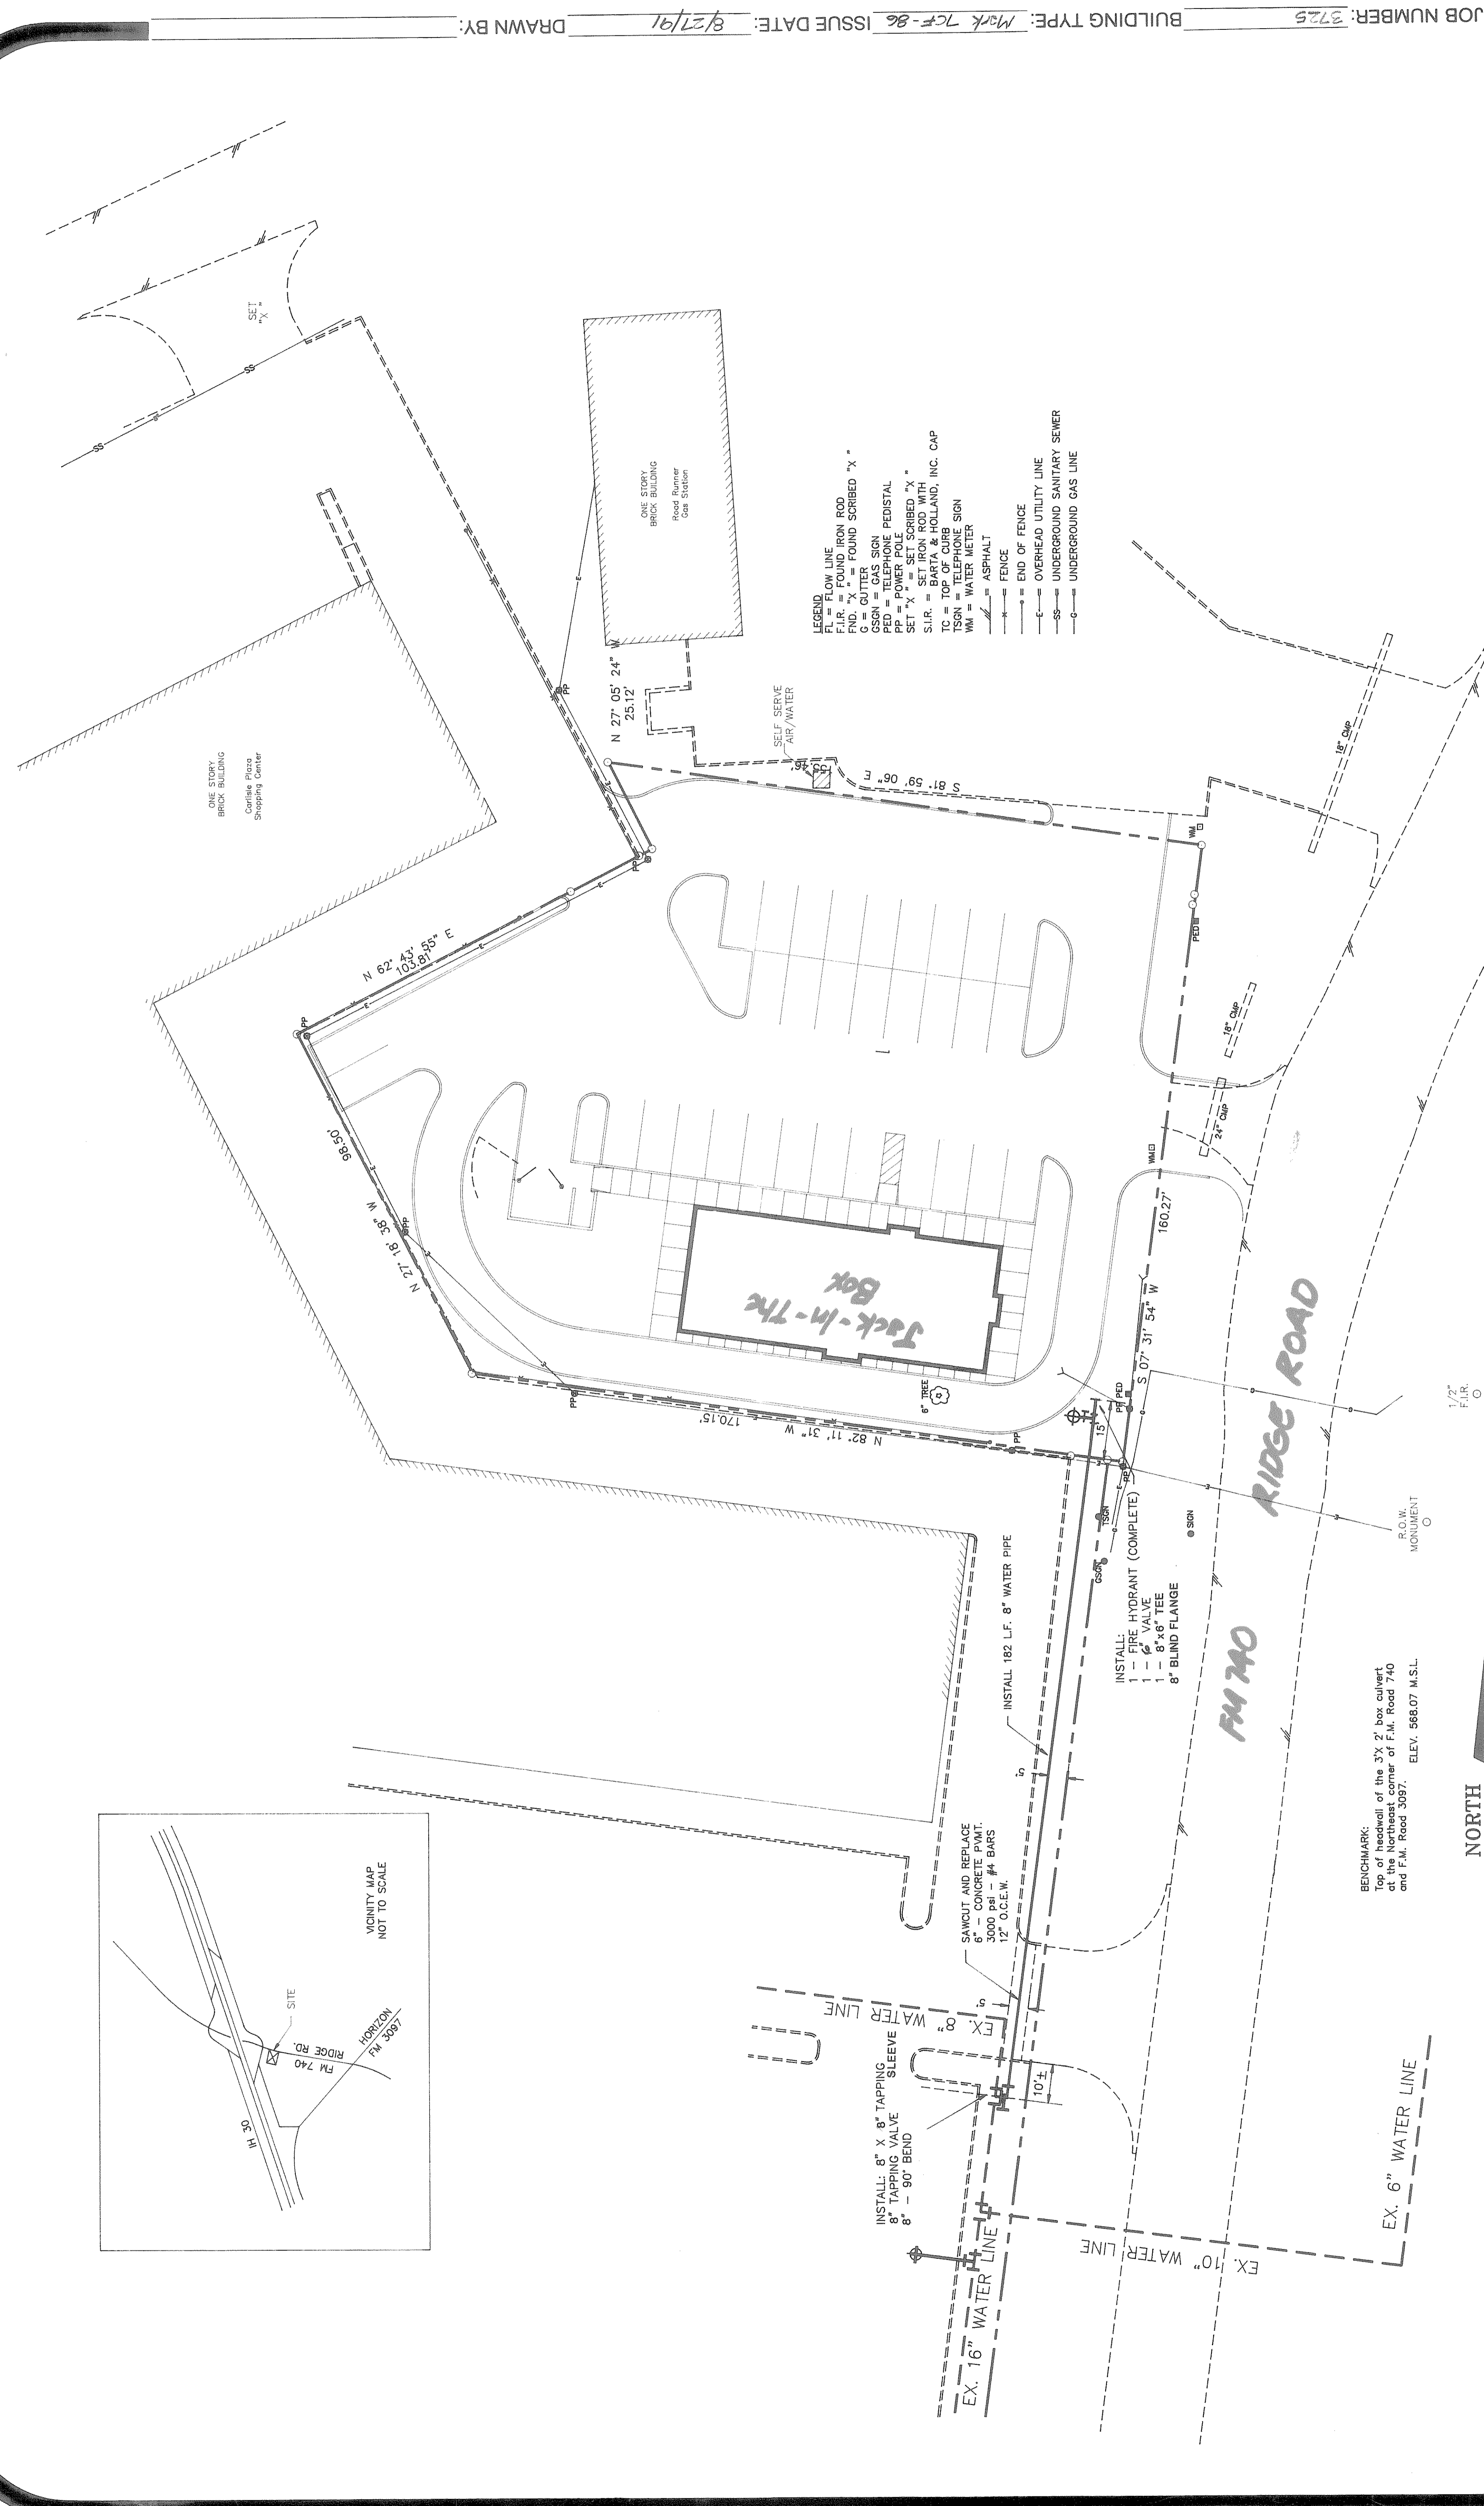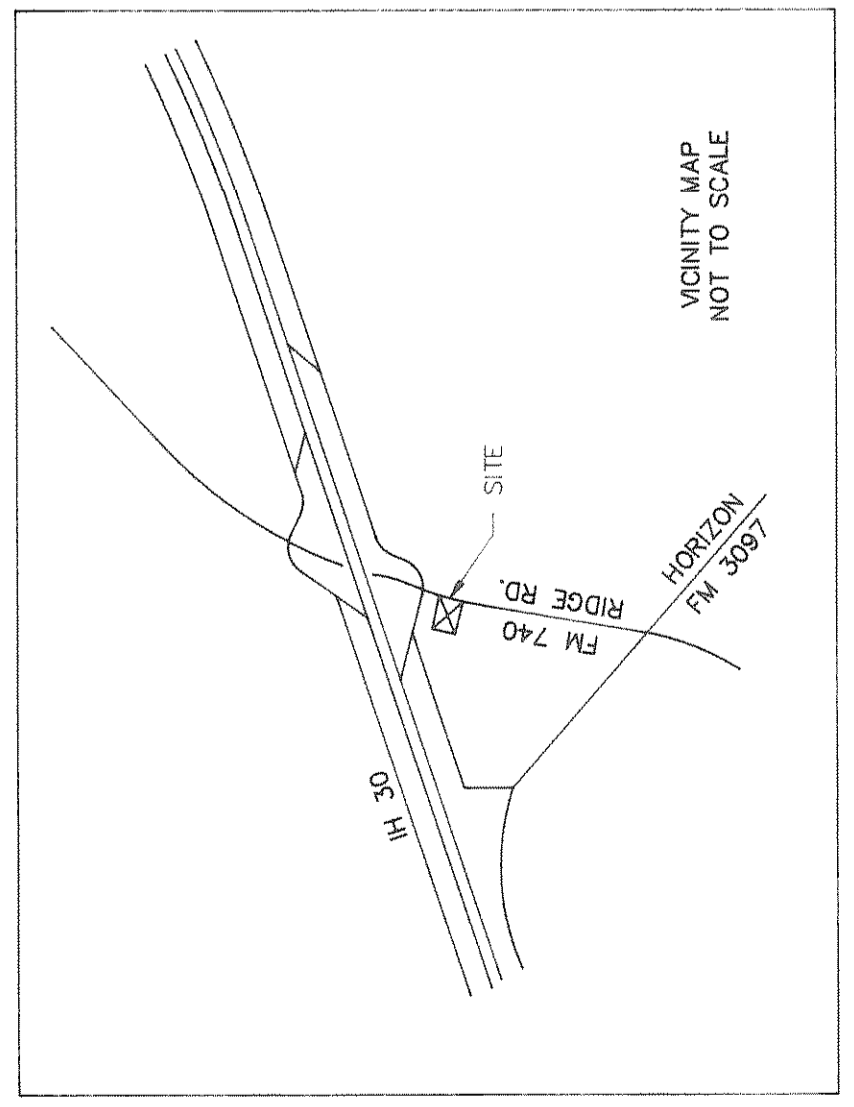

- LEGEND**
- FL = FLOW LINE
 - F.I.R. = FOUND IRON ROD
 - F.N.D. = FOUND NAIL
 - CUTTER = FOUND SCRIBED "X"
 - G.S.N. = GAS SIGN
 - PED = TELEPHONE PEDISTAL
 - PP = POWER POLE
 - SET "X" = SET SCRIBED "X"
 - S.I.R. = SET SCRIBED "I"
 - T.C. = TOP OF CURB
 - T.S.N. = TELEPHONE SIGN
 - WM = WATER METER
 - ASPHALT
 - FENCE
 - END OF FENCE
 - OVERHEAD UTILITY LINE
 - UNDERGROUND SANITARY SEWER
 - UNDERGROUND GAS LINE

REVISIONS:

NO.	DATE	DESCRIPTION
1	8/20/91	PERMIT REV.

FOODMAKER, INC.
SAN DIEGO, CA 92123
9330 BALBOA AVENUE

Moyle & Associates Architects Inc.
14850 Quorum Drive Suite 204
Dallas, Texas 75240
Phone (214) 386-0338

JOB NUMBER: 3725 BUILDING TYPE: Mark TCF-86 ISSUE DATE: 8/27/91 DRAWN BY: