


F.M. ROAD No. 740



AS-BUILT

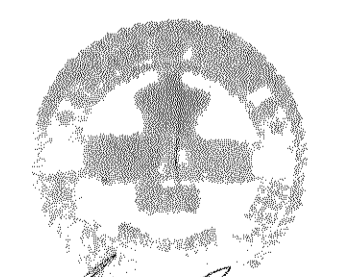

7-20-08

REVISION DESCRIPTION		DATE	SCALE	DESIGN	DRAWN	HAROLD L. EVANS & ASSOCIATES Consulting Engineers P.O. Box 28355 2331 Gus Thomasson Road, Suite 102 Dallas, Texas 75228 (214) 328-8133	SHEET NO. GRADING PLAN Foxchase Phase One City of Rockwall Rockwall County, TEXAS	JOB NO. 87801
		7-21-08	1"=40'	H.L.E.	L.P.			