

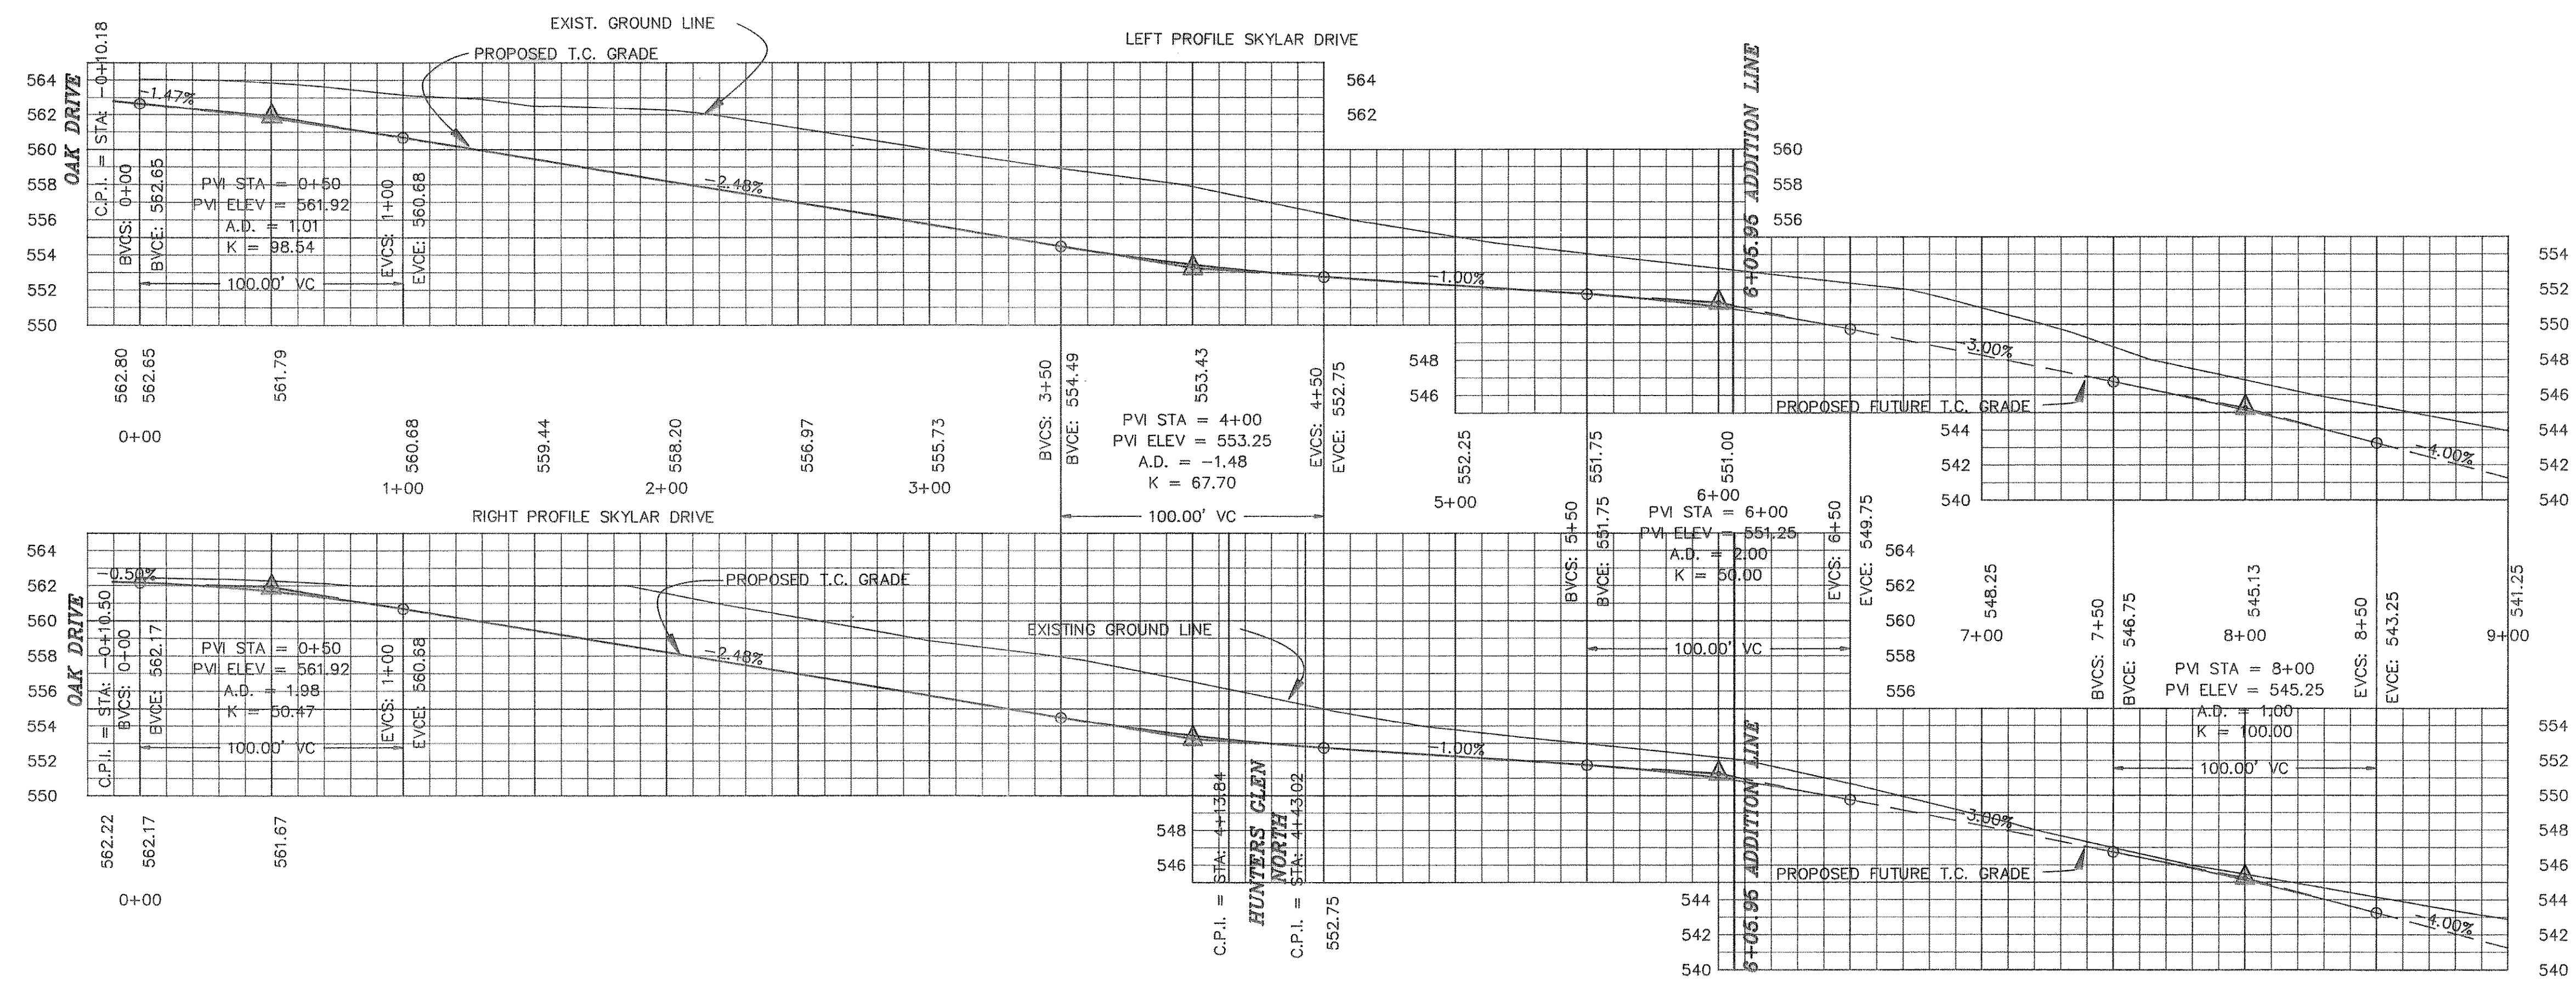


CURVE	RADIUS	LENGTH	TANGENT	CHORD	BEARING	DELTA
CRV # 1	300.00'	169.05'	86.84'	166.83'	N82°23'25"W	32°17'13"
CRV # 2	2589.27'	436.90'	218.97'	436.38'	N61°24'47"W	09°40'04"

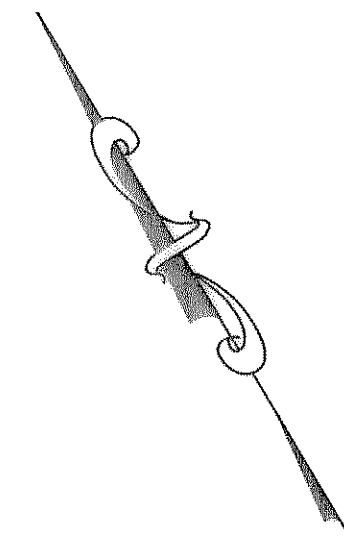

B.M.
TOP OF EXISTING SANITARY SEWER MANHOLE
AT SANITARY STATION 0+00 LINE "A".
ELEVATION = 523.63

B.M.
TOP OF CURB ON THE SOUTH SIDE OF OAK DRIVE
OPPOSITE THE CORNER OF LOT 8 & LOT 9,
BLOCK A OF FOXCHASE ADDITION.
ELEVATION = 550.50

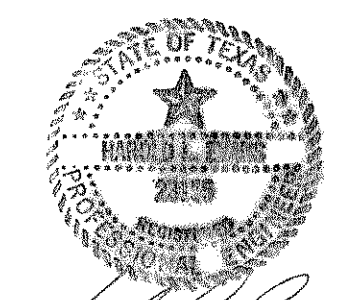

AS BUILT

HAROLD L. EVANS CONSULTING ENGINEER P.O. BOX 28355 2331 GUS THOMASSON ROAD, SUITE 102 DALLAS, TEXAS 75228. (214) 328-8133		PAVING PLAN SKYLAR DRIVE FOXCHASE PHASE 3 CITY OF ROCKWALL		SHEET NO. 3 / 10 JOB NO. 93121
REVISION DESCRIPTION 	DATE 6/29/94	SCALE HOR. 1" = 40' VERT. 1" = 6'	DESIGN H.L.E.	DRAWN K.E.B.