


CURVE	RADIUS	LENGTH	TANGENT	CHORD	BEARING	DELTA
CRV # 2	290.21'	217.74'	114.28'	212.67'	S12°57'37"W	42°59'17"
CRV # 4	39.50'	41.17'	22.68'	39.33'	S03°27'29"W	59°43'25"
CRV # 5	39.50'	41.17'	22.68'	39.33'	N82°19'38"E	59°43'25"
CRV # 6	45.00'	60.59'	35.89'	56.12'	S47°06'27"E	41°51'14"
CRV # 7	20.00'	14.61'	7.65'	14.29'	N12°23'35"E	77°08'49"
CRV # 8	20.00'	14.61'	7.65'	14.29'	S73°23'32"W	77°08'49"

B.M.
TOP OF EXISTING SANITARY SEWER MANHOLE
AT SANITARY STATION 0+00 LINE "A".
ELEVATION = 523.63

B.M.
TOP OF CURB ON THE SOUTH SIDE OF OAK DRIVE
OPPOSITE THE CORNER OF LOT B & LOT 9,
BLOCK A OF FOXCHASE ADDITION.
ELEVATION = 550.50

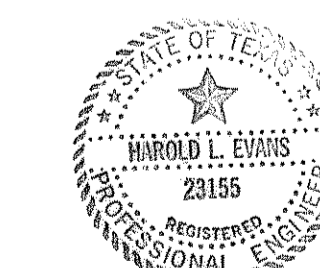

Harold L. Evans
6-94

AS BUILT

HAROLD L. EVANS CONSULTING ENGINEER P.O. BOX 28365 2331 CUS THOMASSON ROAD, SUITE 102 DALLAS, TEXAS 75228, (214) 328-8133		PAVING PLAN HUNTERS GLEN & HUNTERS GLEN NORTH FOX CHASE III CITY OF ROCKWALL		SHEET NO. 5 OF 10 JOB NO. 93121
REVISION DESCRIPTION 	DATE 6/20/94	SCALE HOR 1" = 40' VERT 1" = 6'	DESIGN H.L.E.	DRAWN K.E.B.