




CONSTRUCT 750 L.F. SILTATION FENCE ALONG PROPERTY LINE

CONSTRUCT 1060 L.F. SILTATION FENCE ALONG PROPERTY LINE

B.M.  
TOP OF EXISTING SANITARY SEWER MANHOLE  
AT SANITARY STATION 0+00 LINE "A".  
ELEVATION = 523.63

B.M.  
TOP OF CURB ON THE SOUTH SIDE OF OAK DRIVE  
OPPOSITE THE CORNER OF LOT 8 & LOT 9,  
BLOCK A OF FOXCHASE ADDITION.  
ELEVATION = 550.50

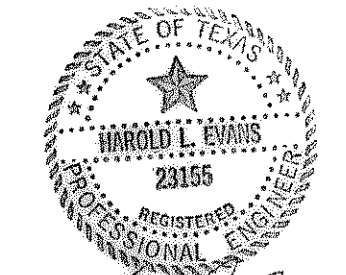

6-94

AS BUILT

				HAROLD L. EVANS CONSULTING ENGINEER P.O. BOX 28365 2331 GUS THOMASSON ROAD, SUITE 102 DALLAS, TEXAS 75228. (214) 328-8133		SHEET NO. 10 10	
REVISION DESCRIPTION				DATE 6/1/94	SCALE 1" = 40'	DESIGN H.L.E.	DRAWN K.E.B.
GRADING PLAN						FOXCHASE III CITY OF ROCKWALL	
JOB NO.						9312	