




DRAINAGE TABLE

DRAINAGE AREA NO.	ACRES	T.C.	C	I 100 YR.	Q 100 YR.	SUM Q 100 YR.
1	4.65	10	0.5	9.8	22.78	22.78
BENTON WOODS	6.44	"	"	"	31.56	
2	2.71	"	"	"	13.28	67.62
3	1.13	"	"	"	5.54	
4	3.21	"	"	"	15.73	
5	0.48	"	"	"	2.35	91.24
6	3.07	"	"	"	15.04	
7	2.40	"	"	"	11.76	
8	1.74	"	"	"	8.53	
9	0.56	"	"	"	2.74	
10	2.41	"	"	"	11.81	
11	1.52	"	"	"	7.45	
12	0.07	"	"	"	0.34	
13	0.81	"	"	"	3.97	

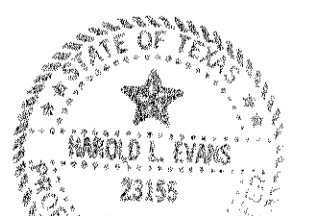

4-95

AS-BUILT

REV. PER 2ND. CITY REVIEW	3/15/95
REV. PER CITY REVIEW	2/9/95

HAROLD L. EVANS  
CONSULTING ENGINEER  
P.O. BOX 28955  
2331 GUS THOMASSON ROAD, SUITE 102  
DALLAS, TEXAS 75228, (214) 328-8133

REVISION DESCRIPTION	DATE	SCALE	DESIGN	DRAWN
	11/13/94	1" = 100'	H.L.E.	

DRAINAGE AREA MAP  
FOXCHASE PHASE FOUR

CITY OF ROCKWALL

SHEET NO.  
9

JOB NO.  
93121