
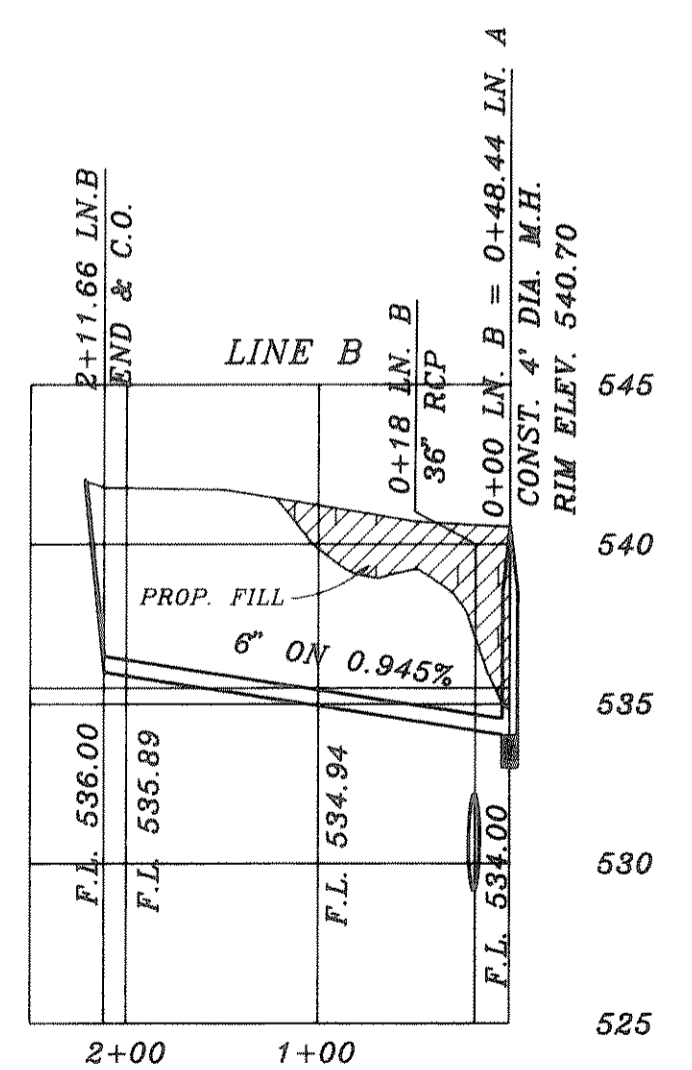
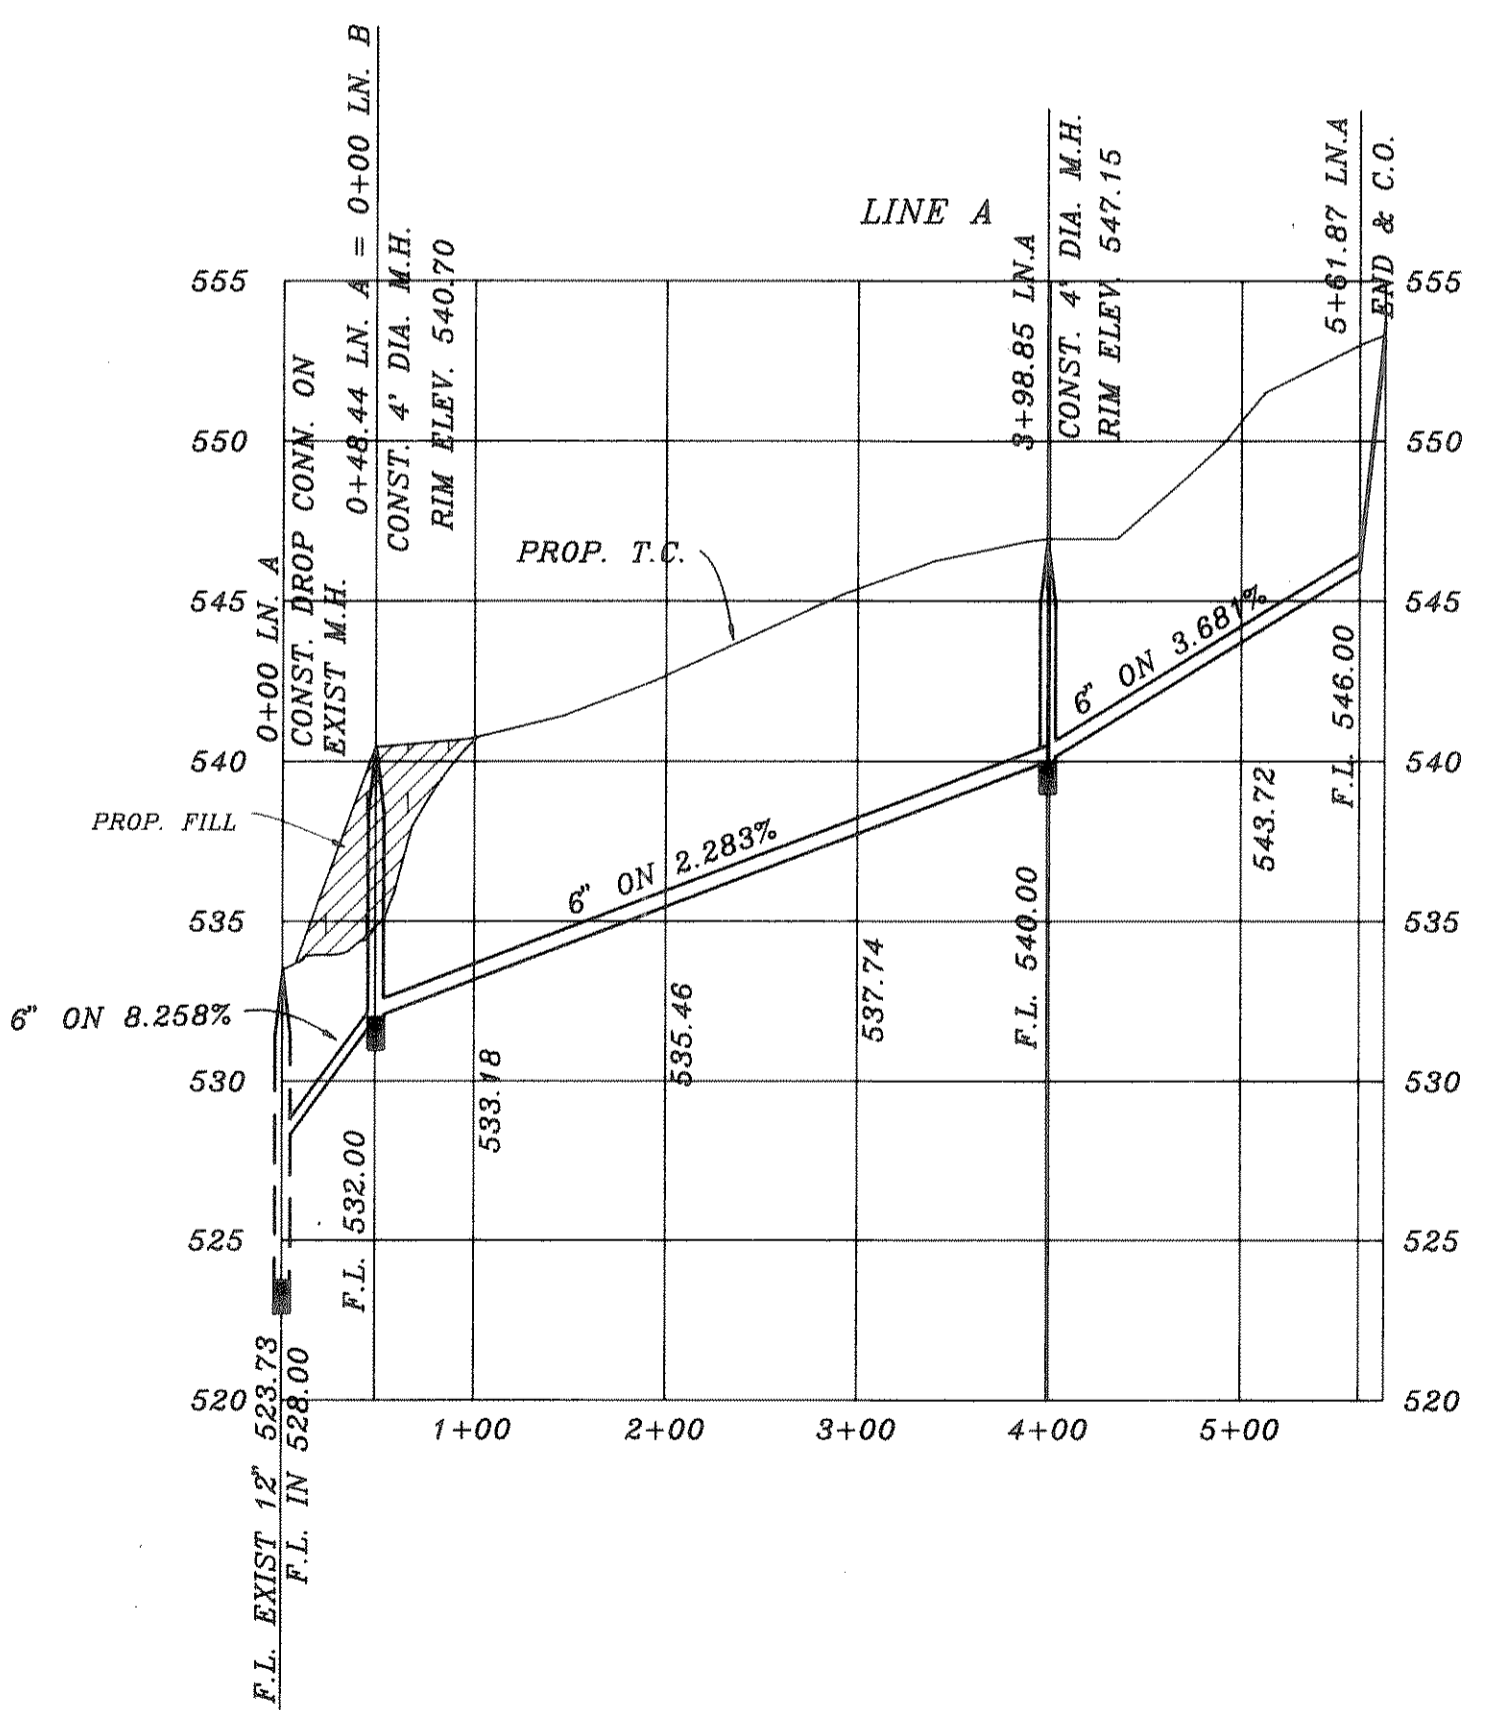
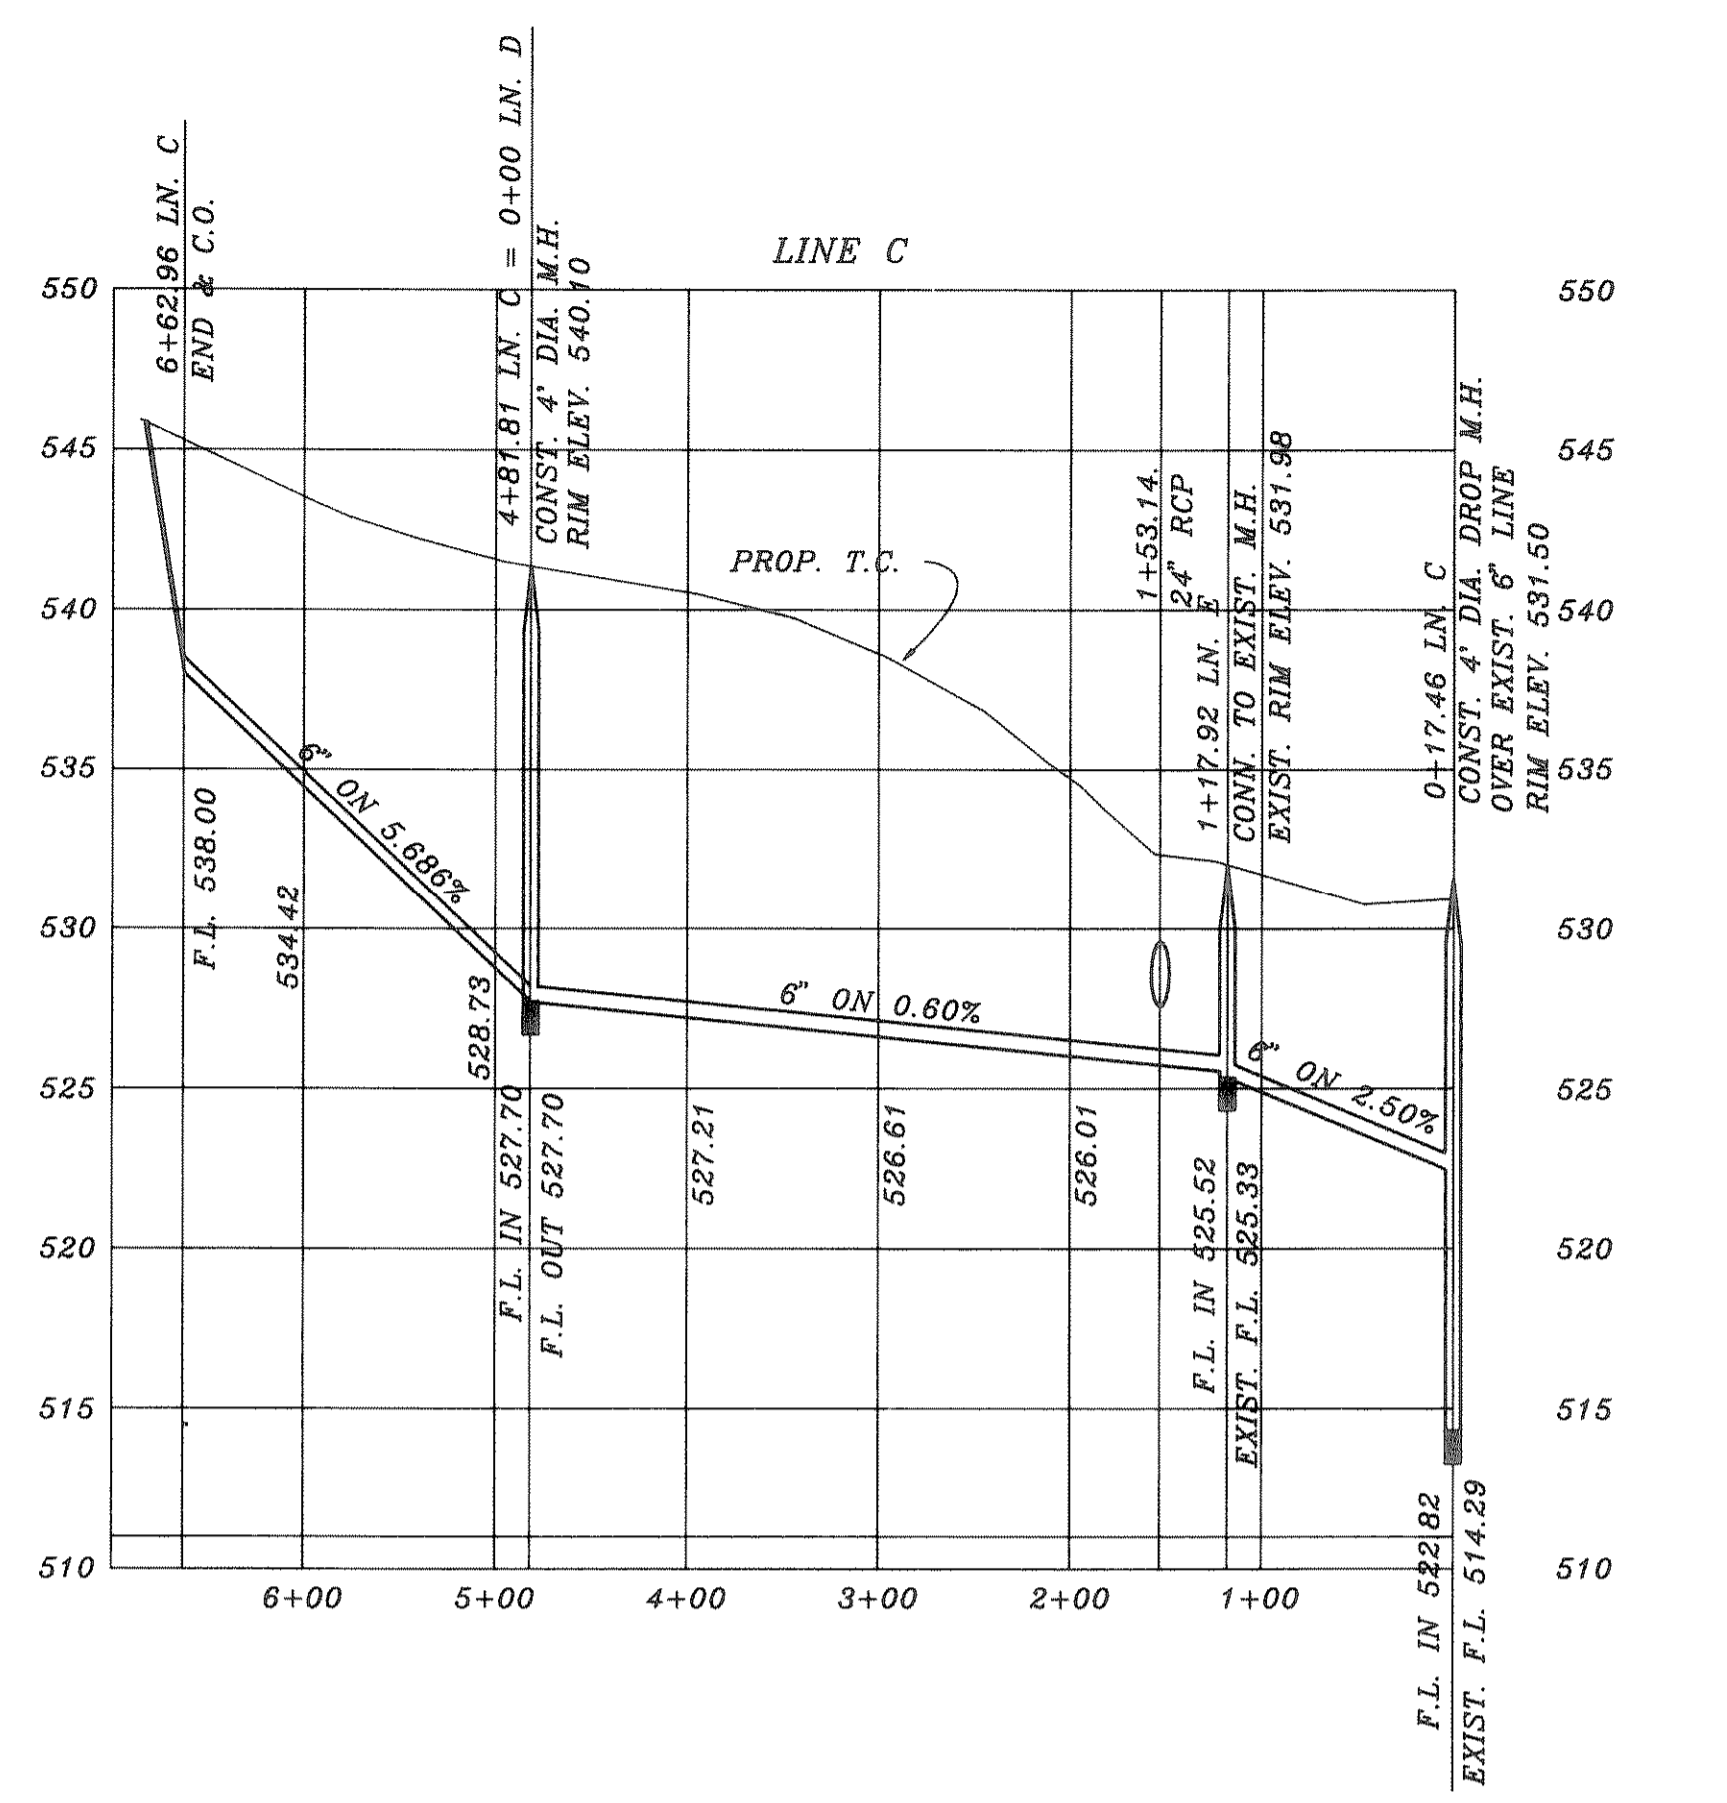
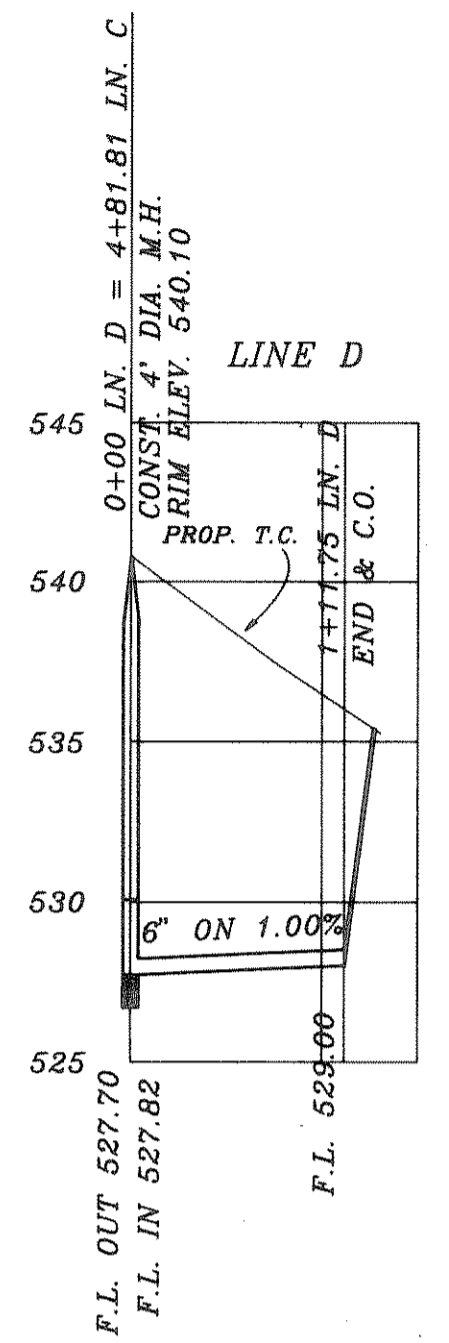


CURVE	RADIUS	LENGTH	TANGENT	CHORD	BEARING	DELTA
C1	731.91'	350.40'	178.63'	347.07'	S15°18'35" W	27°25'50"
C2	731.91'	20.90'	10.45'	20.90'	S00°46'35" W	01°38'10"
C3	150.00'	83.61'	42.92'	82.53'	S16°00'36" E	31°58'13"
C4	278.50'	64.39'	32.94'	64.25'	S69°48'15" E	13°14'48"
C5	150.00'	93.69'	48.43'	92.17'	S44°42'45" W	35°47'12"
C6	636.50'	47.29'	23.66'	47.28'	S65°18'34" E	04°15'26"
C7	371.50'	37.15'	18.59'	37.13'	N29°41'02" E	05°43'46"
C8	250.00'	96.59'	49.95'	97.96'	S15°31'15" W	22°35'45"

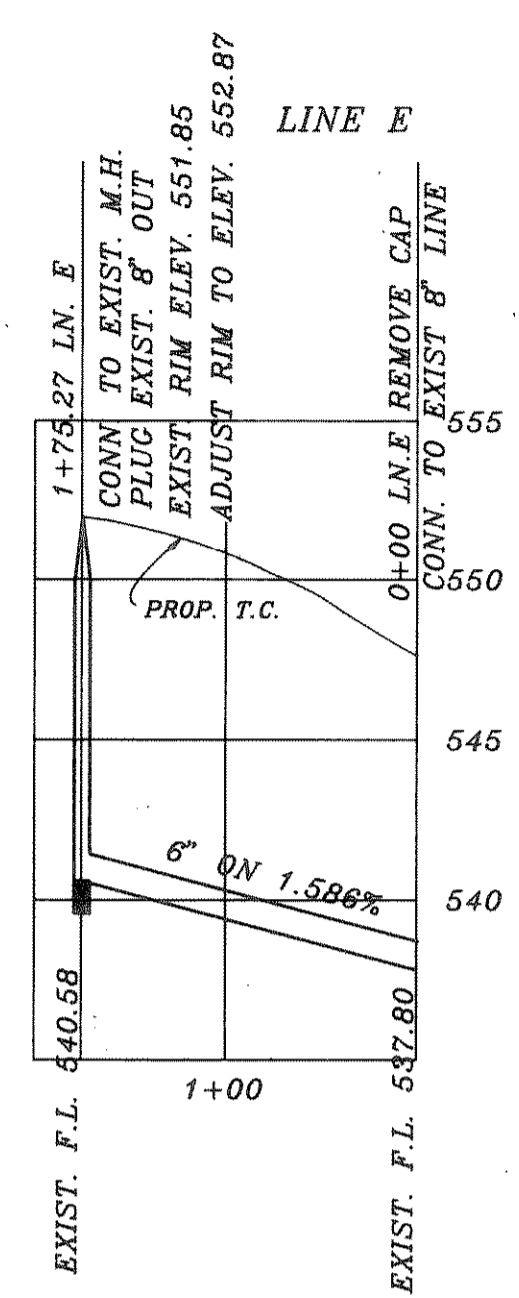

B.M.
TOP OF EXIST. M.H. AT STA. 14+03.
21.5' LT. ON OAK DRIVE
ELEVATION = 531.98

B.M.
TOP OF EXIST. M.H. AT STA. 16+05.
40' RT. ON SHADY DALE LANE
ELEVATION = 551.85

FOX4WSS HAROLD L. EVANS CONSULTING ENGINEER P.O. BOX 28355 2331 CUS THOMASSON ROAD, SUITE 102 DALLAS, TEXAS 75228. (214) 328-8133		PROPOSED WATER & SANITARY SEWER SHEET NO. 11	
REVISION DESCRIPTION DATE 11/14/94		SCALE 1" = 100' 1" = 6'	
DESIGN H.L.E.		DRAWN H.L.E.	
CITY OF ROCKWALL		JOB NO. 93121	



AS-BUILT
 4-95