


NOTE:
 ELEVATIONS SHOWN AT FRONT LOT CORNERS ARE 0.2' ABOVE T.C. GRADE.
 ELEVATIONS SHOWN AT BACK LOT CORNERS ARE 0.4' ABOVE ALLEY INVERT GRADE.

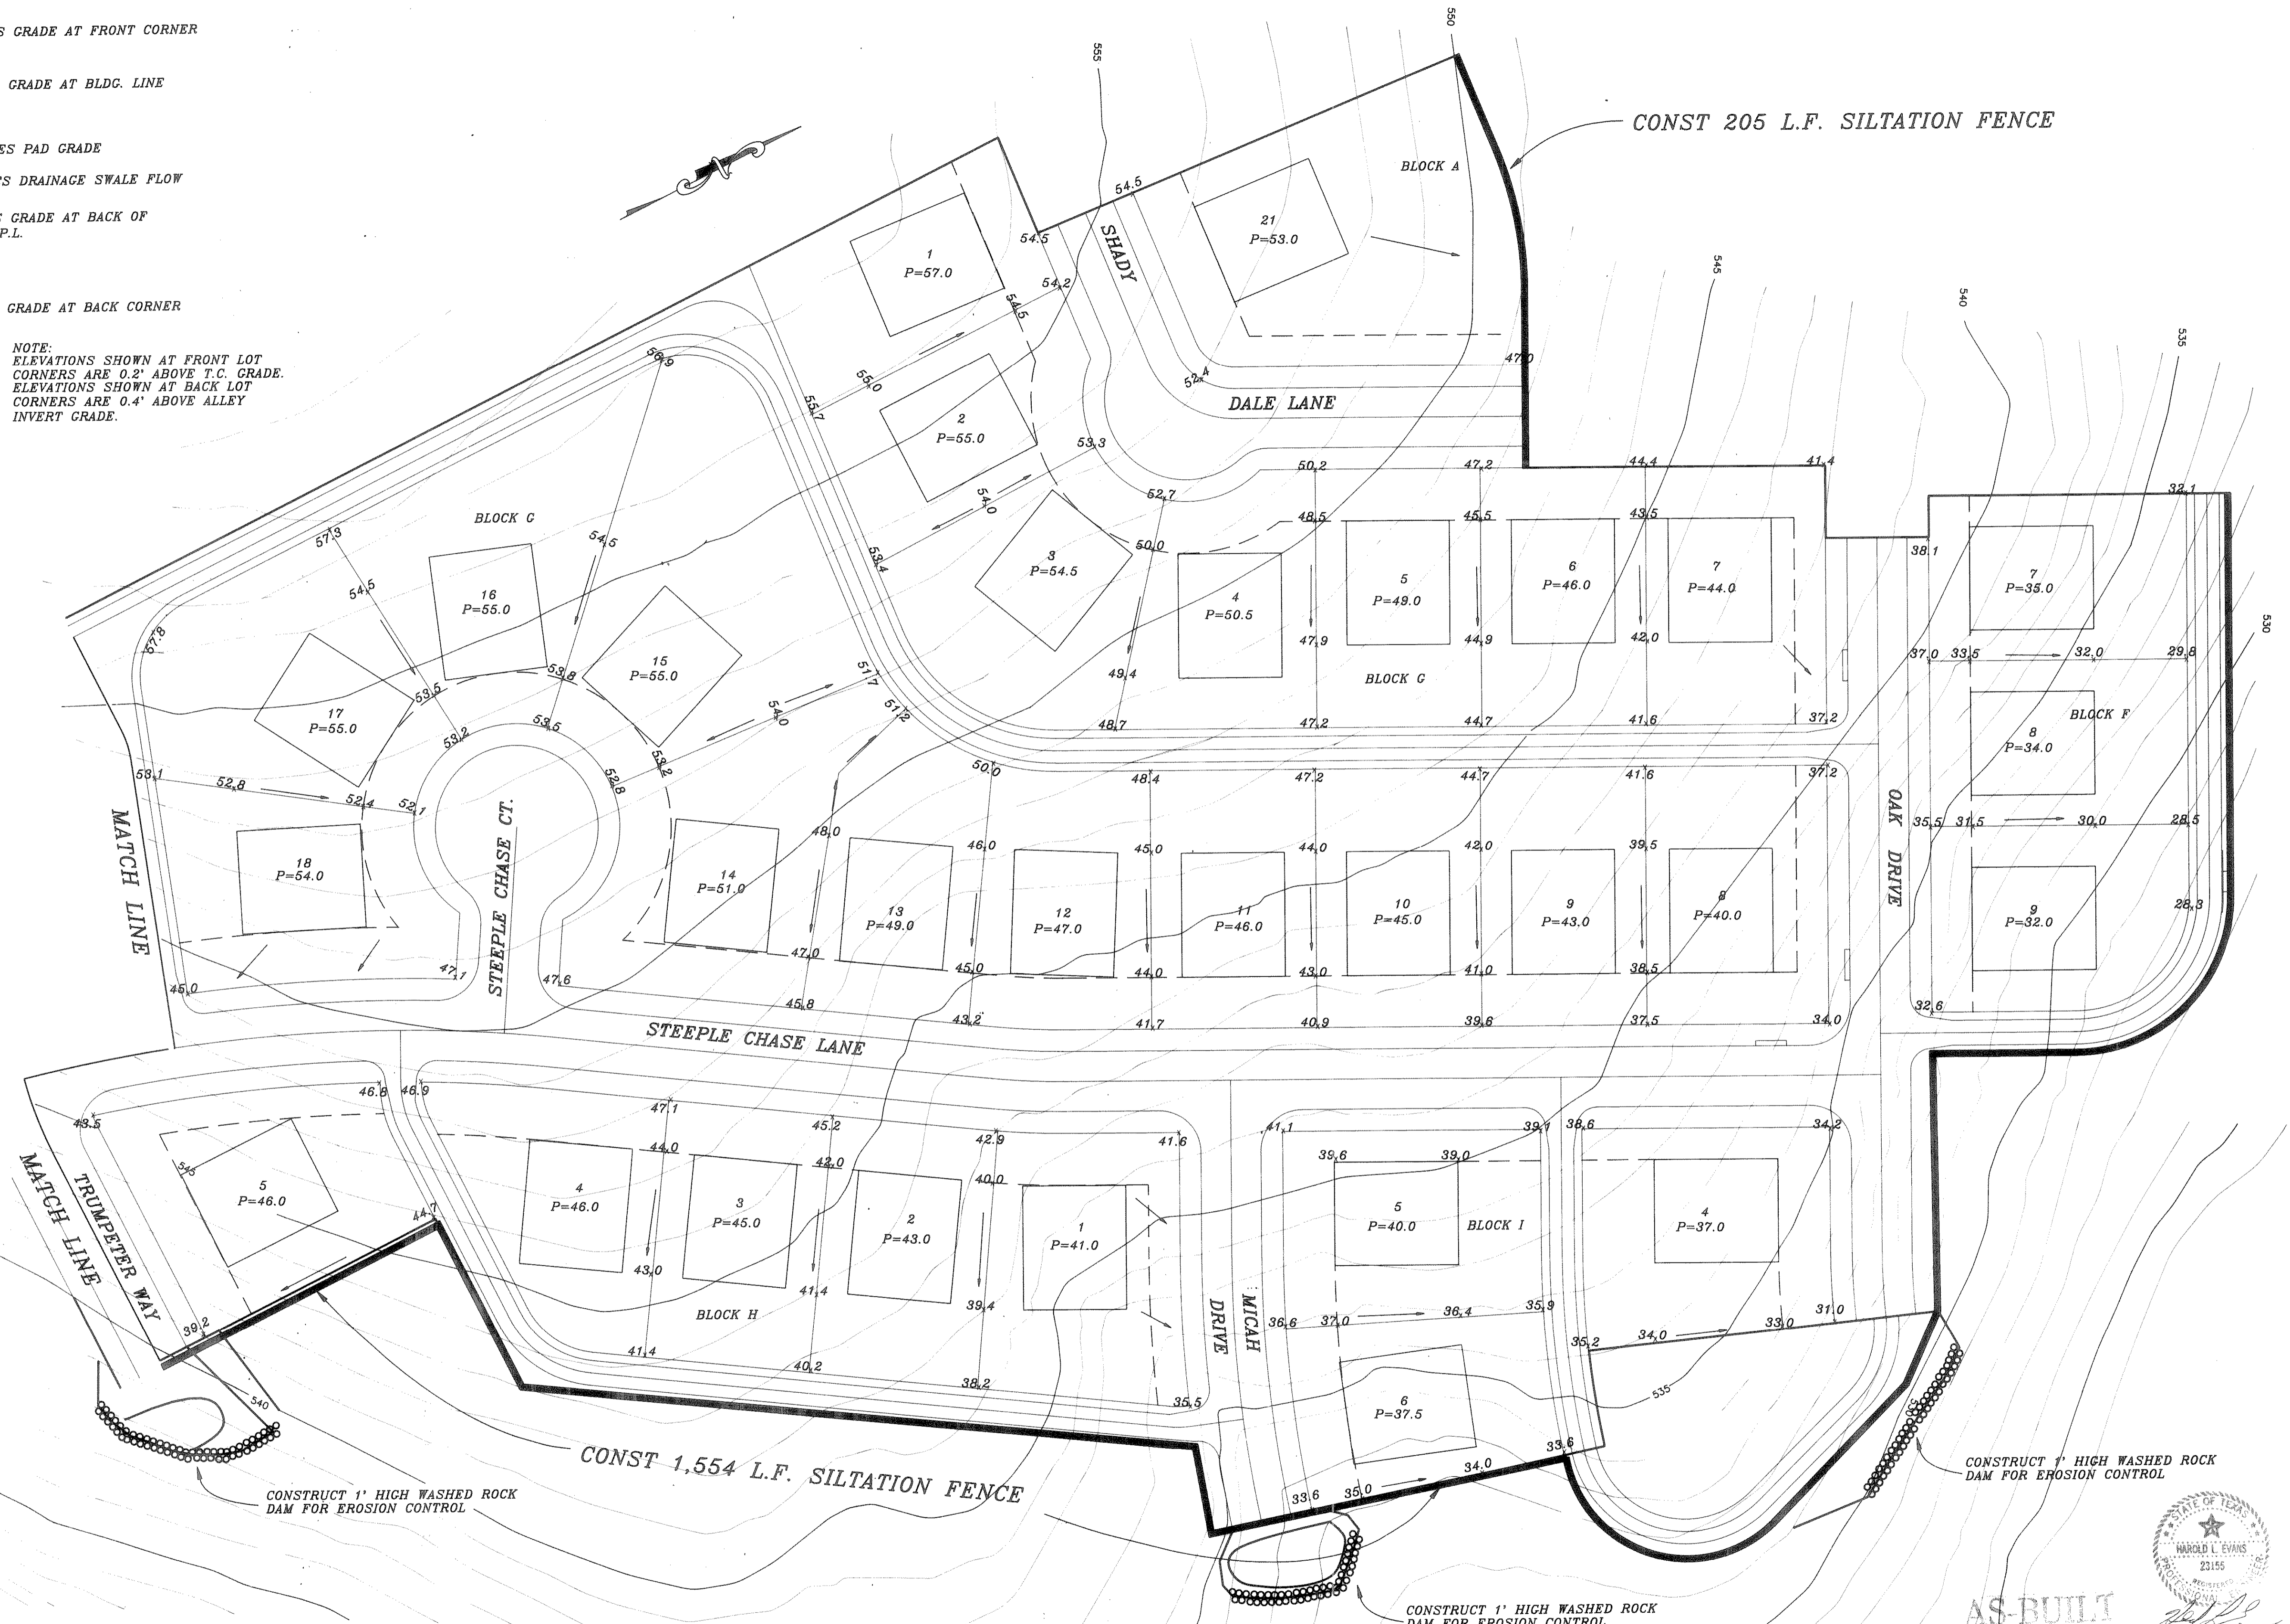

B.M.
 TOP OF EXIST. M.H. AT STA. 14+03,
 21.5' LT. ON OAK DRIVE
 ELEVATION = 531.98

B.M.
 TOP OF EXIST. M.H. AT STA. 16+05,
 40' RT. ON SHADY DALE LANE
 ELEVATION = 551.85

REV. PER CITY REVIEW	DATE	SCALE	DESIGN	DRAWN
	2/11/95	1" = 40'	H.L.E.	
	11/21/94			

FOXGRD


HAROLD L. EVANS
 CONSULTING ENGINEER
 P.O. BOX 28355
 2331 GUS THOMASSON ROAD, SUITE 102
 DALLAS, TEXAS 75228. (214) 328-8133

LOT GRADING PLAN
 FOXCHASE PHASE FOUR

CITY OF ROCKWALL

SHEET NO.
 12 / 13

JOB NO.
 93121

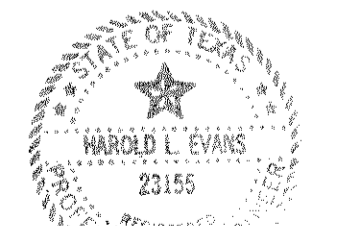

AS-BUILT
 4-95