


B.M.
CITY OF ROCKWALL BRASS DISK ON N.E. CORNER OF 20' INLET ON WEST SIDE STEEPLE CHASE LANE, 1.040' +/- SOUTH OF THE INTERSECTION OF STEEPLE CHASE LANE AND OAK DRIVE.
ELEV.: 540.50

B.M.
CITY OF ROCKWALL BRASS DISK ON N.W. CORNER OF 20' INLET ON WEST SIDE SKYLAR DRIVE, 75' +/- NORTH OF THE INTERSECTION OF SKYLAR DRIVE AND HUNTERS GLEN.
ELEV.: 532.63

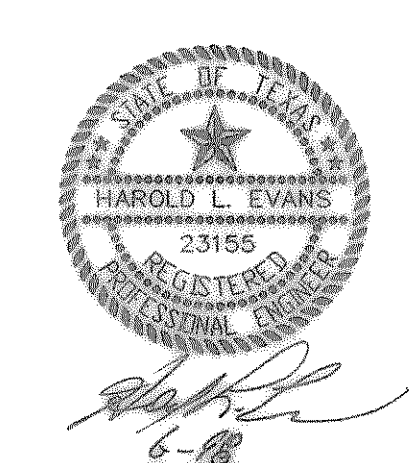

HAROLD L. EVANS CONSULTING ENGINEER P.O. BOX 20355 2331 GUS THOMASSON ROAD, SUITE 102 DALLAS, TEXAS 75228, (214) 328-8133		FUTURE PAVING SUMMER LEE DRIVE FOXCHASE PHASE 5 CITY OF ROCKWALL	SHEET NO. 7		
REV. PER 4th. CITY REVIEW REV. PER 2 ND. CITY REVIEW REV. PER CITY REVIEW	DATE 10/10/97		SCALE 1" = 40' 1" = 8"	DESIGN H.L.E.	DRAWN